

Meeting Minutes

Project Name: Wood Residence

Date of Meeting: 6/5/2026

Time: 2pm-3:30pm

Location: Site

Attendees: Brandon from Royalty Roofing, Phil & Michelle Wood, Madisyn van den Boogaart

- **Roofing**

- Discussed thoroughly the Brava and DaVinci again, and area leaning towards Brava
 - Michelle feels DaVinci doesn't look as authentic and doesn't like the colors as much
 - Stuck between Brava Arendale, or Brava Weathered
 - Mad will have design team put photos together with each roof color on their house at different times of day

- **Primary Wardrobe** – see attached markups and notes on the shop drawing

- Overall, they aren't wowed by the layout or design and want more
 - Mad said we could reach out for another opinion or really lay down the expectations with eurowood

- **Primary Bath**

- Discussed the tub and how they want to get one without the handles if possible
- Discussed the tub deck and how we show cabinets on both sides, fixed panels in the middle – Michelle does want at least one functional cabinet and that one would be on the vanity side; the rest can be fixed or removable panels for access; also, functional cabinet to have touch latch so no visible hardware is needed
- Look at custom lit mirrors from Modern Mirrors for their primary bathroom
- They are in the process of finding tile but the one they like has an unknown shipping date so they might have to go back to the drawing board

- **Primary Vestibule**

- Move smoke towards corner if possible
- Change can light to a decorative fixture

- **Servery**




- Change outlets to plugmould at underside of the two uppers – not full length if possible
- Move the keypad over so it doesn't run into the casing

- **Hearth Room**

- Phil and Michelle approved moving forward with redoing the hearth room cabinets per the \$20k number that was emailed – move forward with demo
- Discussed how doors would look and ended up going away from them after explaining that you'd see 6" of wood in the middle because that was the size of the door frame stile (3" x2)

- **Pantry**


- Change the 2 can lights into a single decorative fixture centered on the walk space – Michelle wants a chandelier

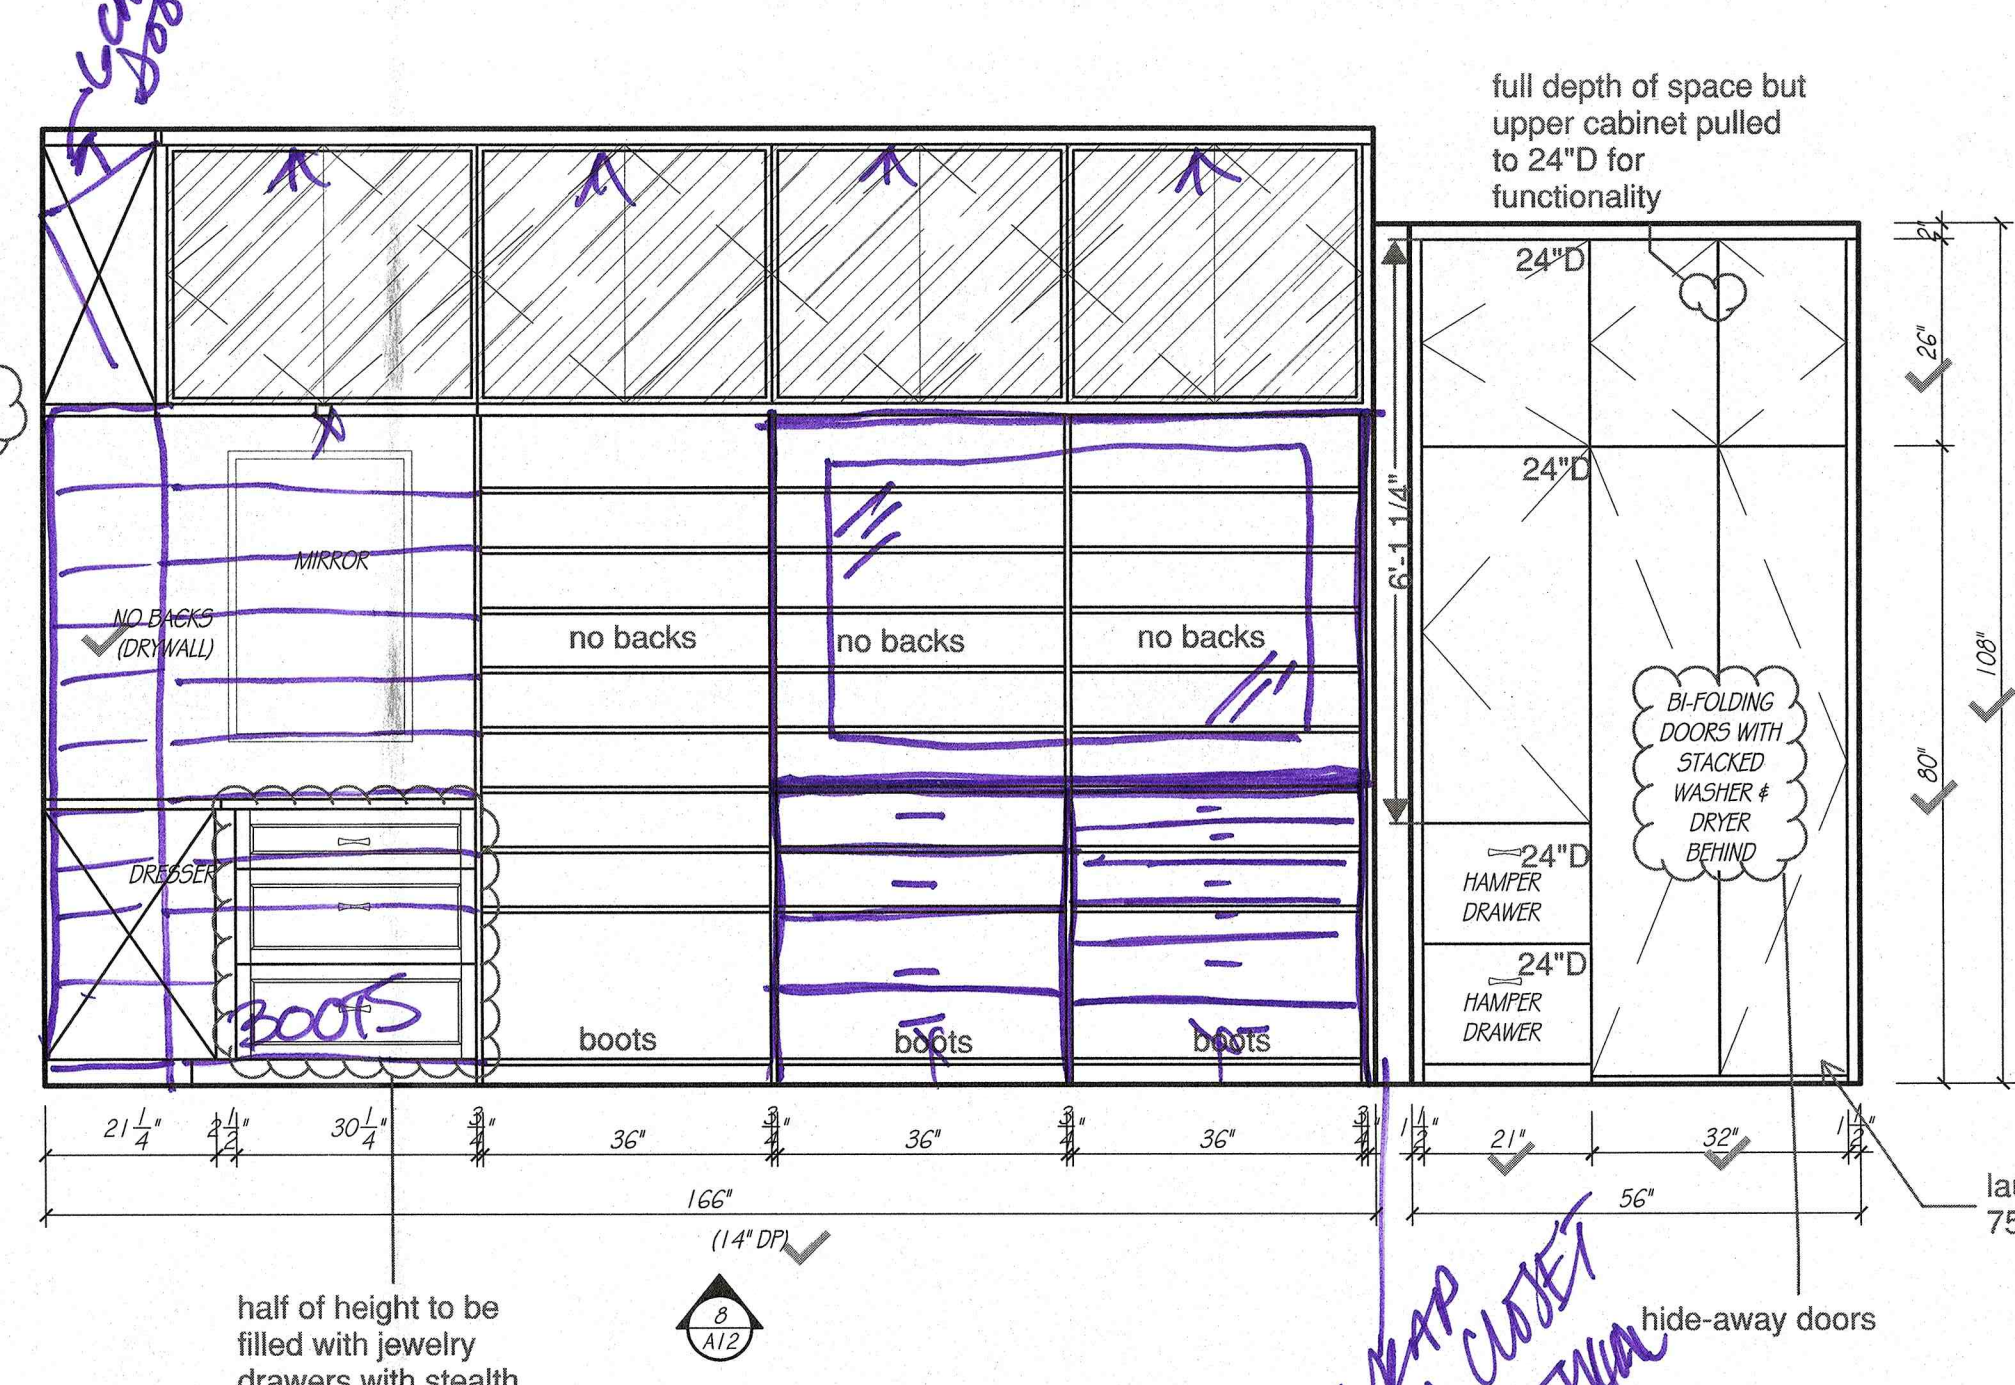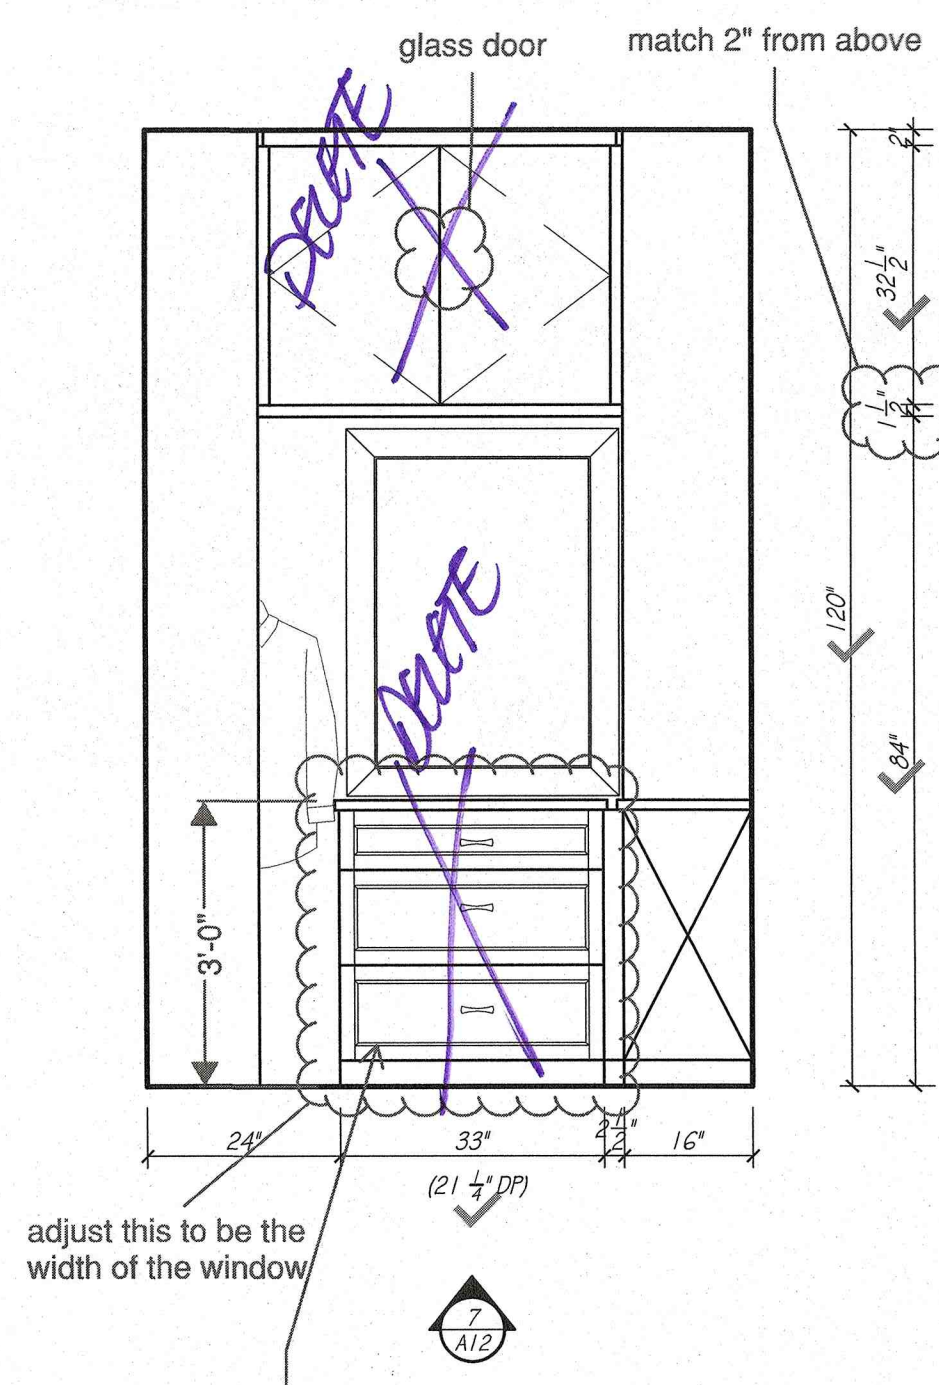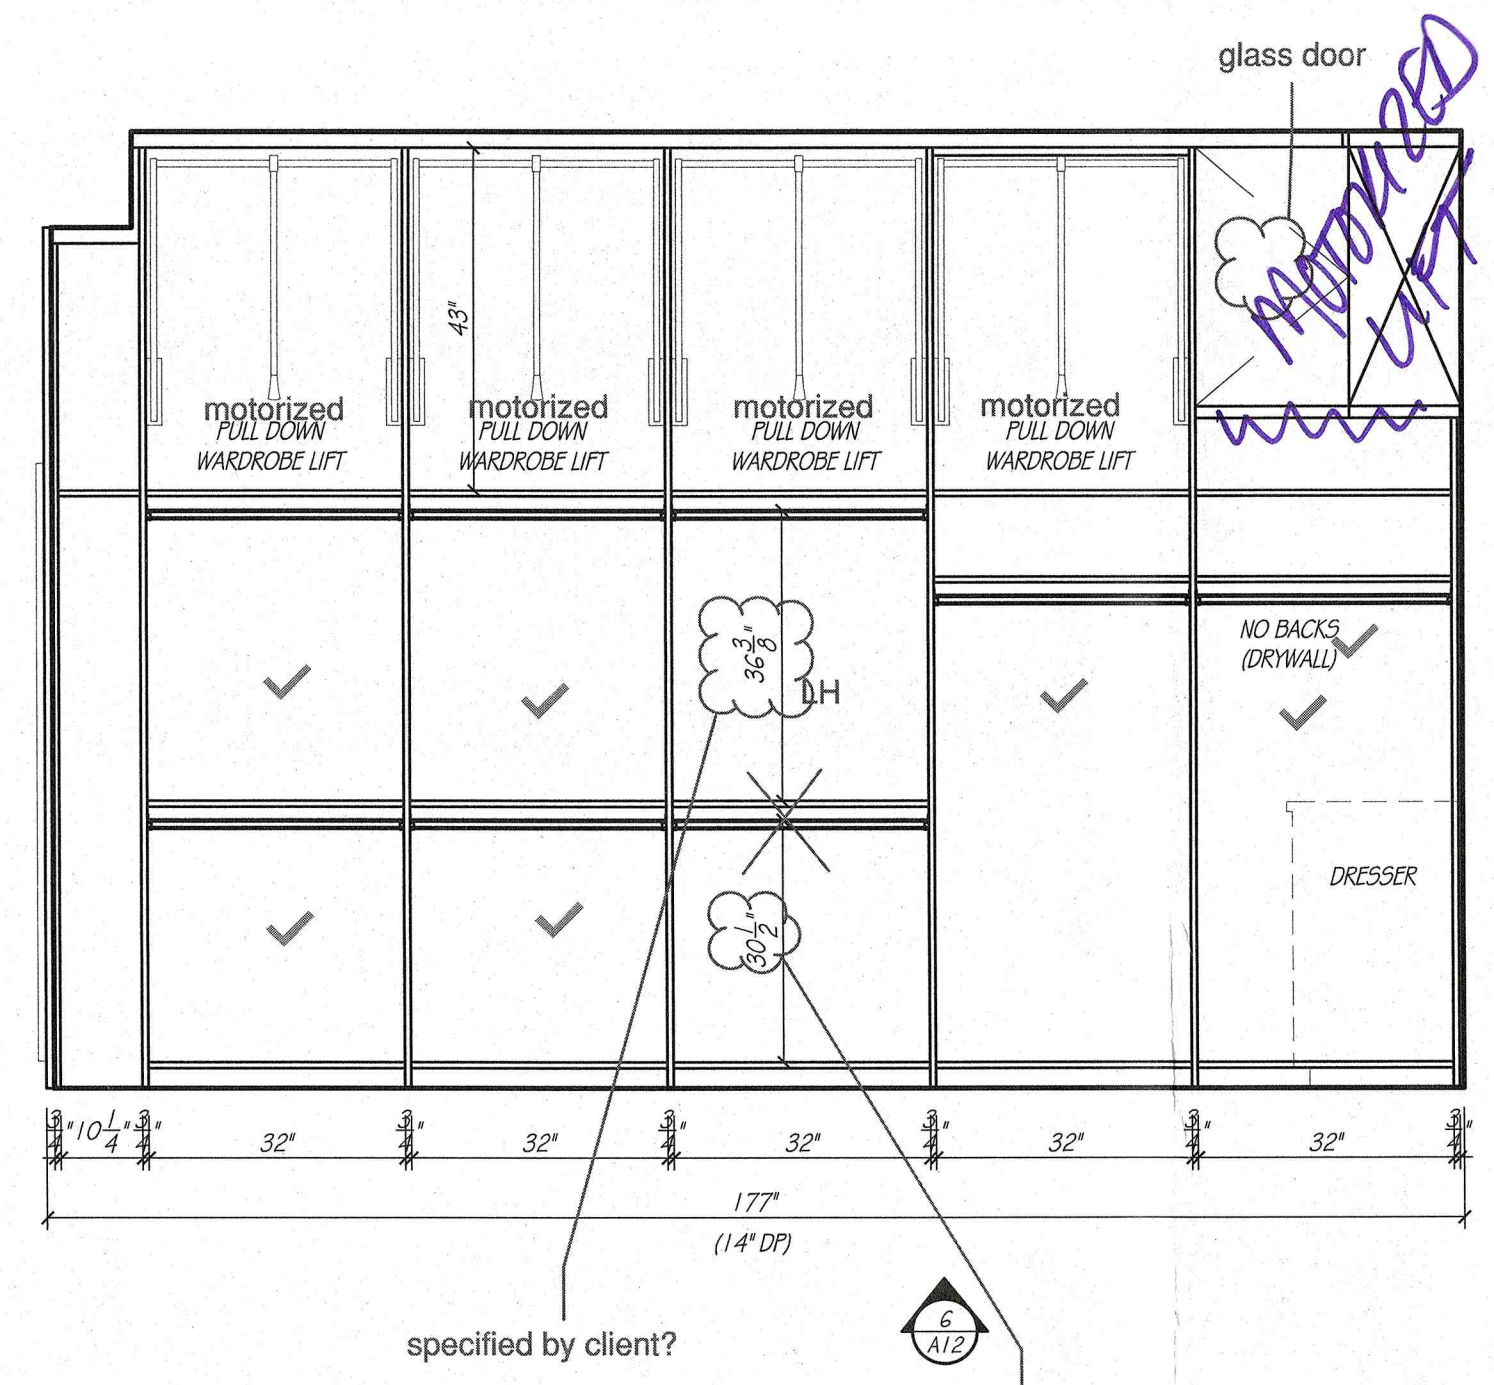

PRIMARY WARDROBE	
CABINET CONSTRUCTION:	
EXTERIORS	WHITE MELAMINE
INTERIORS	WHITE MELAMINE
FACE BANDING	MATCHING PVC EDGE BANDING
CABINET HARDWARE & DRILLING	BY OTHERS
DRAWER SLIDE	FULL EXT. SOFT CLOSE CONCEALED SLIDES
COUNTERTOP SPECIFICATIONS:	
COUNTERTOP MATERIAL	QUARTZ
COUNTERTOP THICKNESS	1 1/4" ALLOWANCE
SUBTOP REQUIREMENTS	NONE
ROOM SPECIFICATIONS	
FLOORING - TYPE / ALLOWANCE	CARPET 5/8"
CASING W/ 1/4" REVEAL	3/4"

EUROWOOD Cabinets Inc.
 3415 SO. 67TH ST.
 OMAHA, NE 68106
 TEL (402-393-4110)
 FAX (402-393-8361)
 (WWW.EUROWOOD.NET)




SHEET: A12
 DRAWN BY: SJB
 PLAN: MAIN LEVEL
 PRIMARY WARDROBE
 REVISIONS: 1 JUNE 26

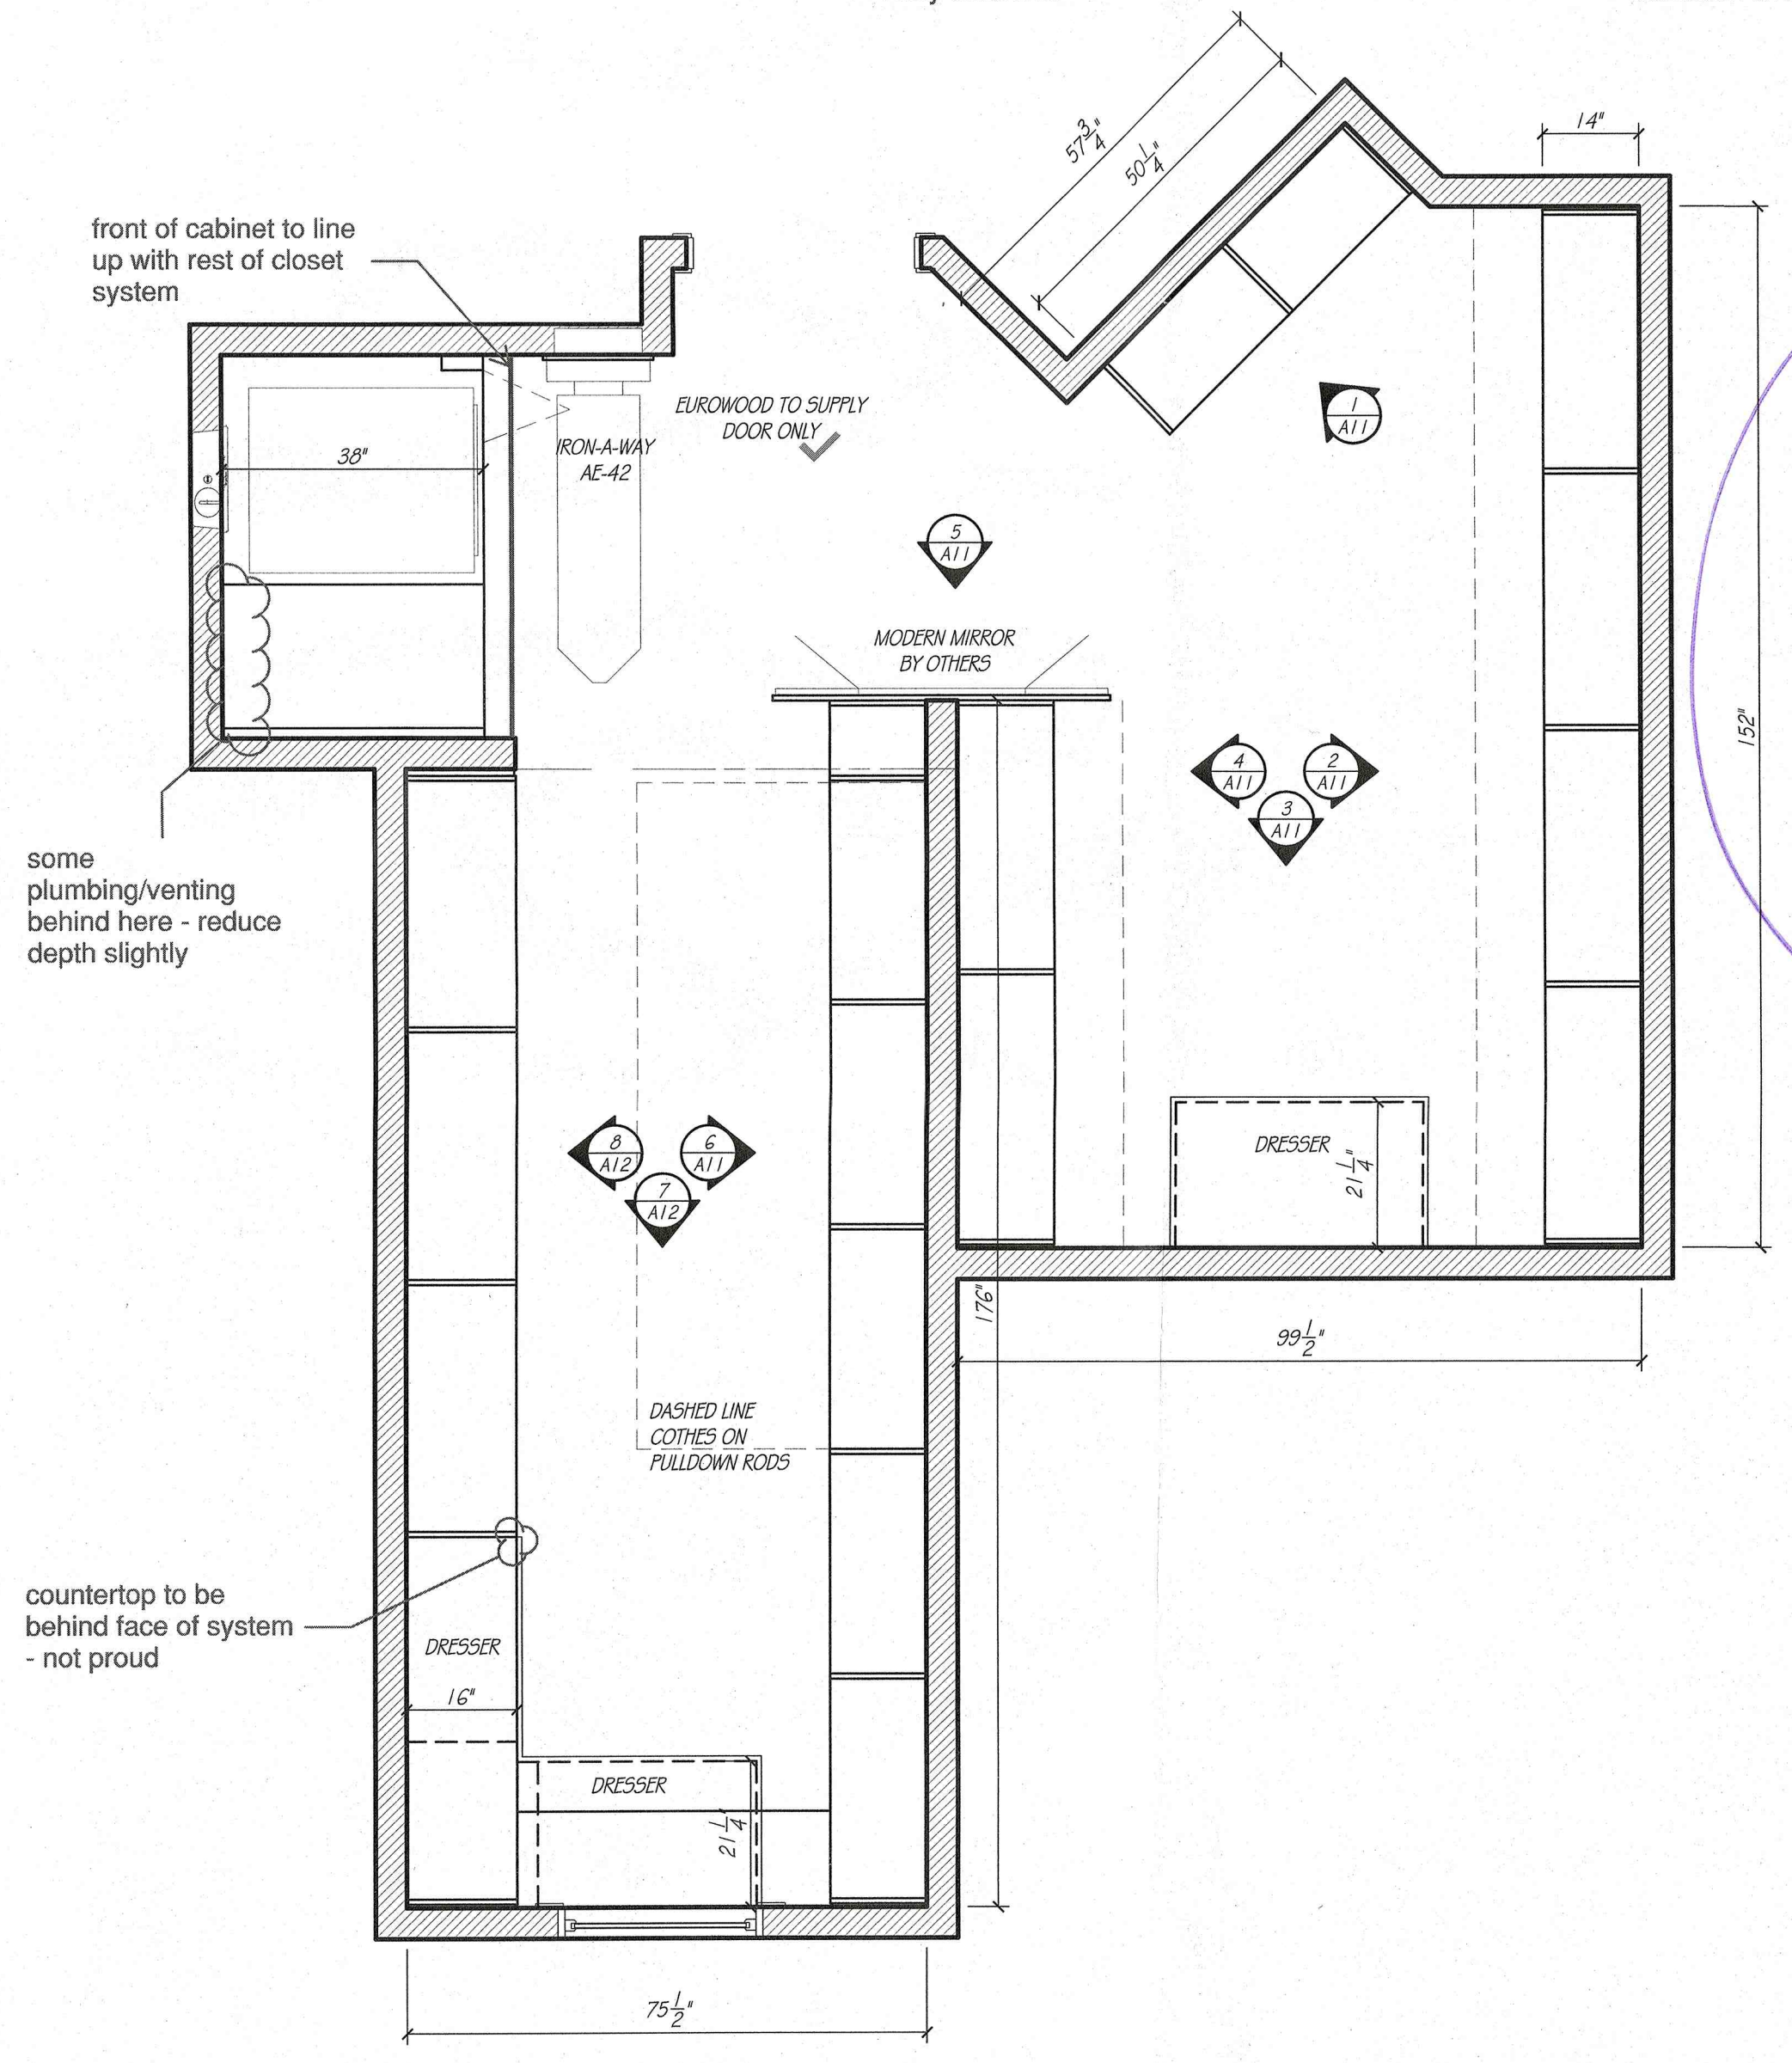

*TRANSFERRED
 SPECS
 ON MAIN
 CLOSET*

DRESSERS TO MATCH CABINERY FROM MASTER BATHROOM

*ADD WORKING
 UP SIDES OF
 RM SYSTEM*

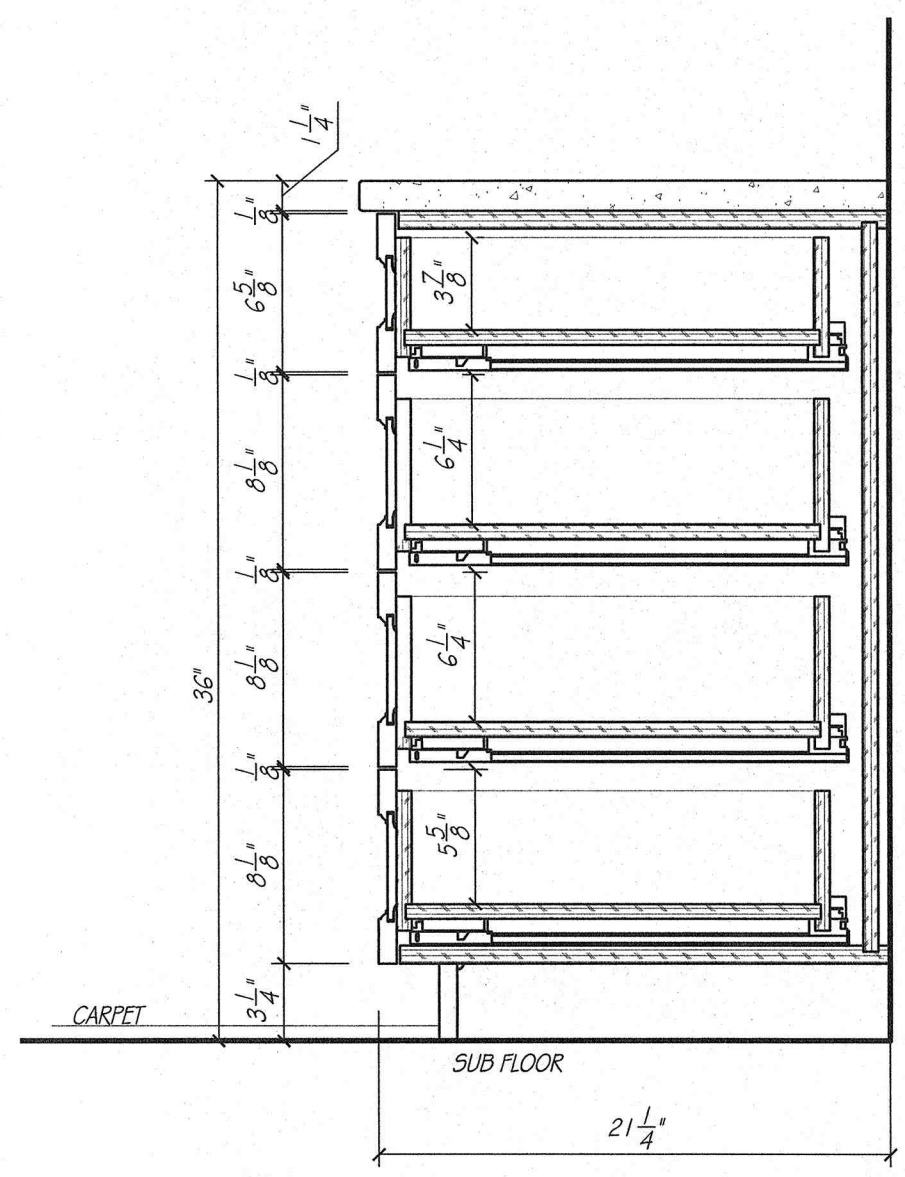
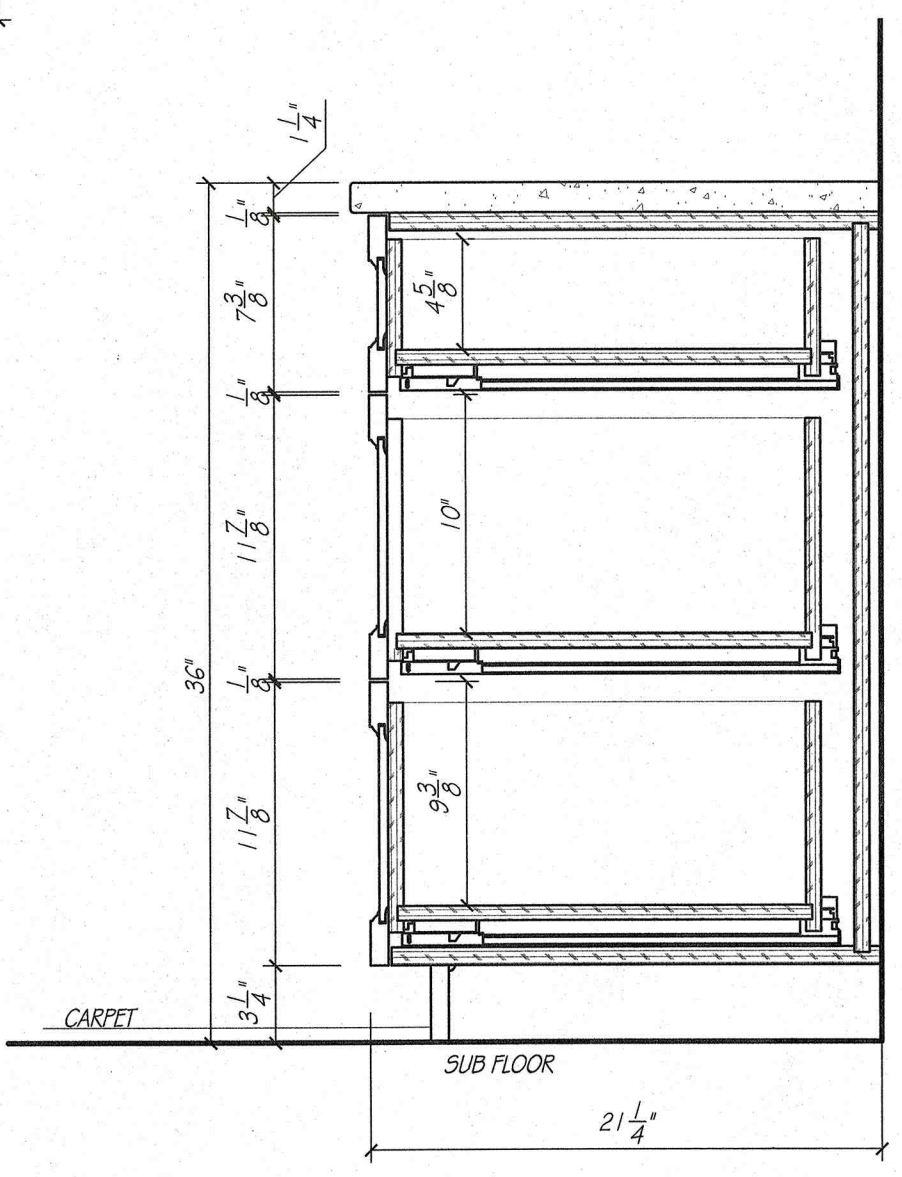
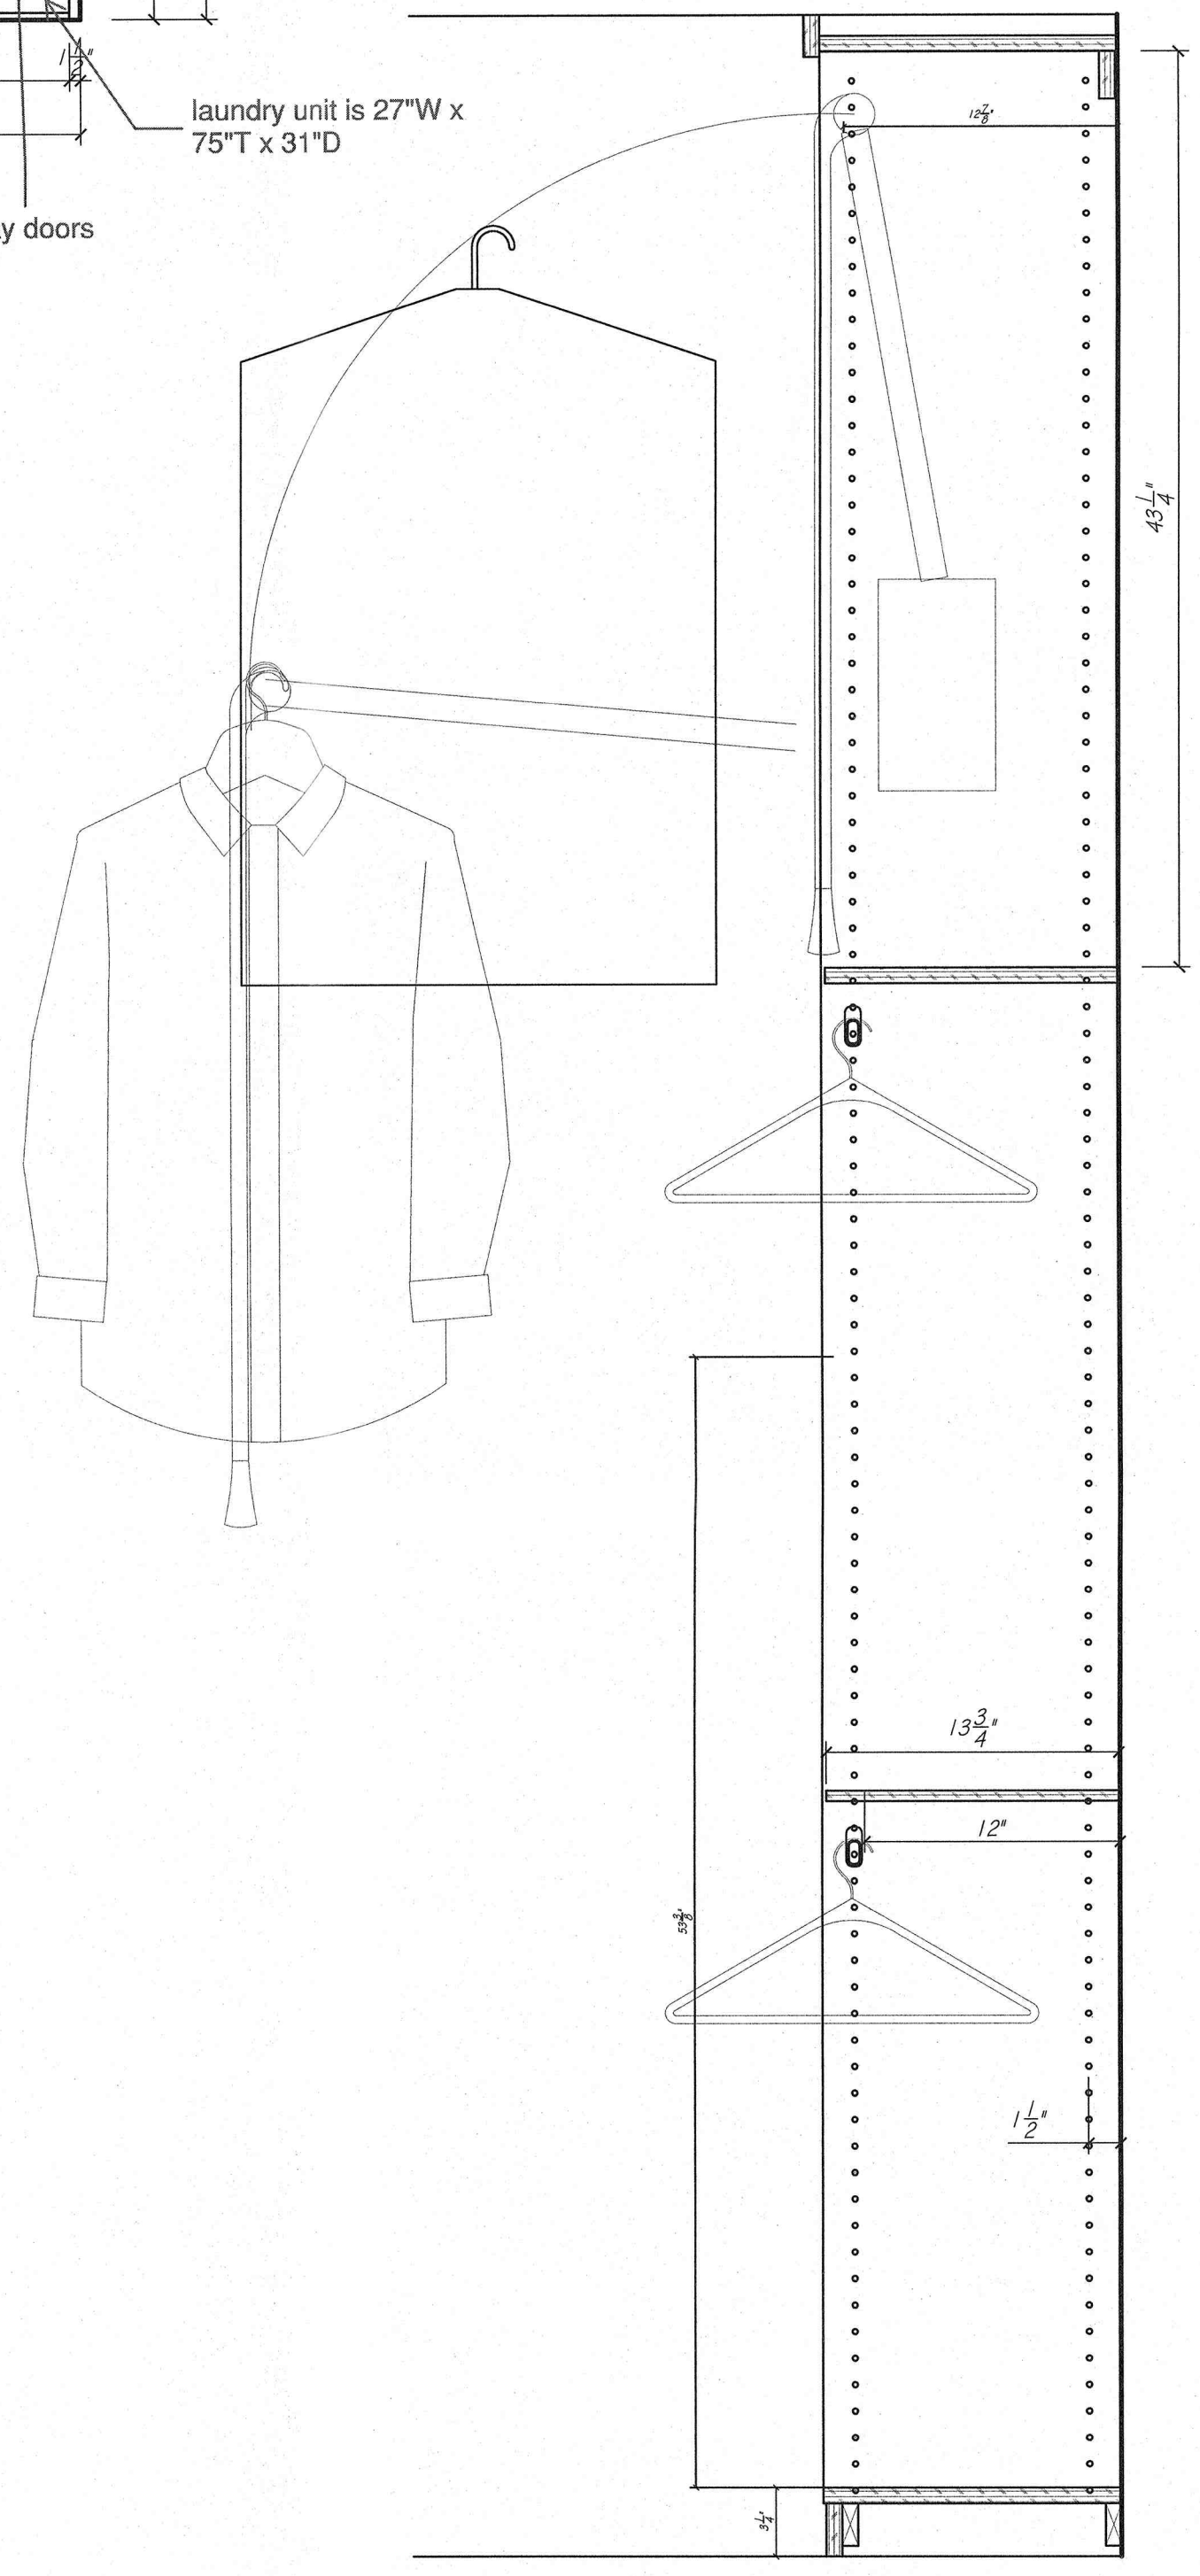


PRIMARY WARDROBE
 SCALE: 1/2" = 1' - 0"






APPROVED BY:
 SIGNATURE
 DATE
 WOOD
 5588

PHIL & MICHELLE WOOD
 3435 N. 140TH. CIRCLE
 OMAHA, NE 68164

DUPLICATION OF THESE DRAWINGS IS PROHIBITED WITHOUT WRITTEN CONSENT BY EUROWOOD CABINETS. © 2004, EUROWOOD CABINETS INC.
 MEASUREMENTS ARE SUBJECT TO CHANGE DUE TO FINAL FIELD MEASUREMENTS.

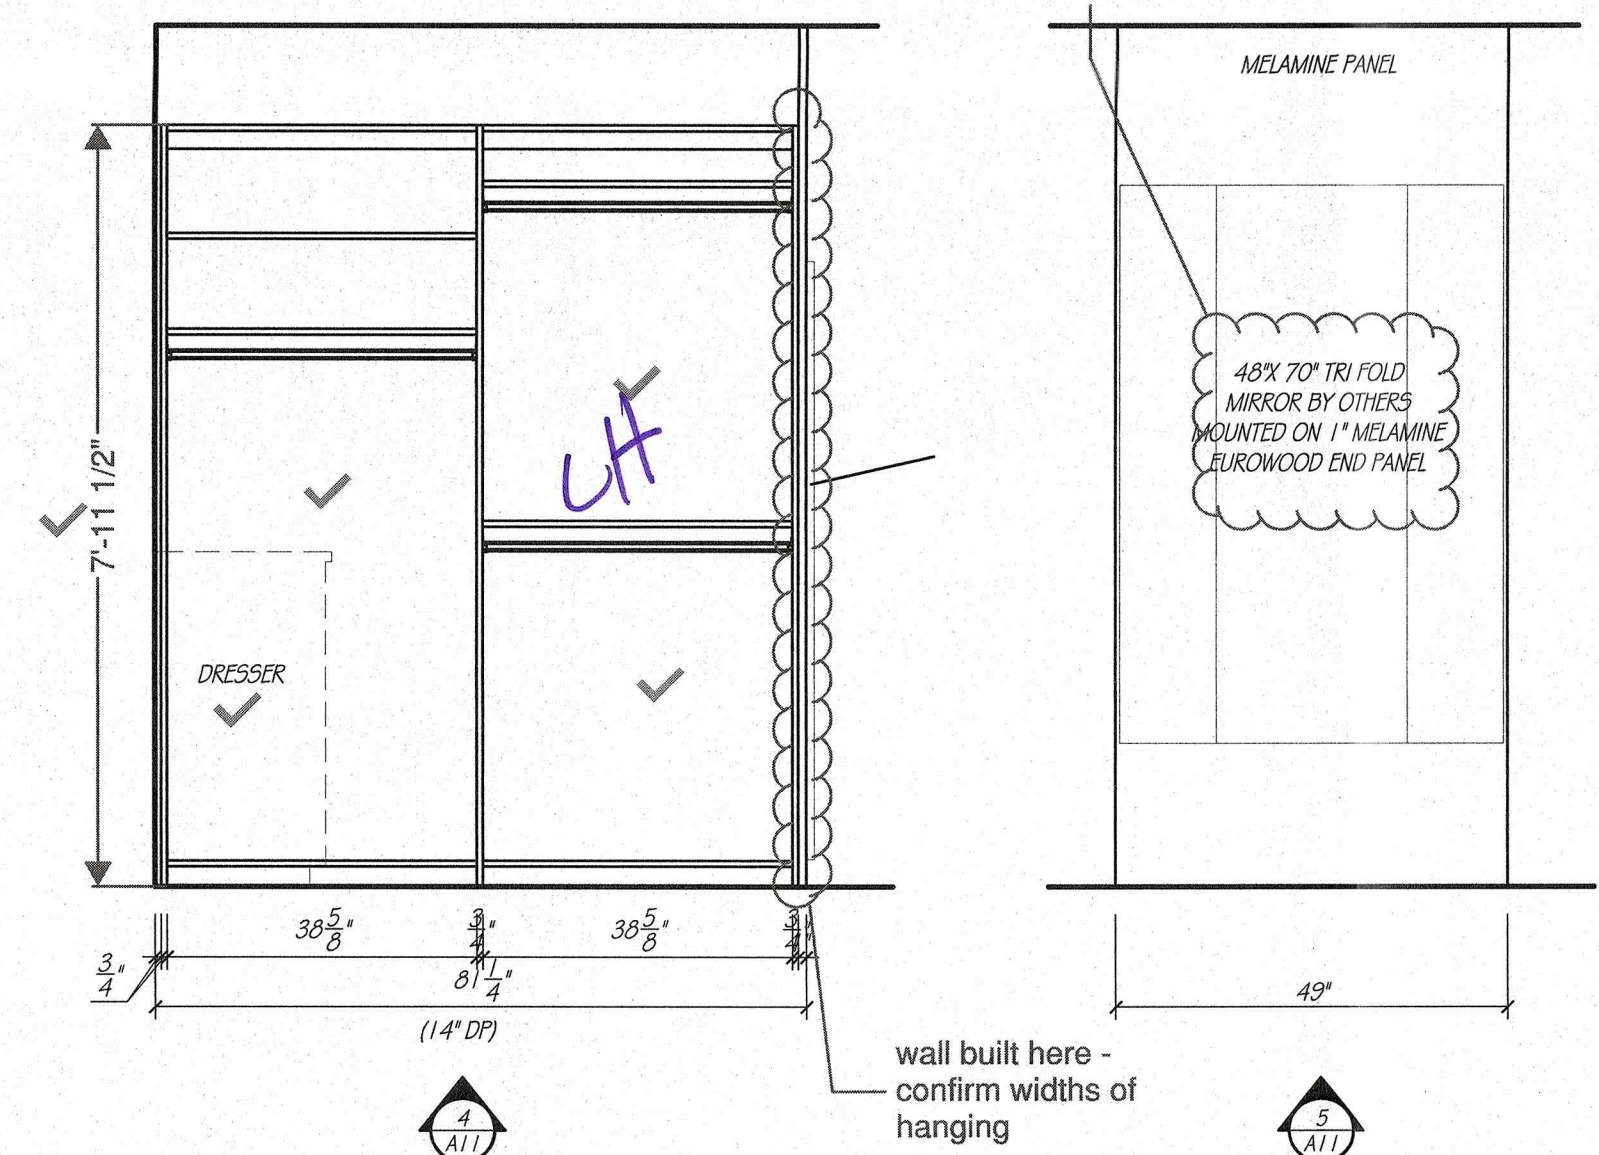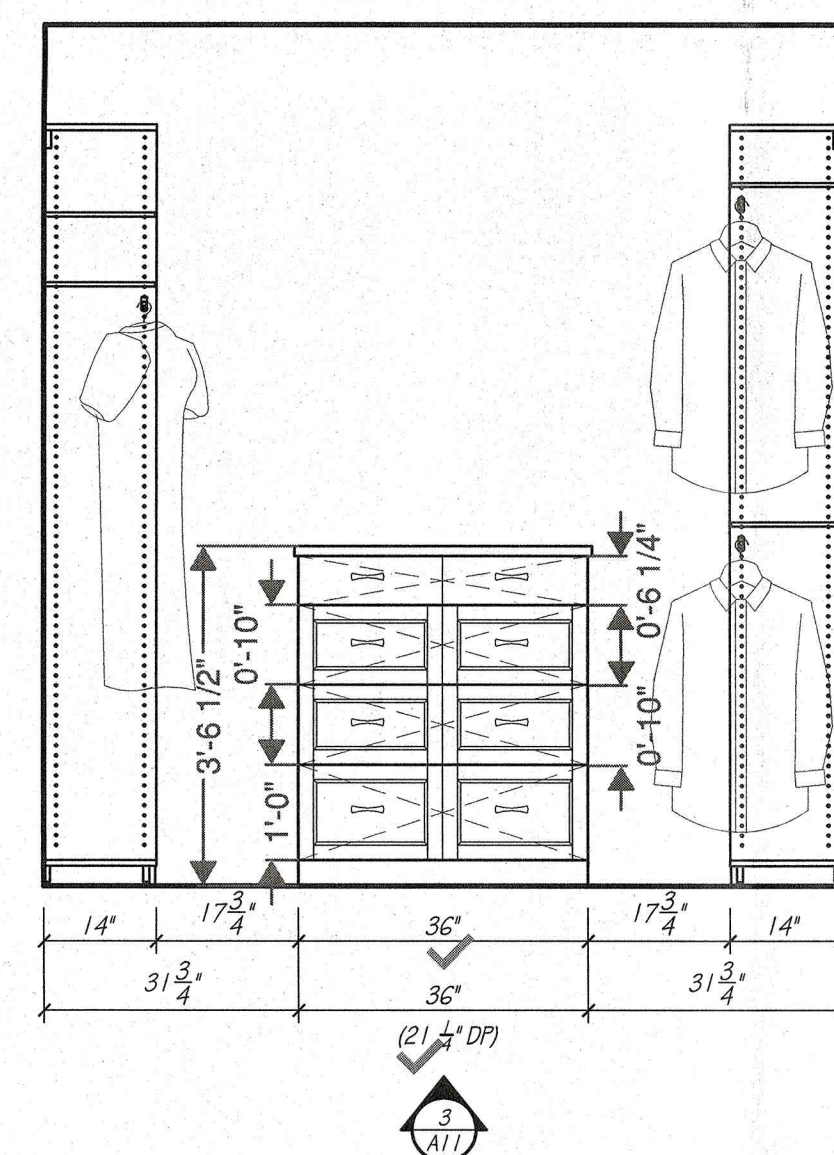
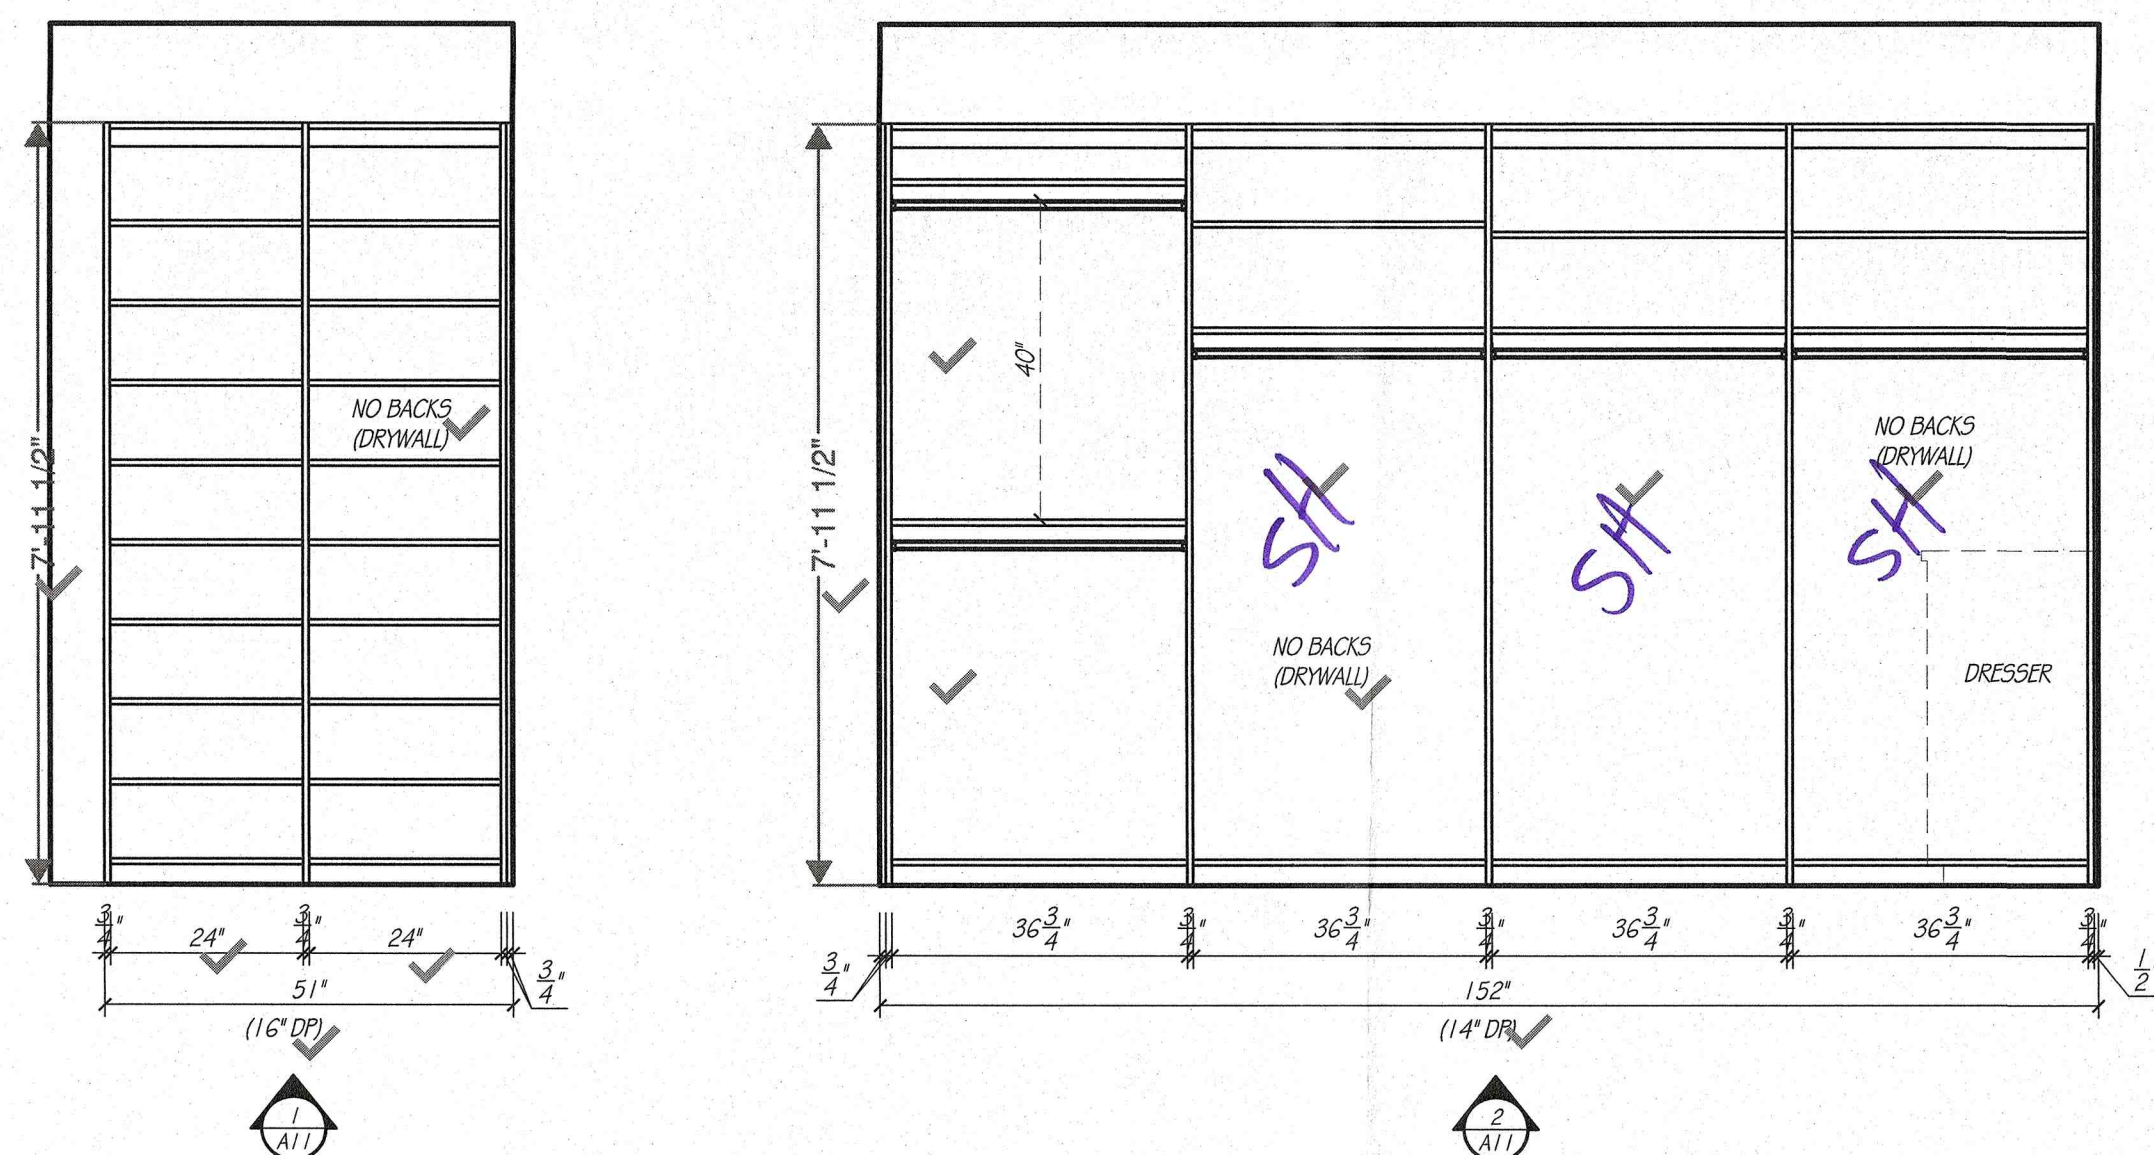


PRIMARY WARDROBE	
CABINET CONSTRUCTION:	
EXTERIORS	WHITE MELAMINE
INTERIORS	WHITE MELAMINE
FACE BANDING	MATCHING PVC EDGE BANDING
CABINET HARDWARE & DRILLING	BY OTHERS
DRAWER SLIDE	FULL EXT. SOFT CLOSE CONCEALED SLIDES
COUNTERTOP SPECIFICATIONS:	
COUNTERTOP MATERIAL	QUARTZ
COUNTERTOP THICKNESS	1 1/4" ALLOWANCE
SUBTOP REQUIREMENTS	NONE
ROOM SPECIFICATIONS	
FLOORING - TYPE / ALLOWANCE	CARPET 5/8"
CASING - W / 1/4" REVEAL	3/4"

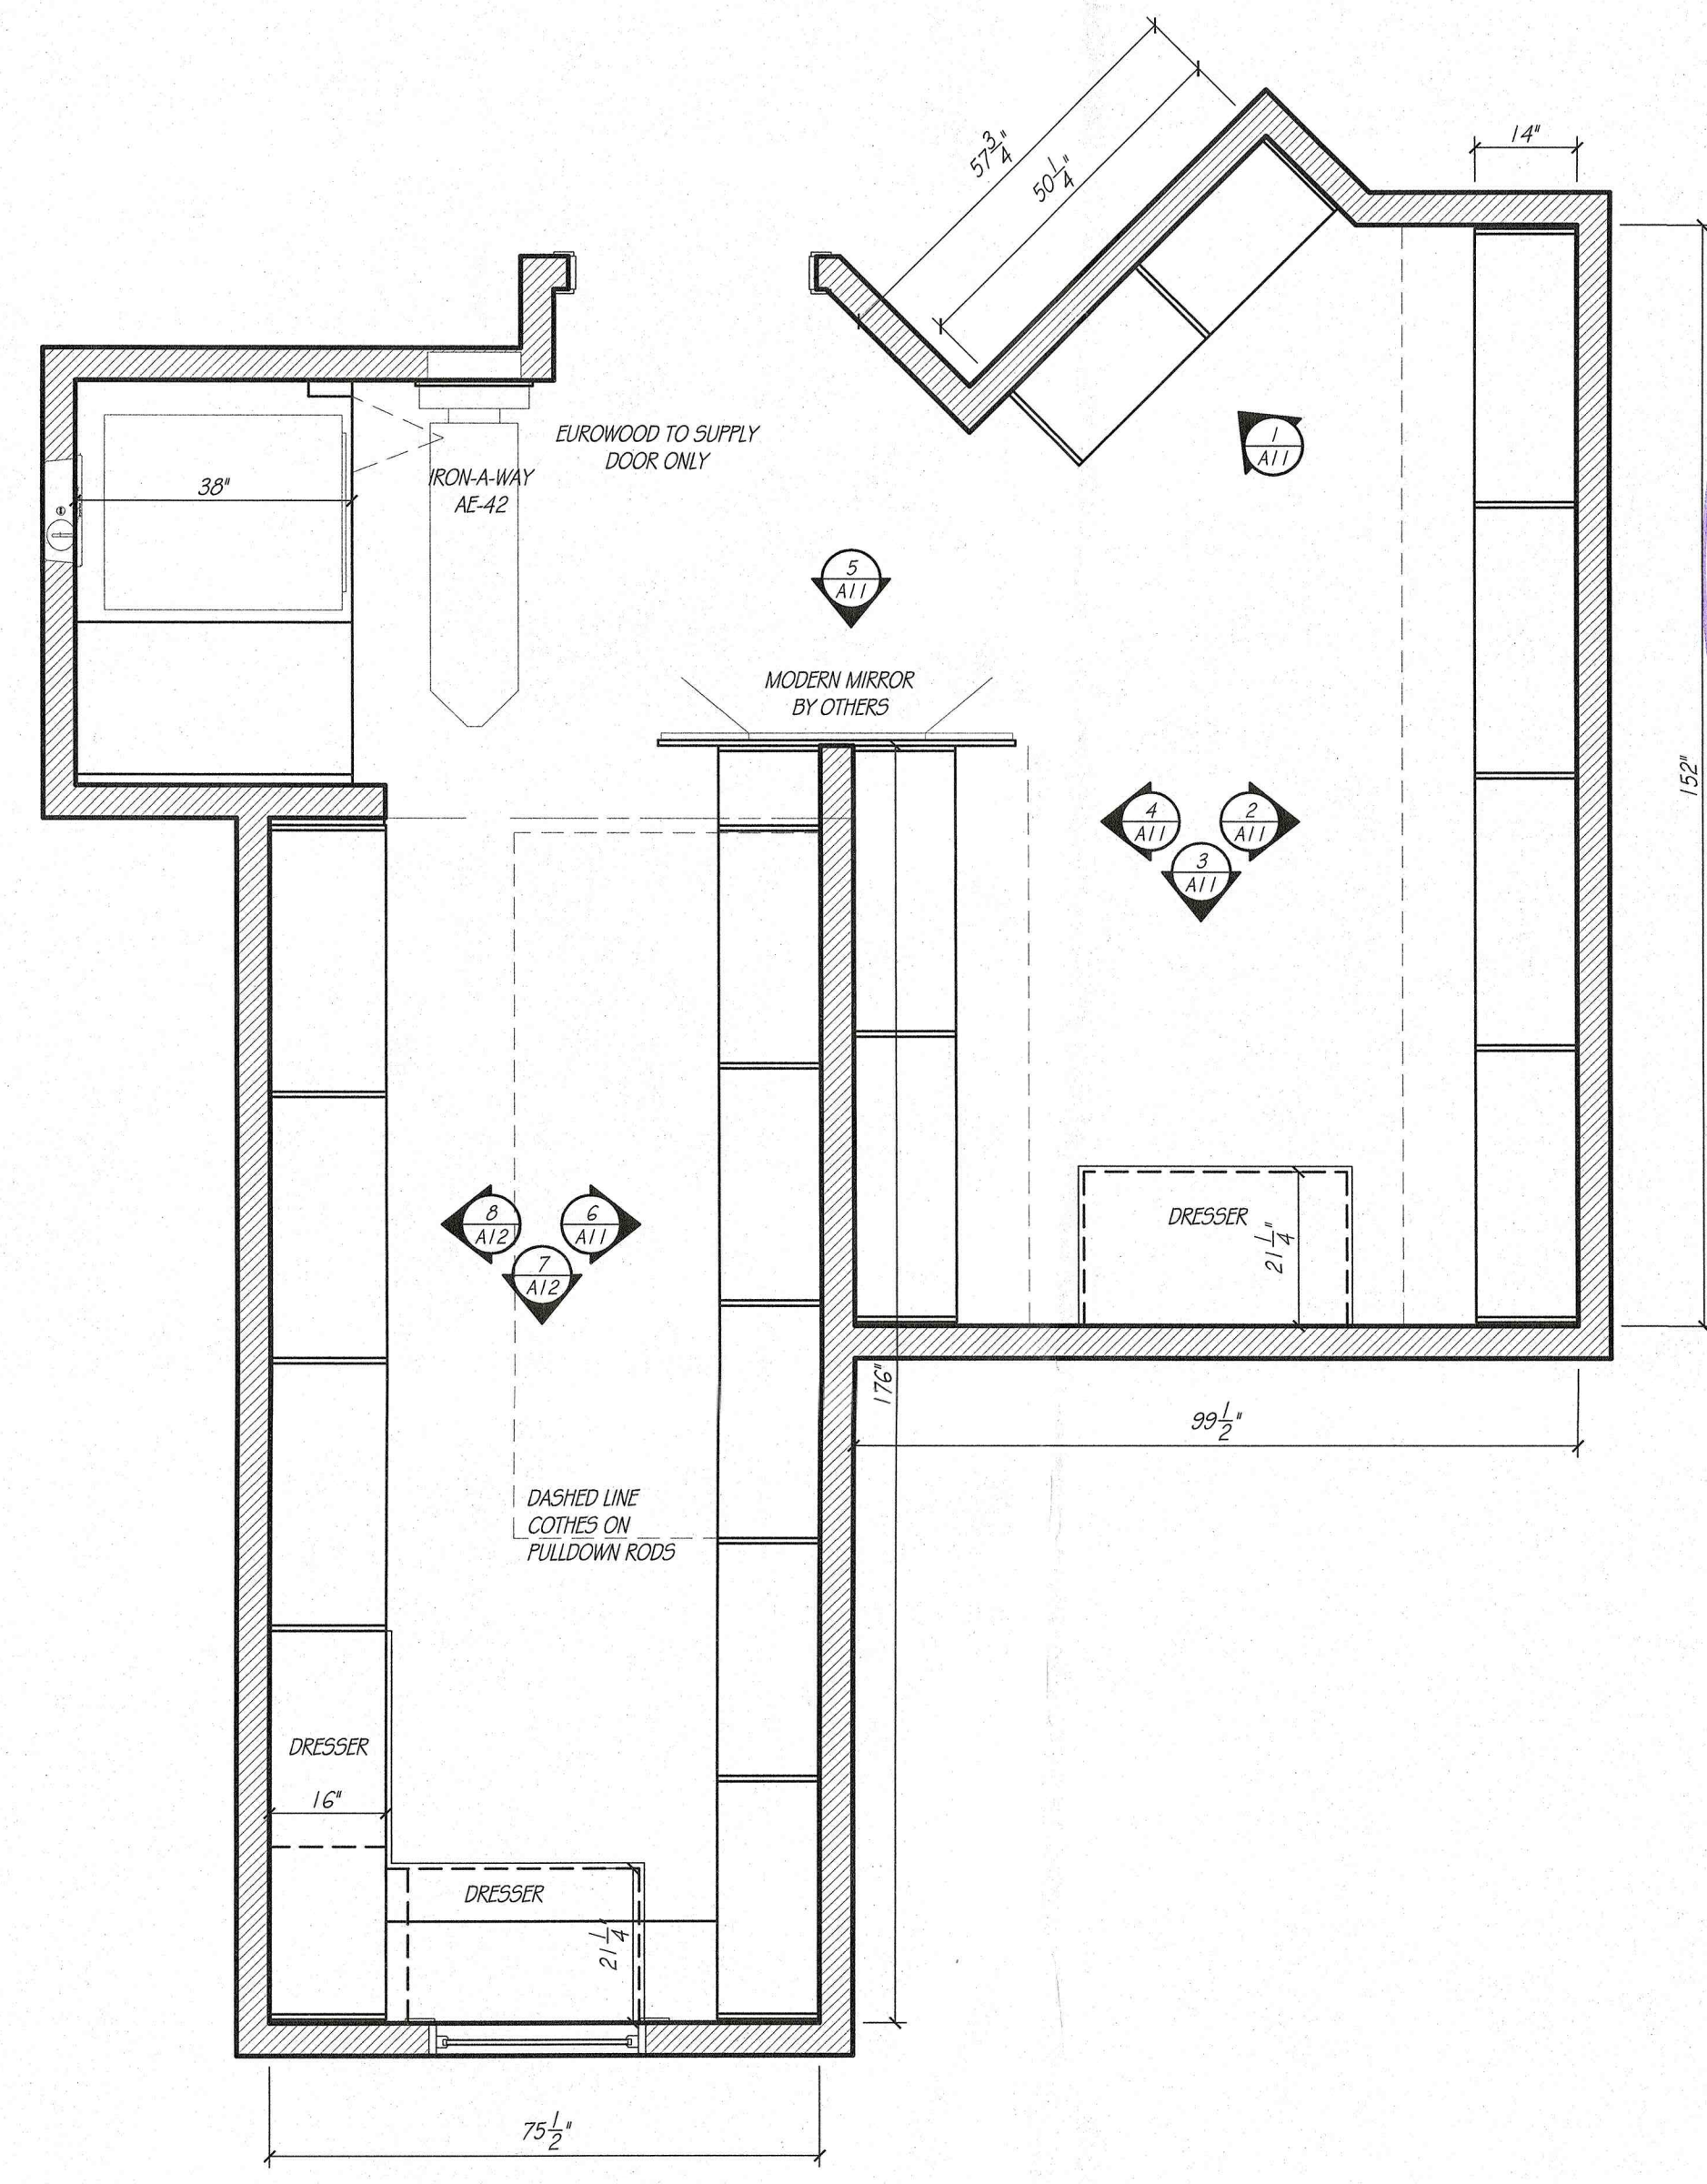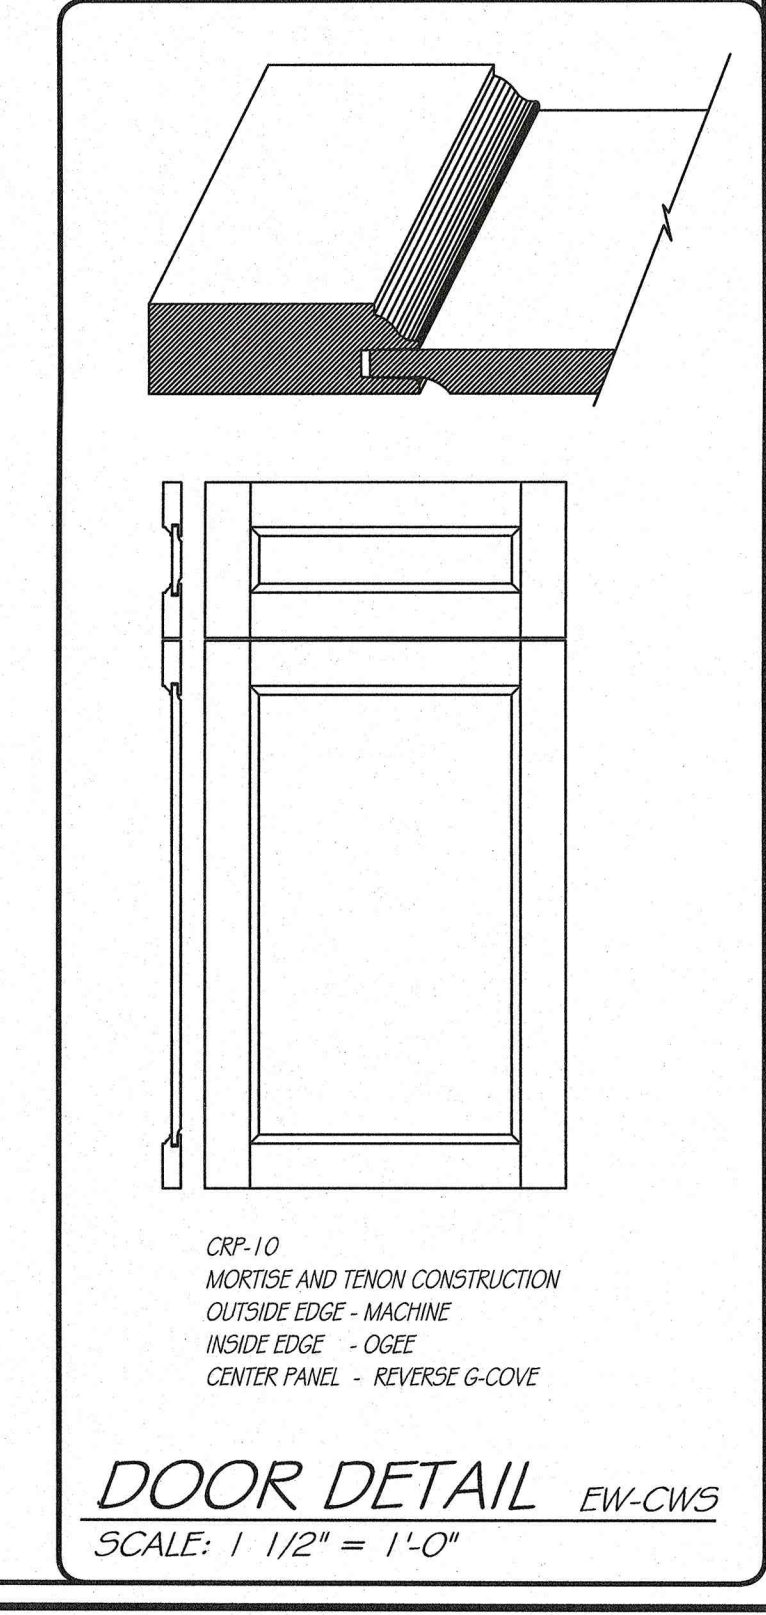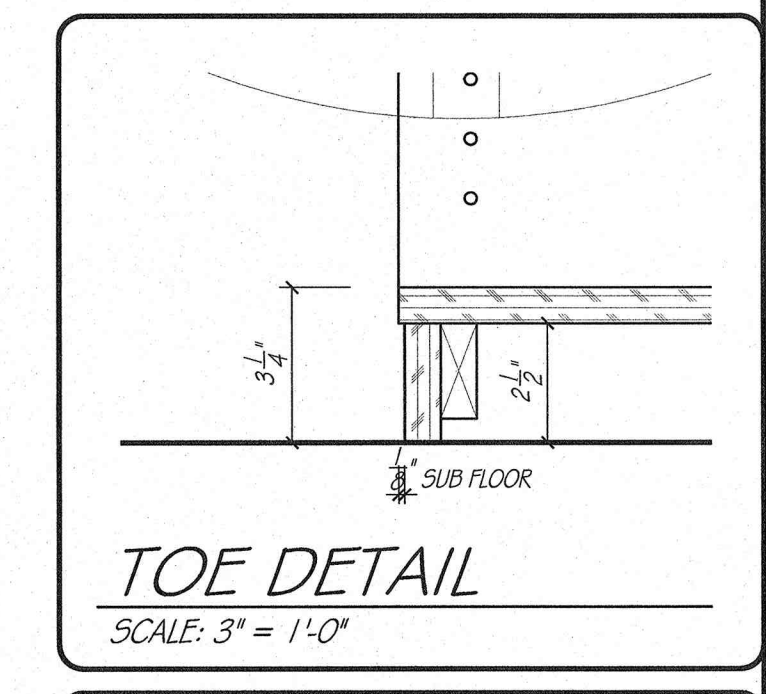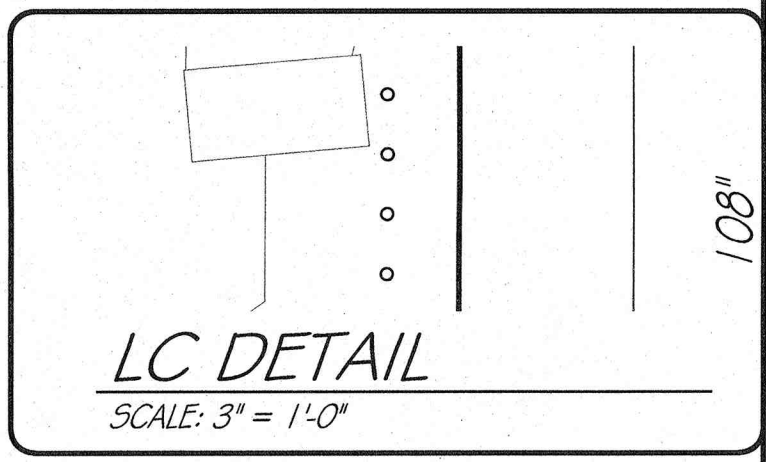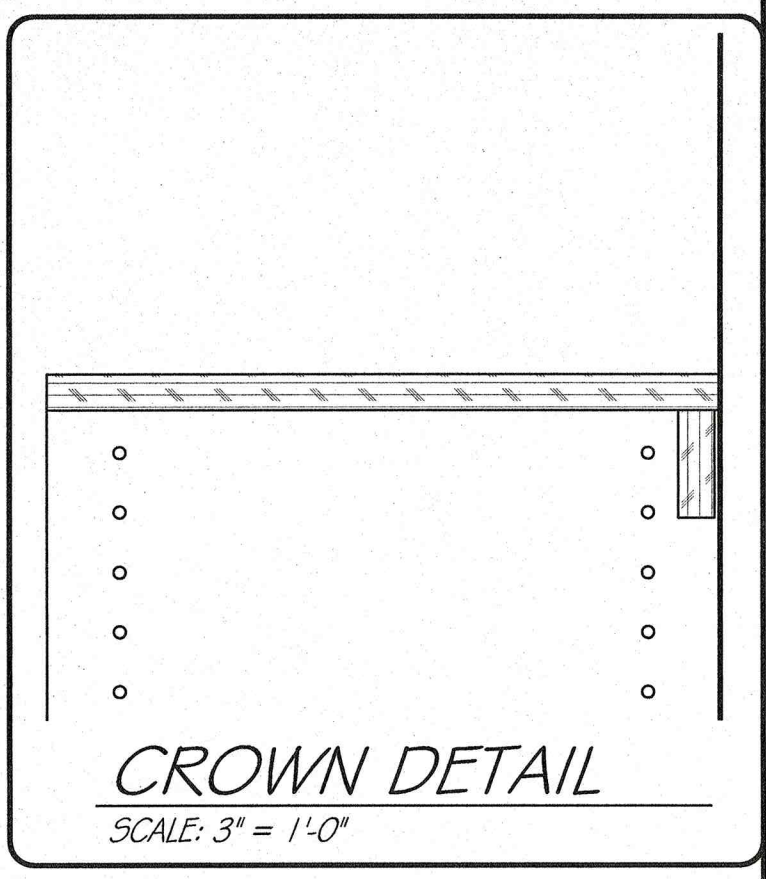

THROTTLED BACKS ON ALL CLOSETS

ADD LIGHTING UP SIDES OF ALL SYSTEM

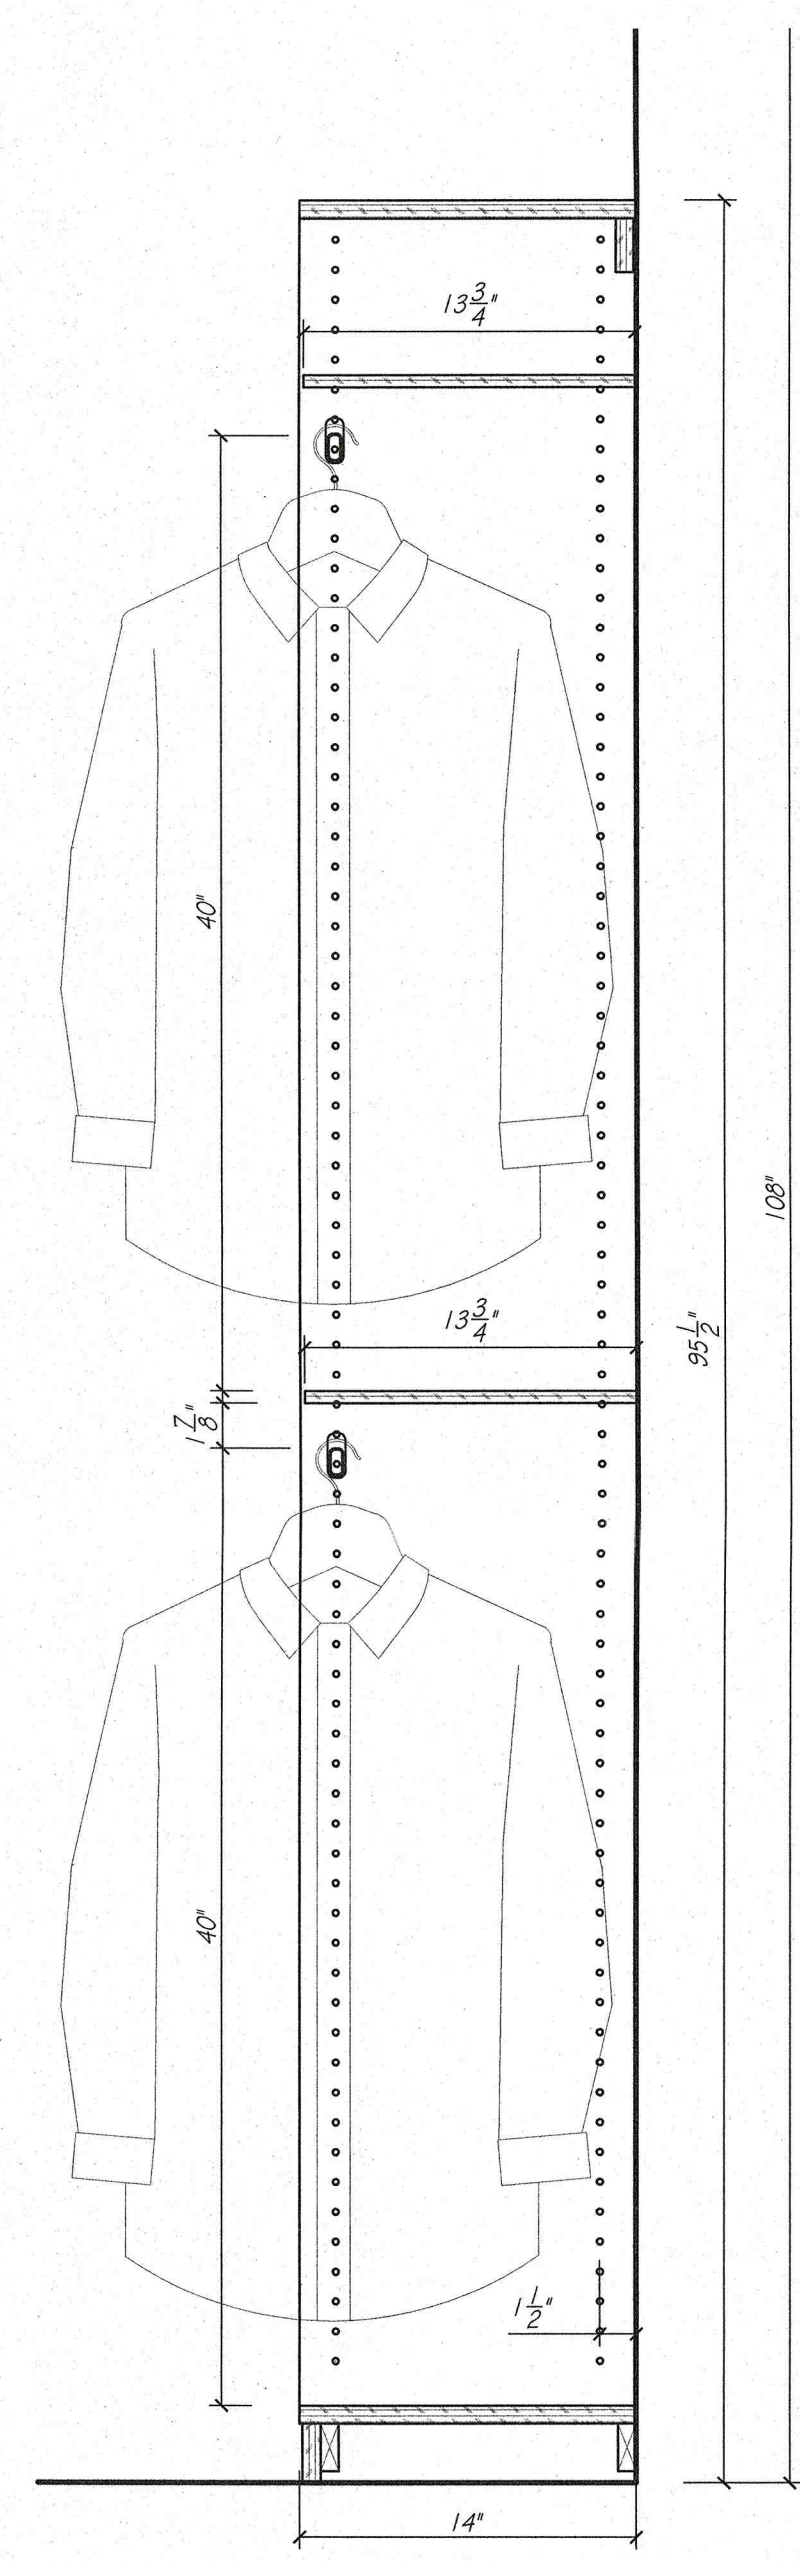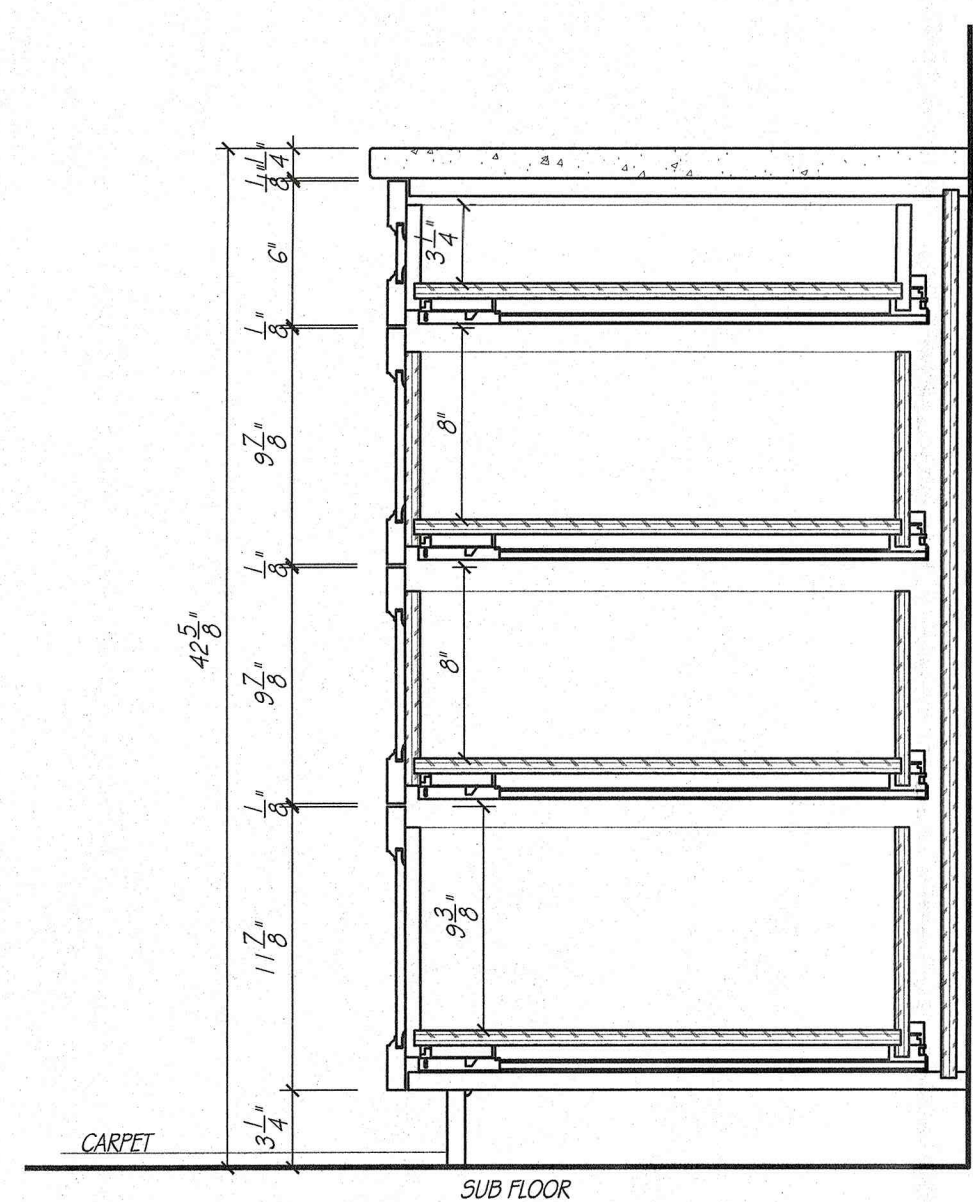

PRIMARY WARDROBE
SCALE: 1/2" = 1'-0"

EUROWOOD Cabinets Inc.
3415 SO. 67TH ST.
OMAHA, NE 68106
TEL (402-393-4110)
FAX (402-393-8361)
(WWW.EUROWOOD.NET)

SHEET: A / I
DRAWN BY: SJB
PLAN: MAIN LEVEL
PRIMARY WARDROBE
REVISIONS: 1 JUNE 26

PHIL & MICHELLE WOOD
3435 N. 140TH. CIRCLE
OMAHA, NE 68164

APPROVED BY: _____
SIGNATURE _____
DATE _____

WOOD
5588