



LEAVE
LL SUITE CAN
LIGHTS AS IS

BULLNOSE IF AVAILABLE
- ASK KYLE

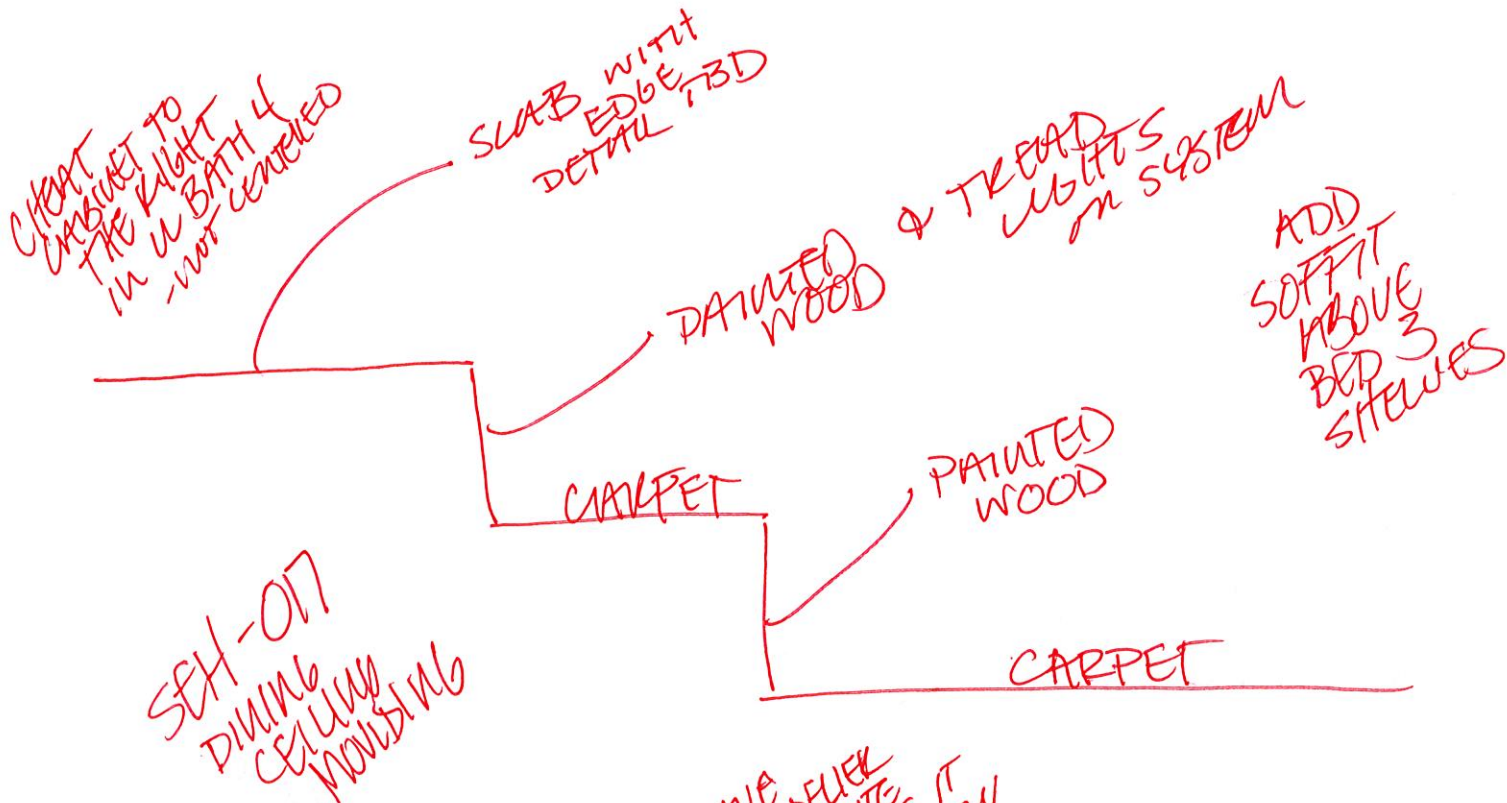

LEAVE CHANDELIER IN W SUITE WHERE IT IS NOW

Full DEPTH CLOSET SYSTEM IN GARAGE COATS
- MOVE CAN OUT A LITTLE
- NOT WHITE

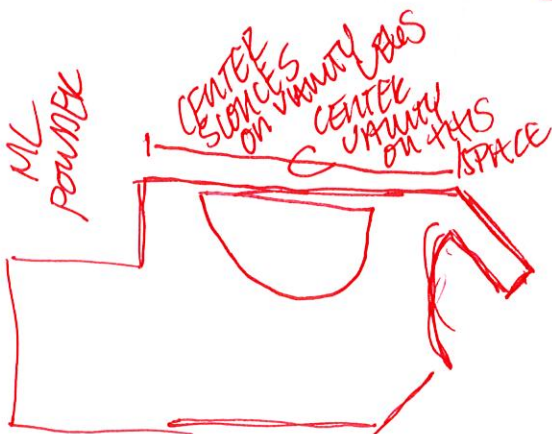

DINING
MOVE SPEAKERS in 4" EACH

ART
SEE
SB x 44

AND ADJUST MOULDINGS TO MAKE UP ADDTN SPACING
- FINALIZE AFTER DRYWALL

KAY IS GETTING FURNITURE & WILL LOCATE ON SITE

OMBINETRY

SEND LINK
FOR LINK
TO ACCESS
BOOK

TEST CONTROL
CONTACT

~~PLUMBING DATA QUESTION~~

~~ASK ABOUT ADDING
SOFTWARE ABOVE STEELING
IN BED 3 FOR DOWN~~

~~DIAGNOSTIC SPENDER WORKING~~

~~PLUMBING UNIT WORKING
IN PL POWER & SINKS~~

~~W/ BATH 14 UNIT
PERCENTAGE~~

~~W/ BATH 14 UNIT
DIAGNOSTIC~~

Miscellaneous List for Wood's

ML

1. Remove drywall below Great Room windows (replacing moldy stuff)
2. Is art niche in Primary Vestibule framed right? Look at interior elevation
- 3.
- 4.
- 5.
- 6.
- 7.
- 8.

LL

1. Nothing
- 2.
- 3.
- 4.
- 5.
- 6.

UL

1. Take off all remaining outlet and switch covers
2. Remove all remaining door hardware, less hinges
3. Remove base at Balcony - getting replaced with 6" - want to discuss how this ties in with stair detail
4. Remove remaining base in Bath 2
5. Delete smoke by electrician outside of Bed 3
6. Why is that old smoke/siren still hanging in wall by Bed 3? Make it go away
7. Smoke still needs to be moved to corner by Bed 2
- 8.
- 9.
- 10.
- 11.
- 12.
- 13.

KEEP
BATH crown
SAME &
MATCH THROUGHOUT
BATHROOM only

Madisyn van den Boogaart

Project Manager



McNeil Company

4666 S 132nd St Omaha, NE 68137



c: (402) 881-7745

e: madisynm@mcneilcompany.com



DEVELOP | DESIGN | BUILD

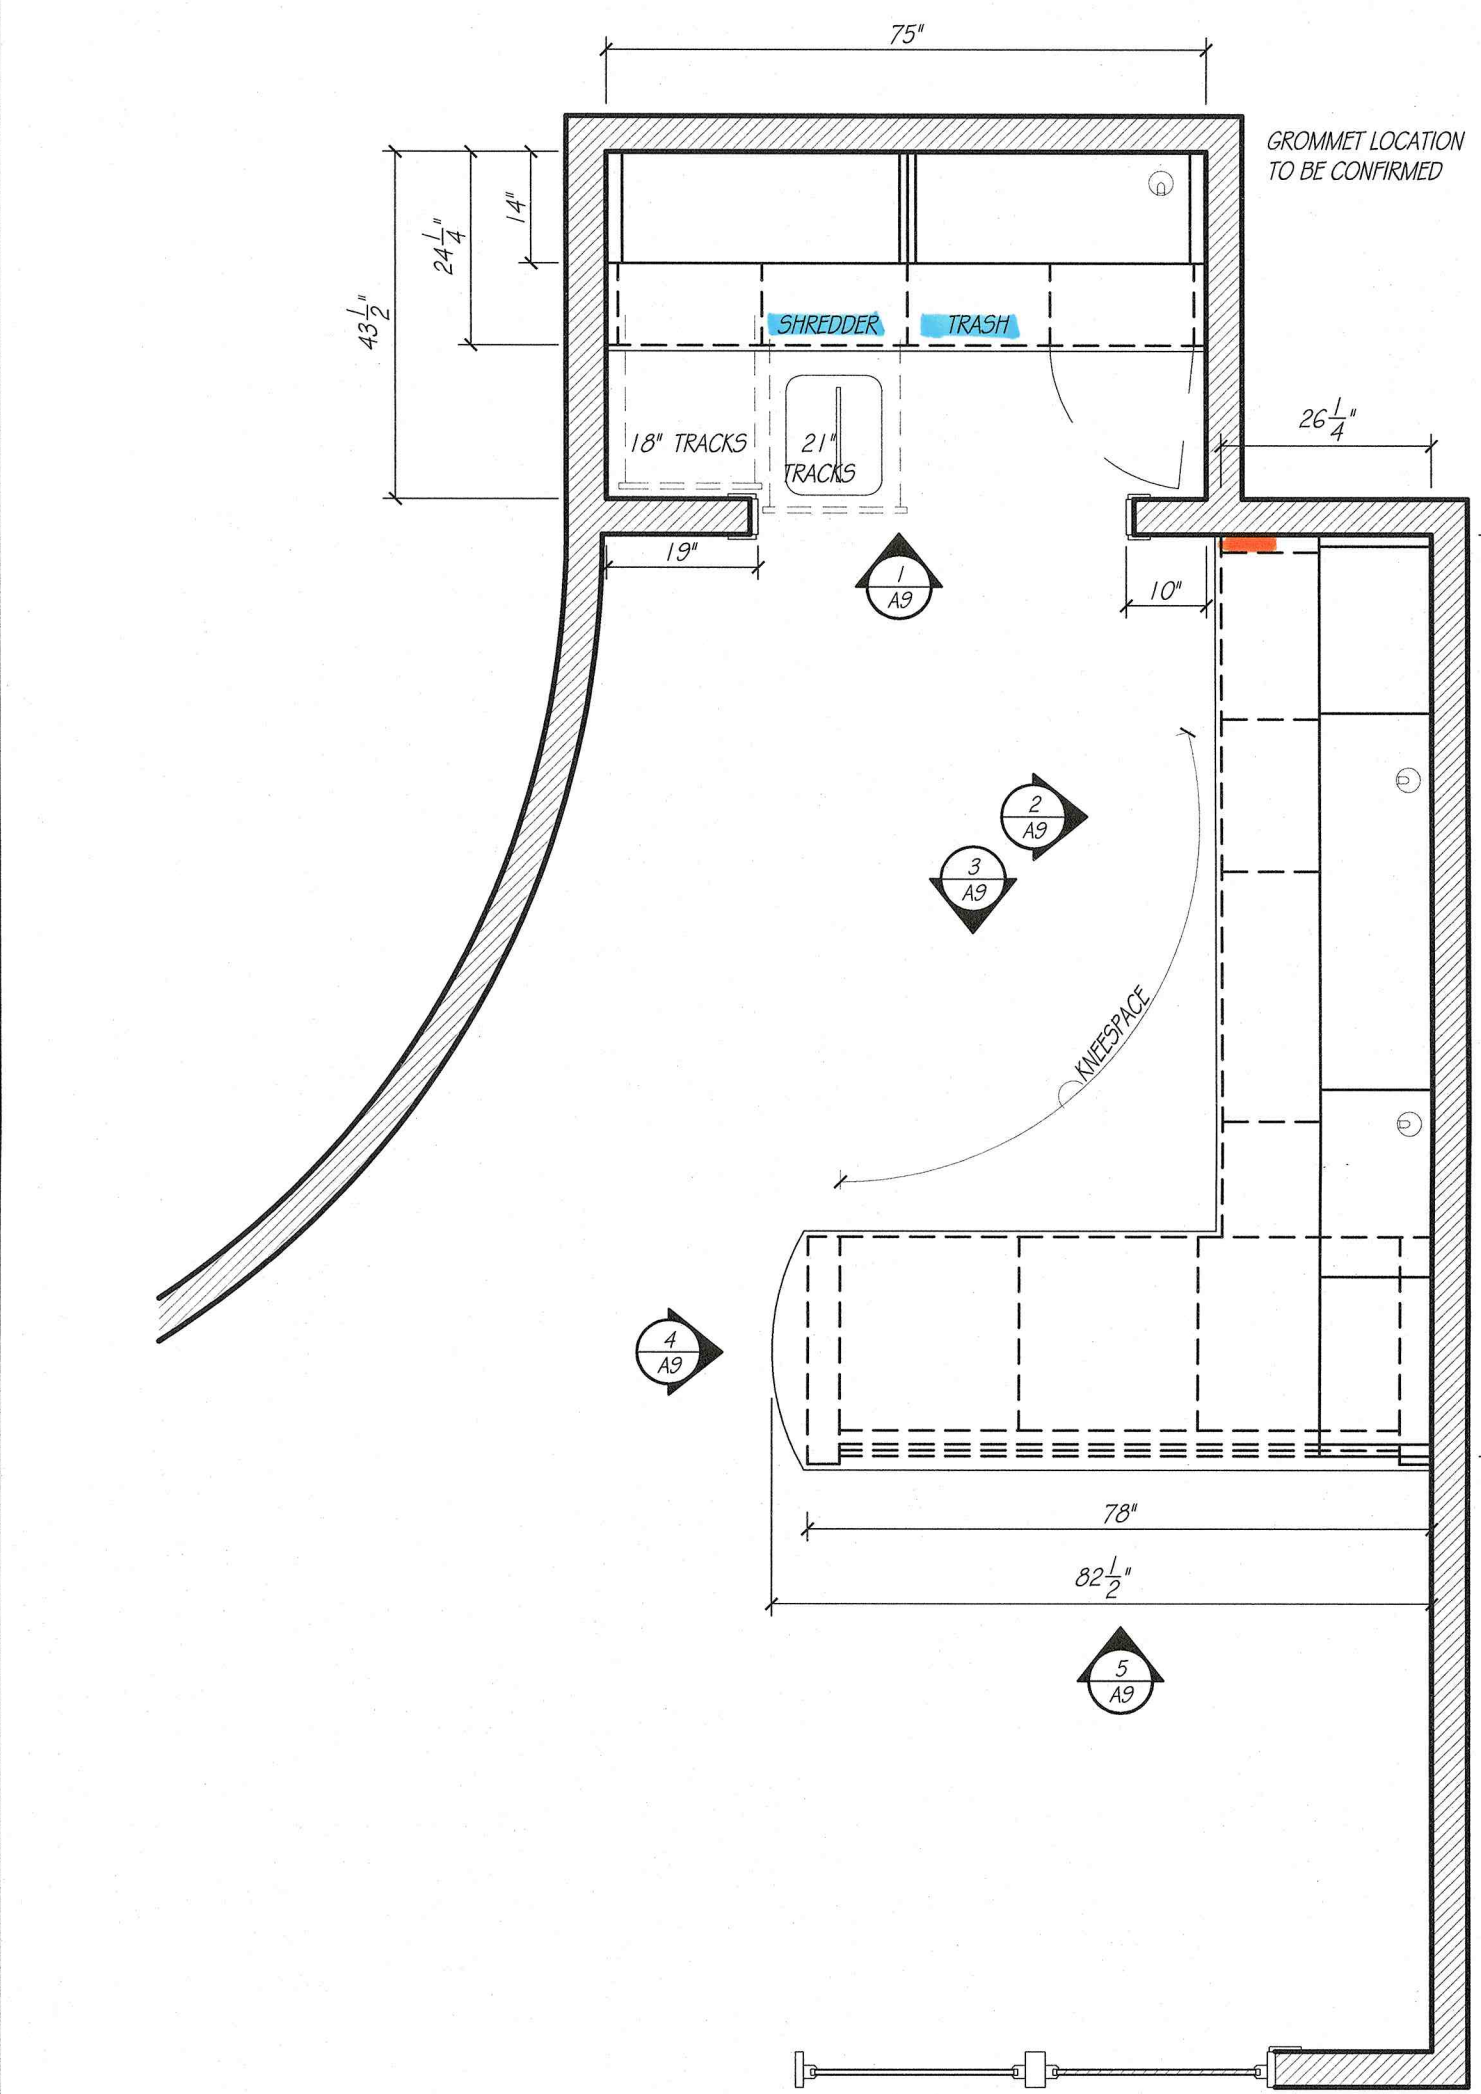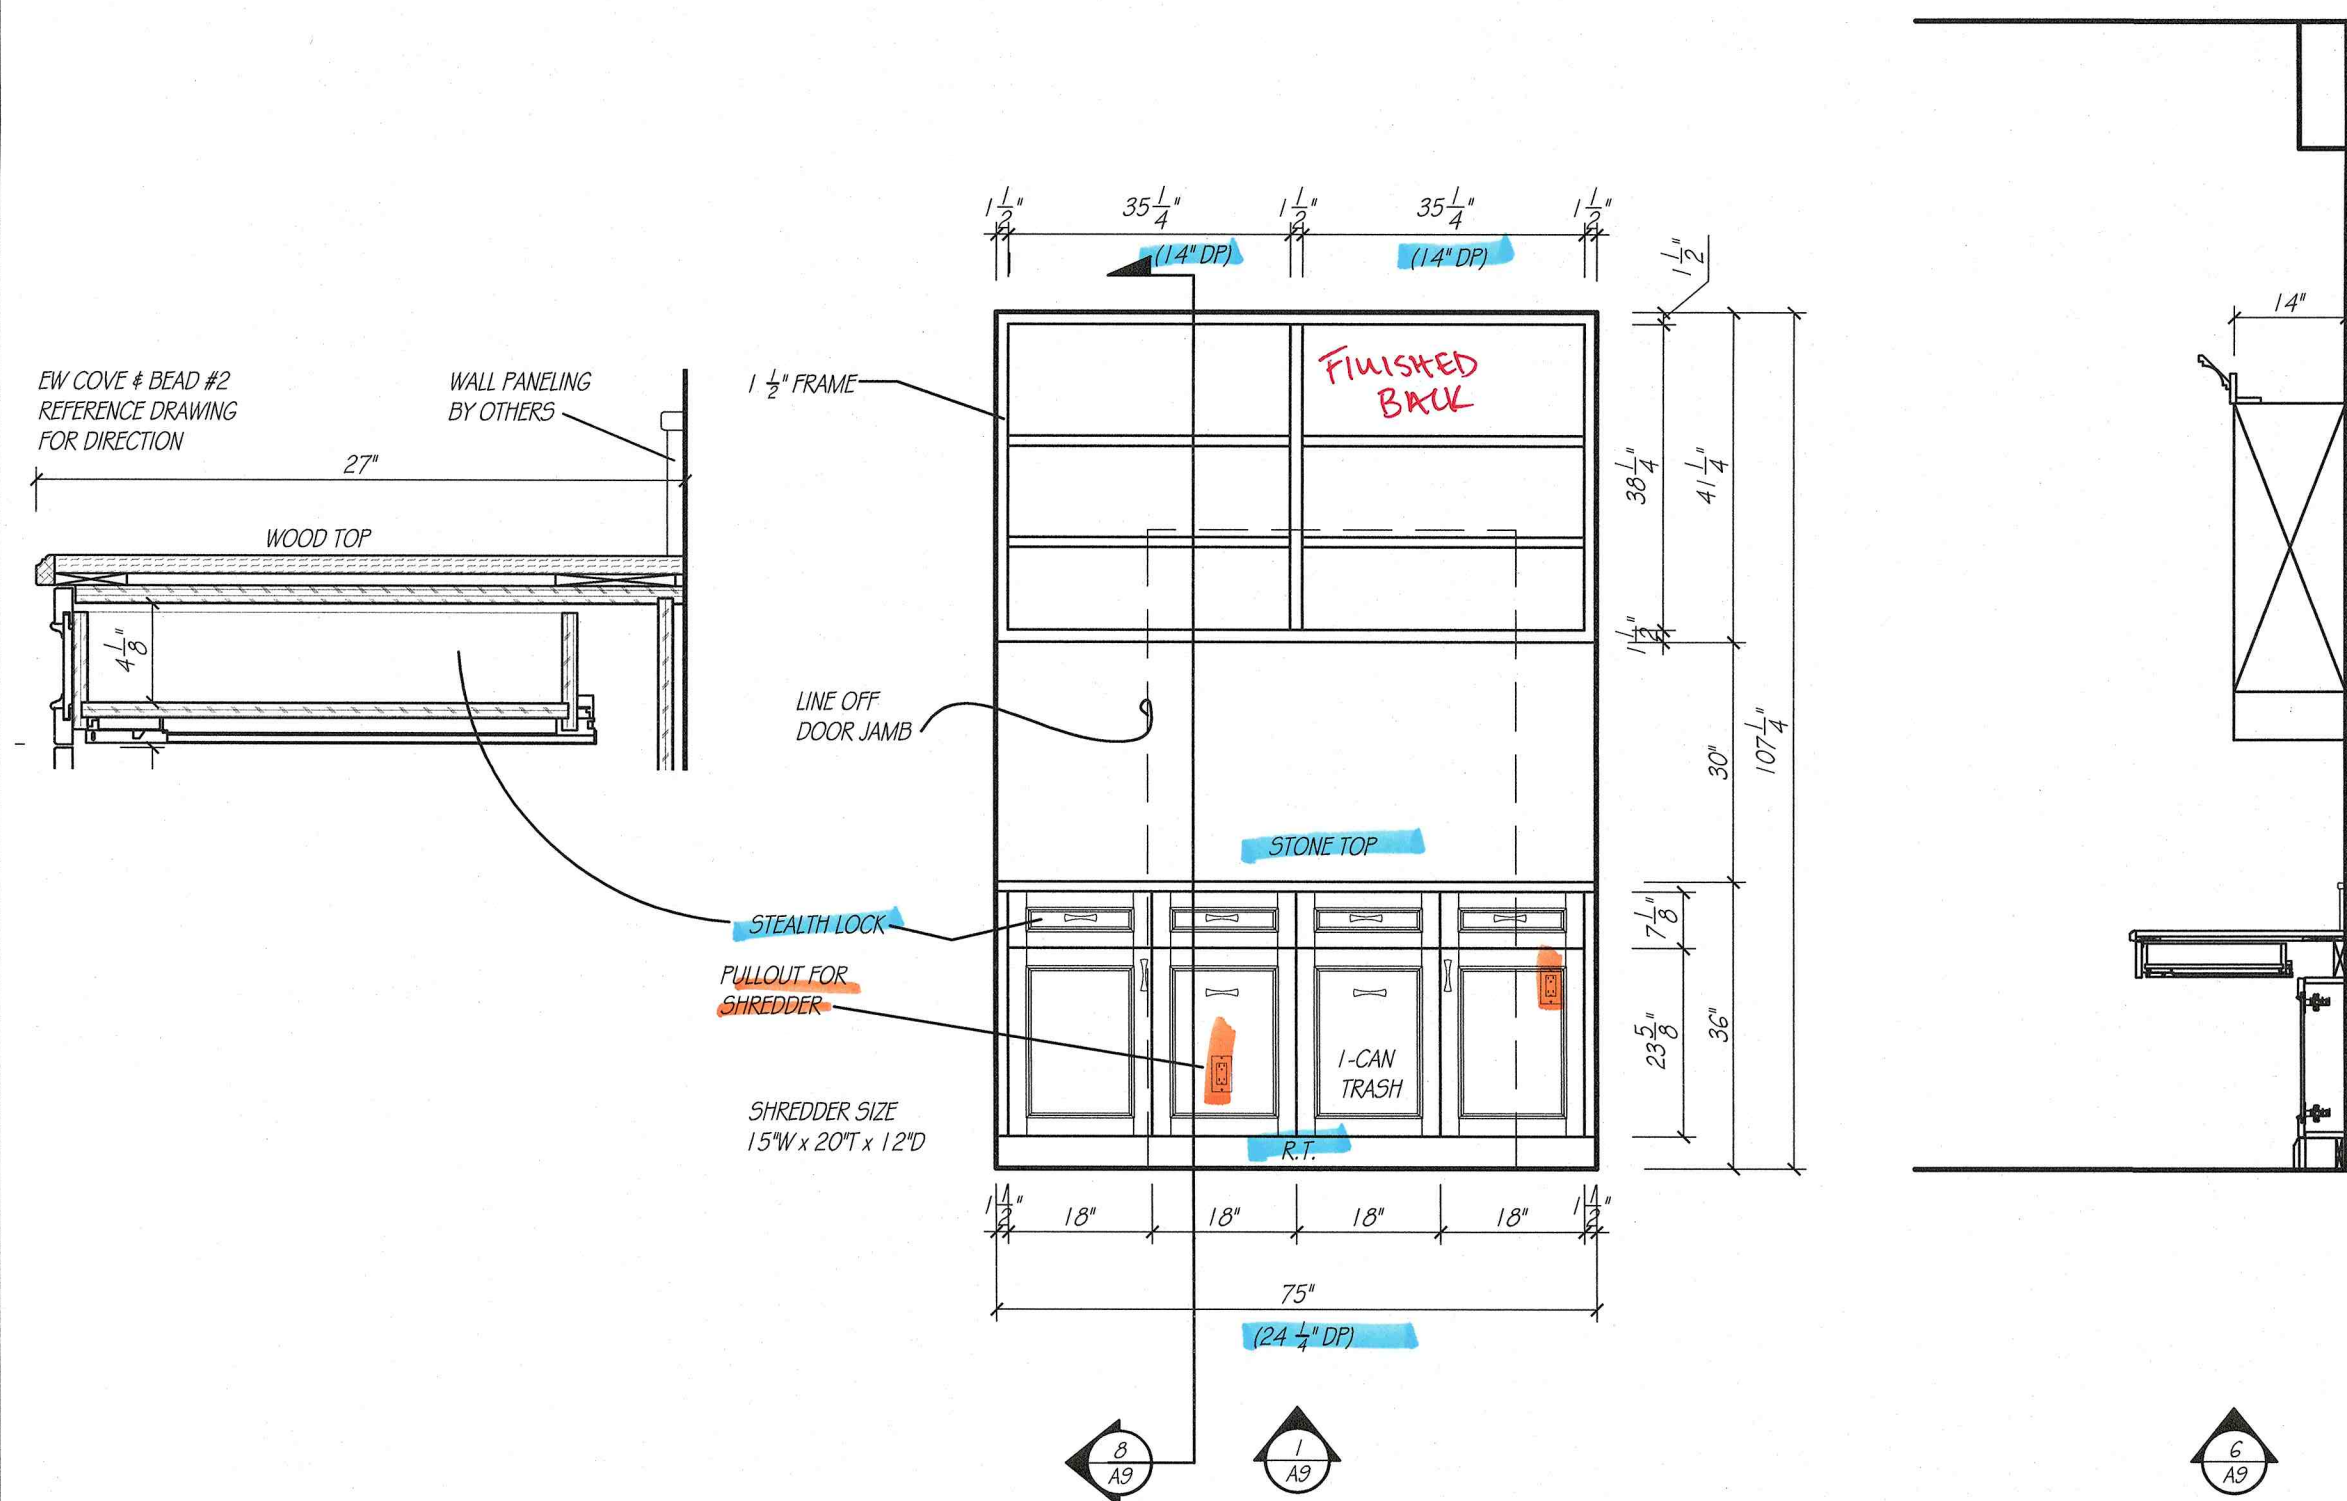



DEN
SCALE: 1/2\"/>

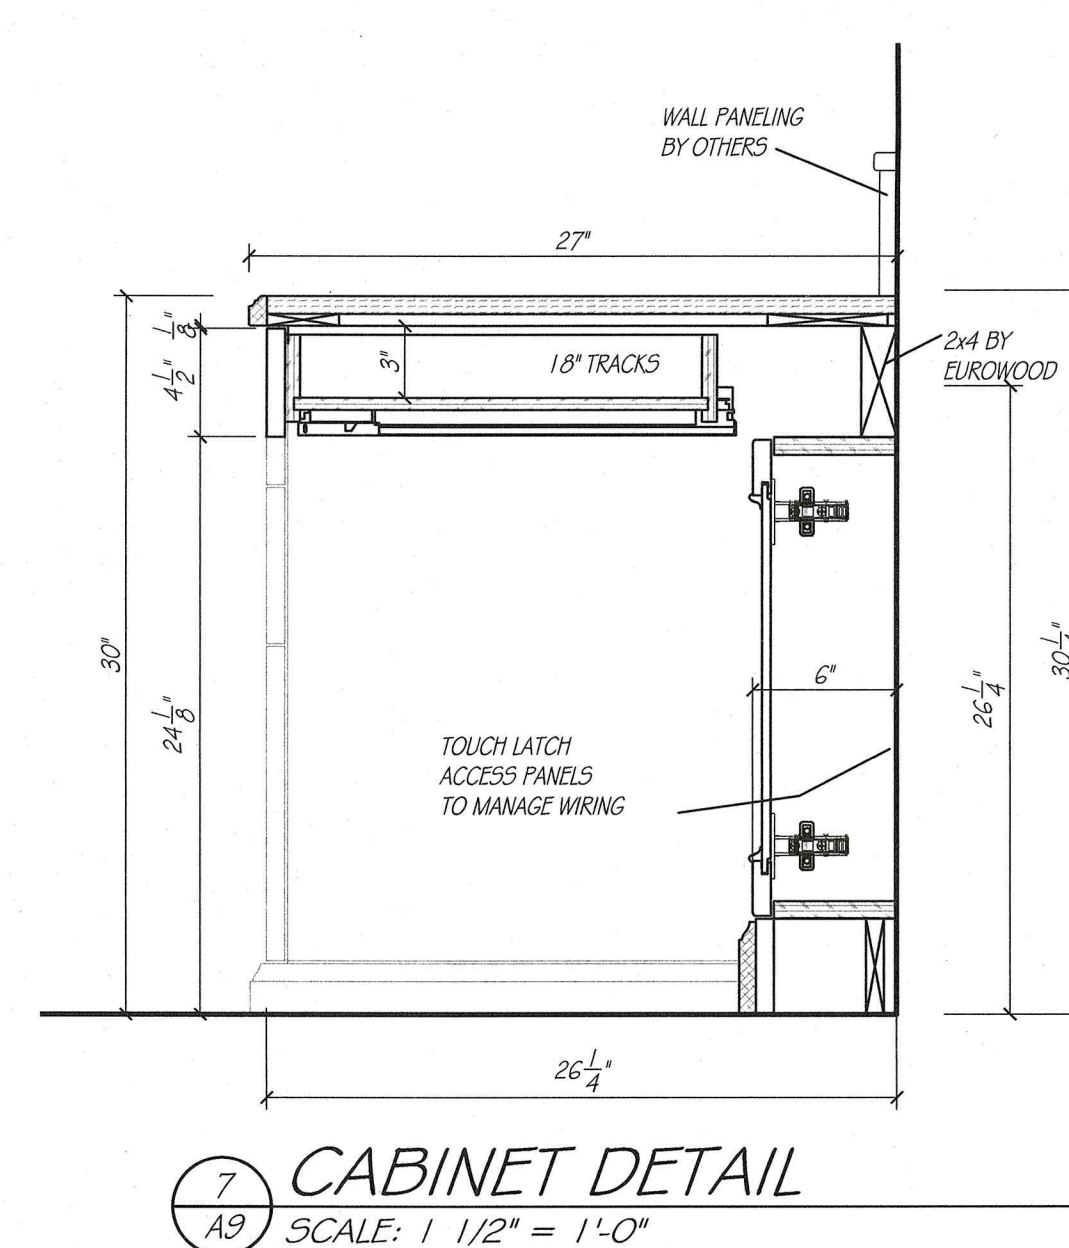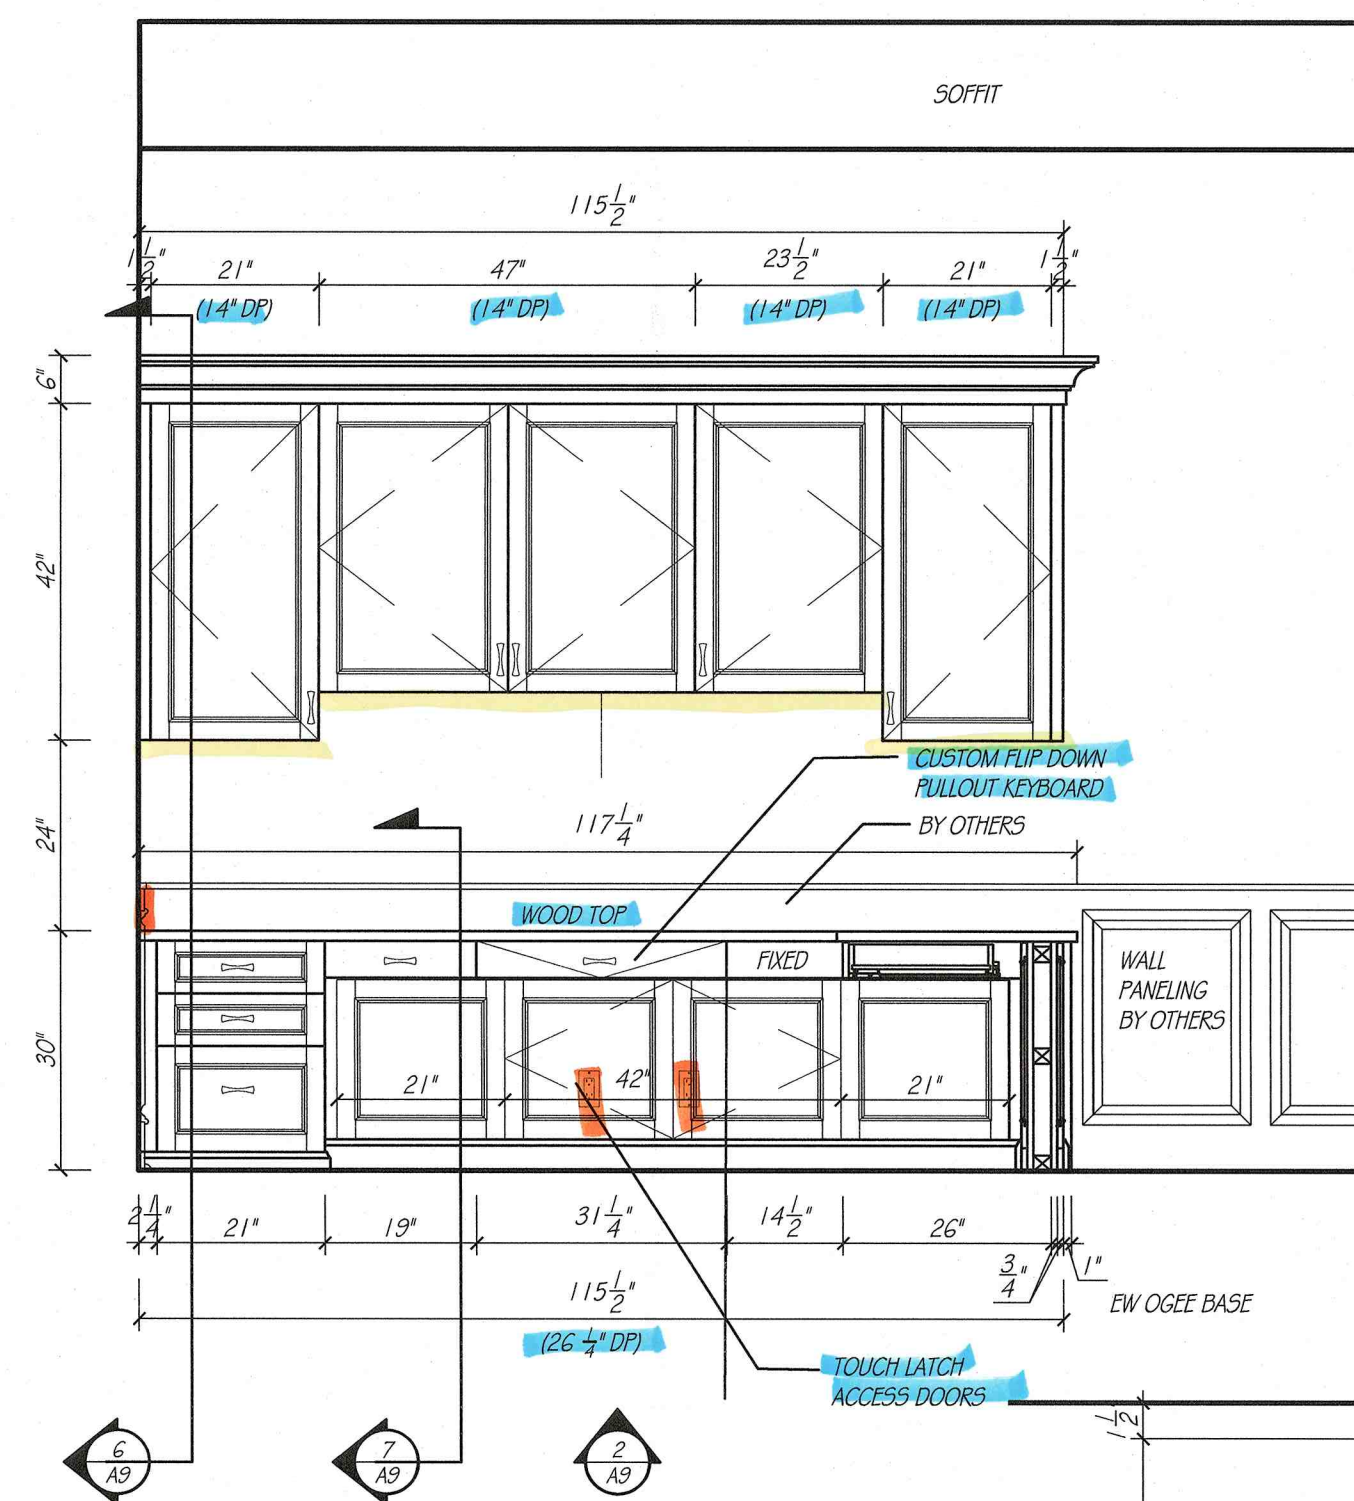

7 CABINET DETAIL
SCALE: 1 1/2\"/>

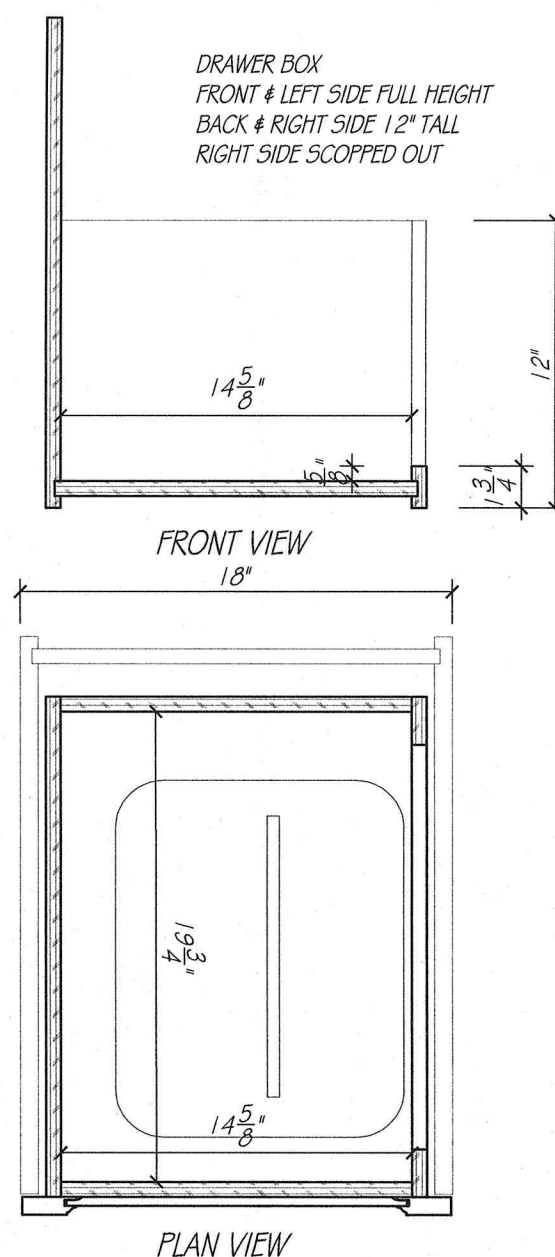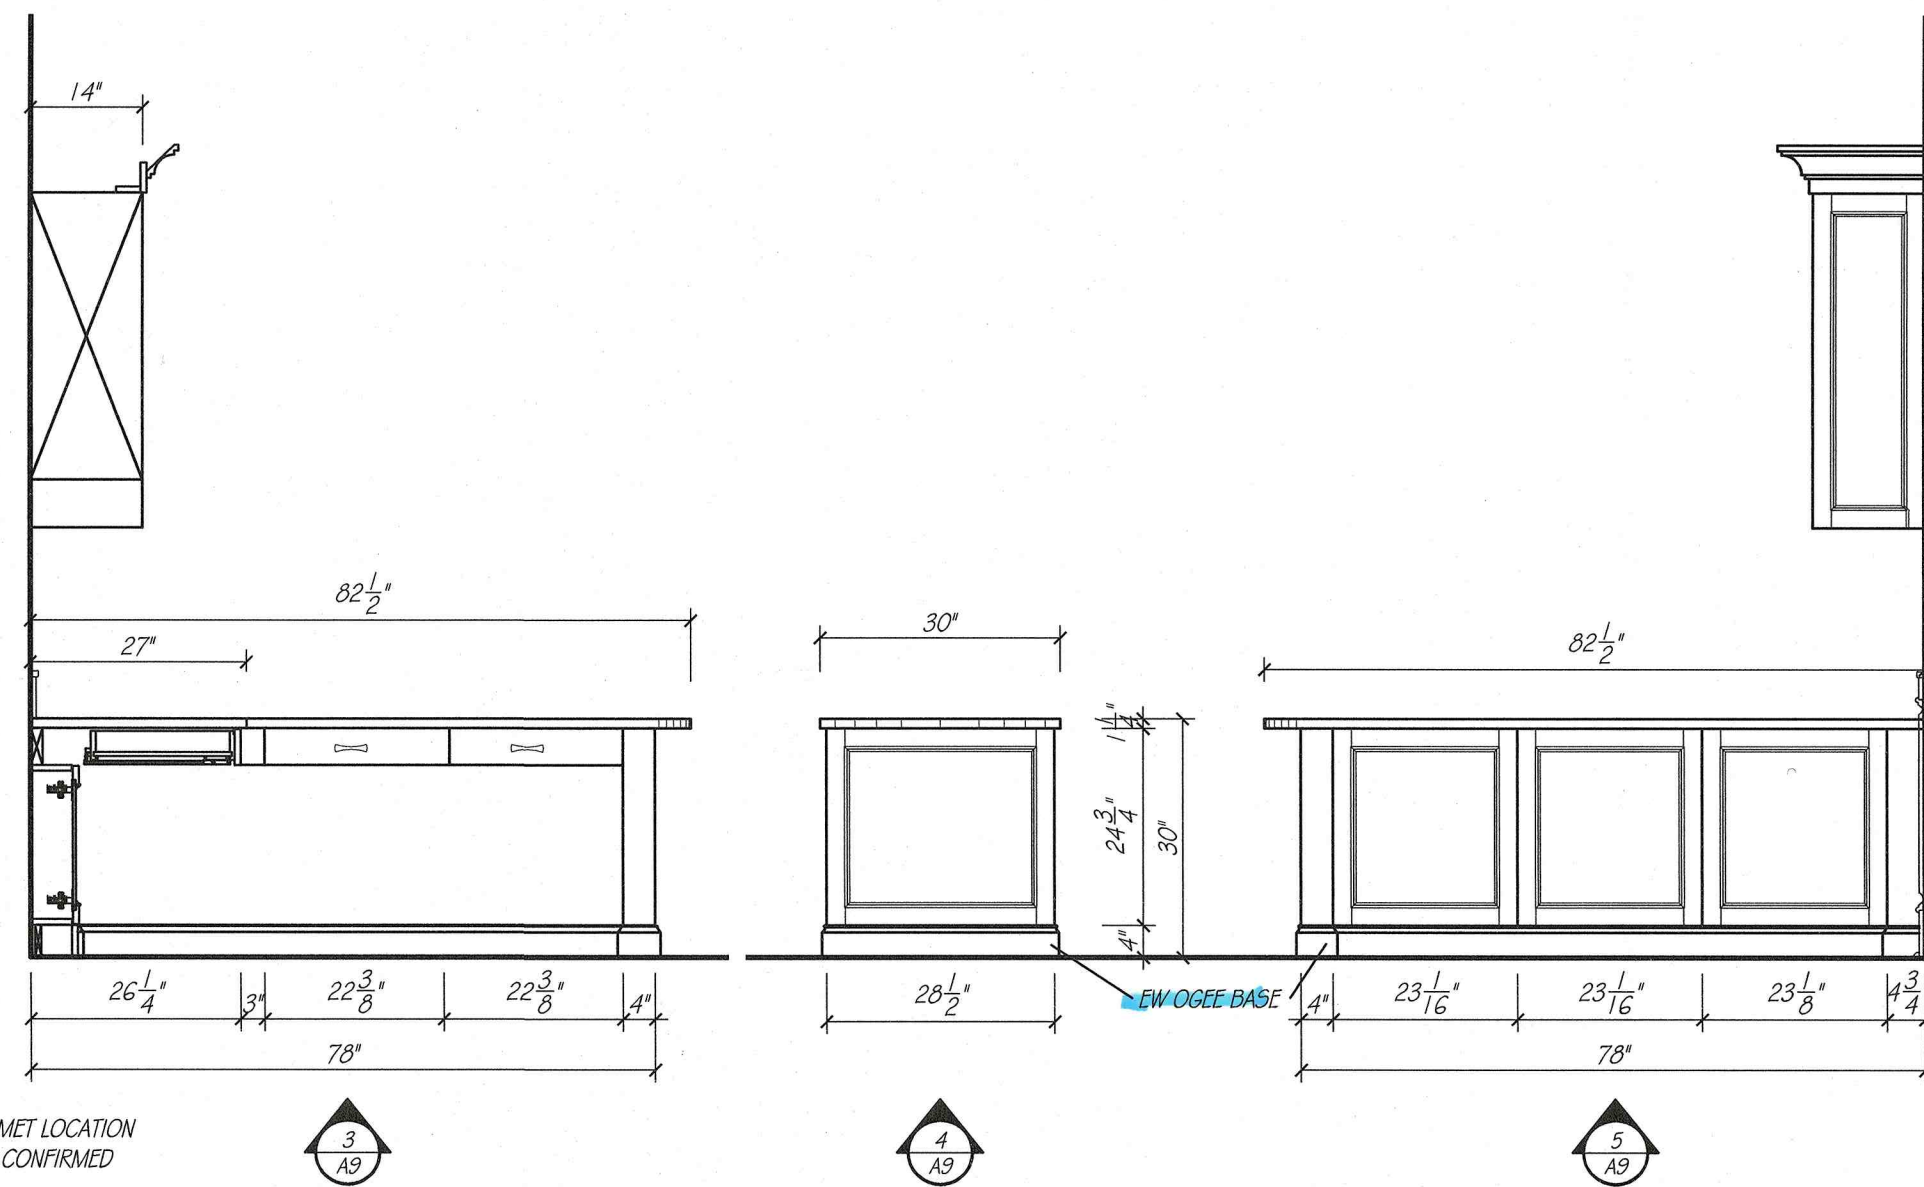


8 CABINET DETAIL
SCALE: 1 1/2\"/>

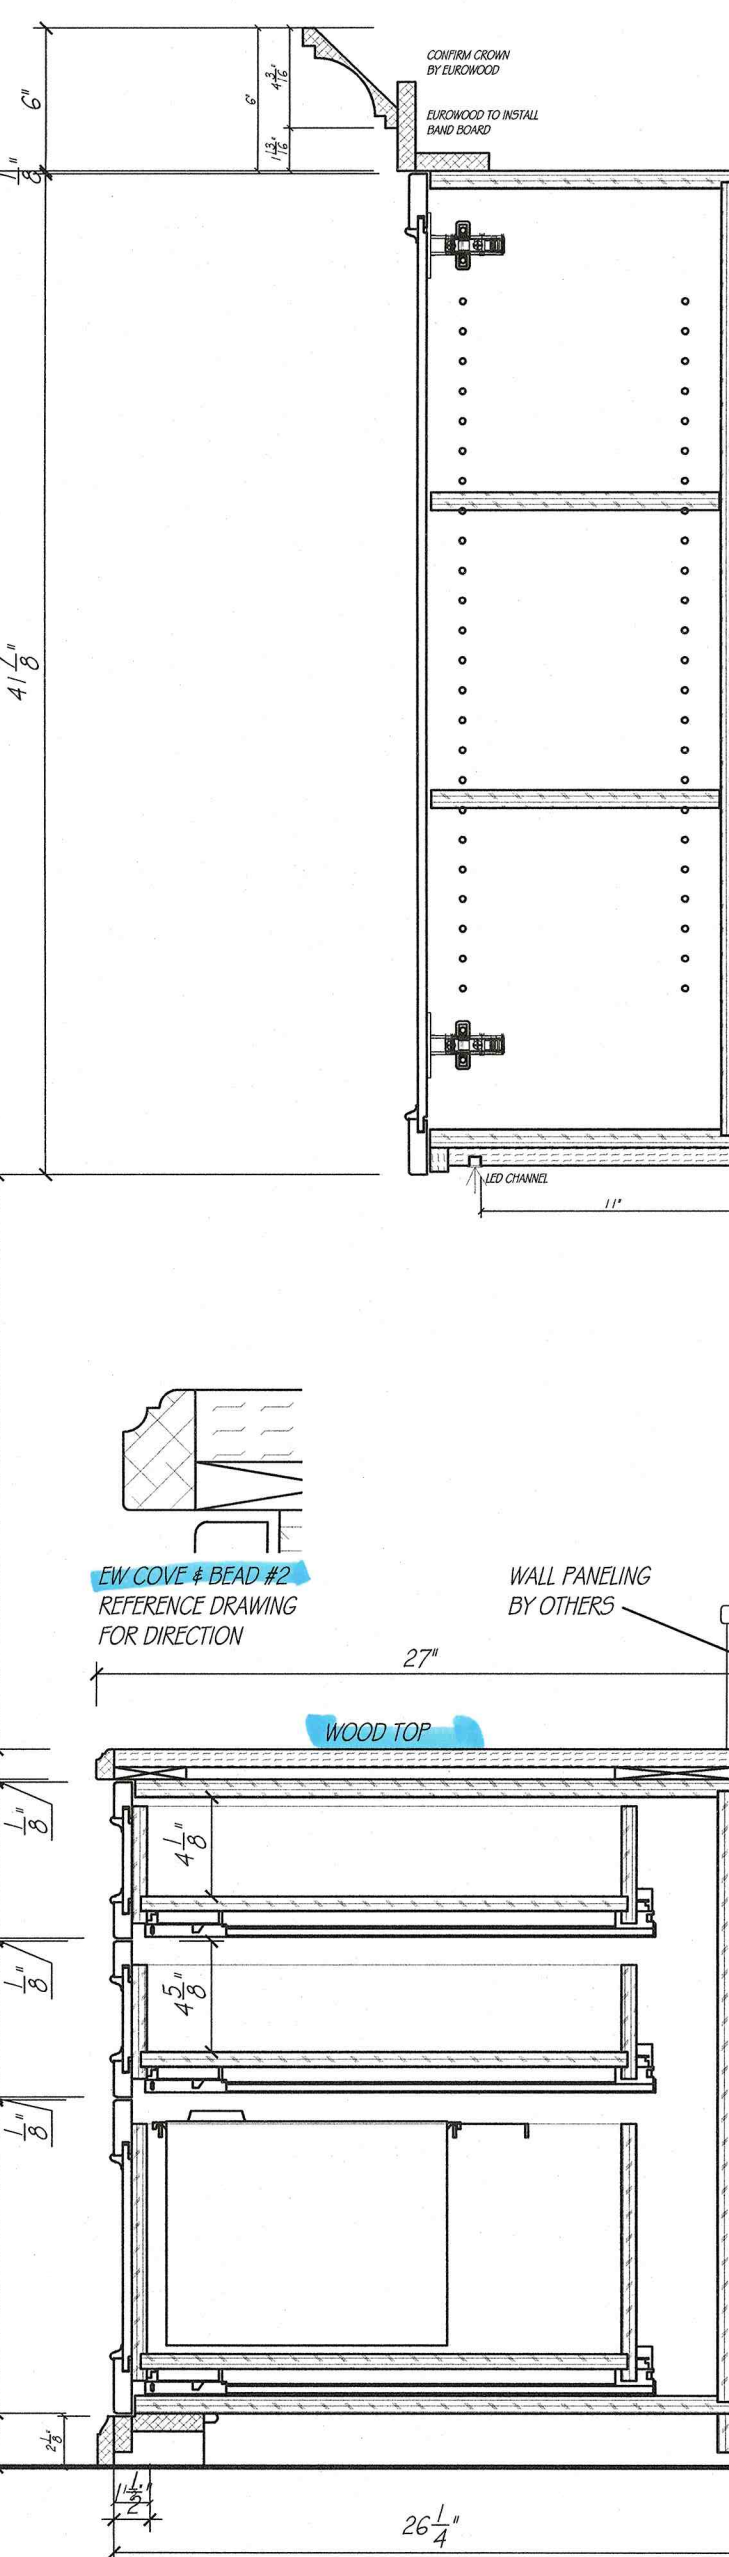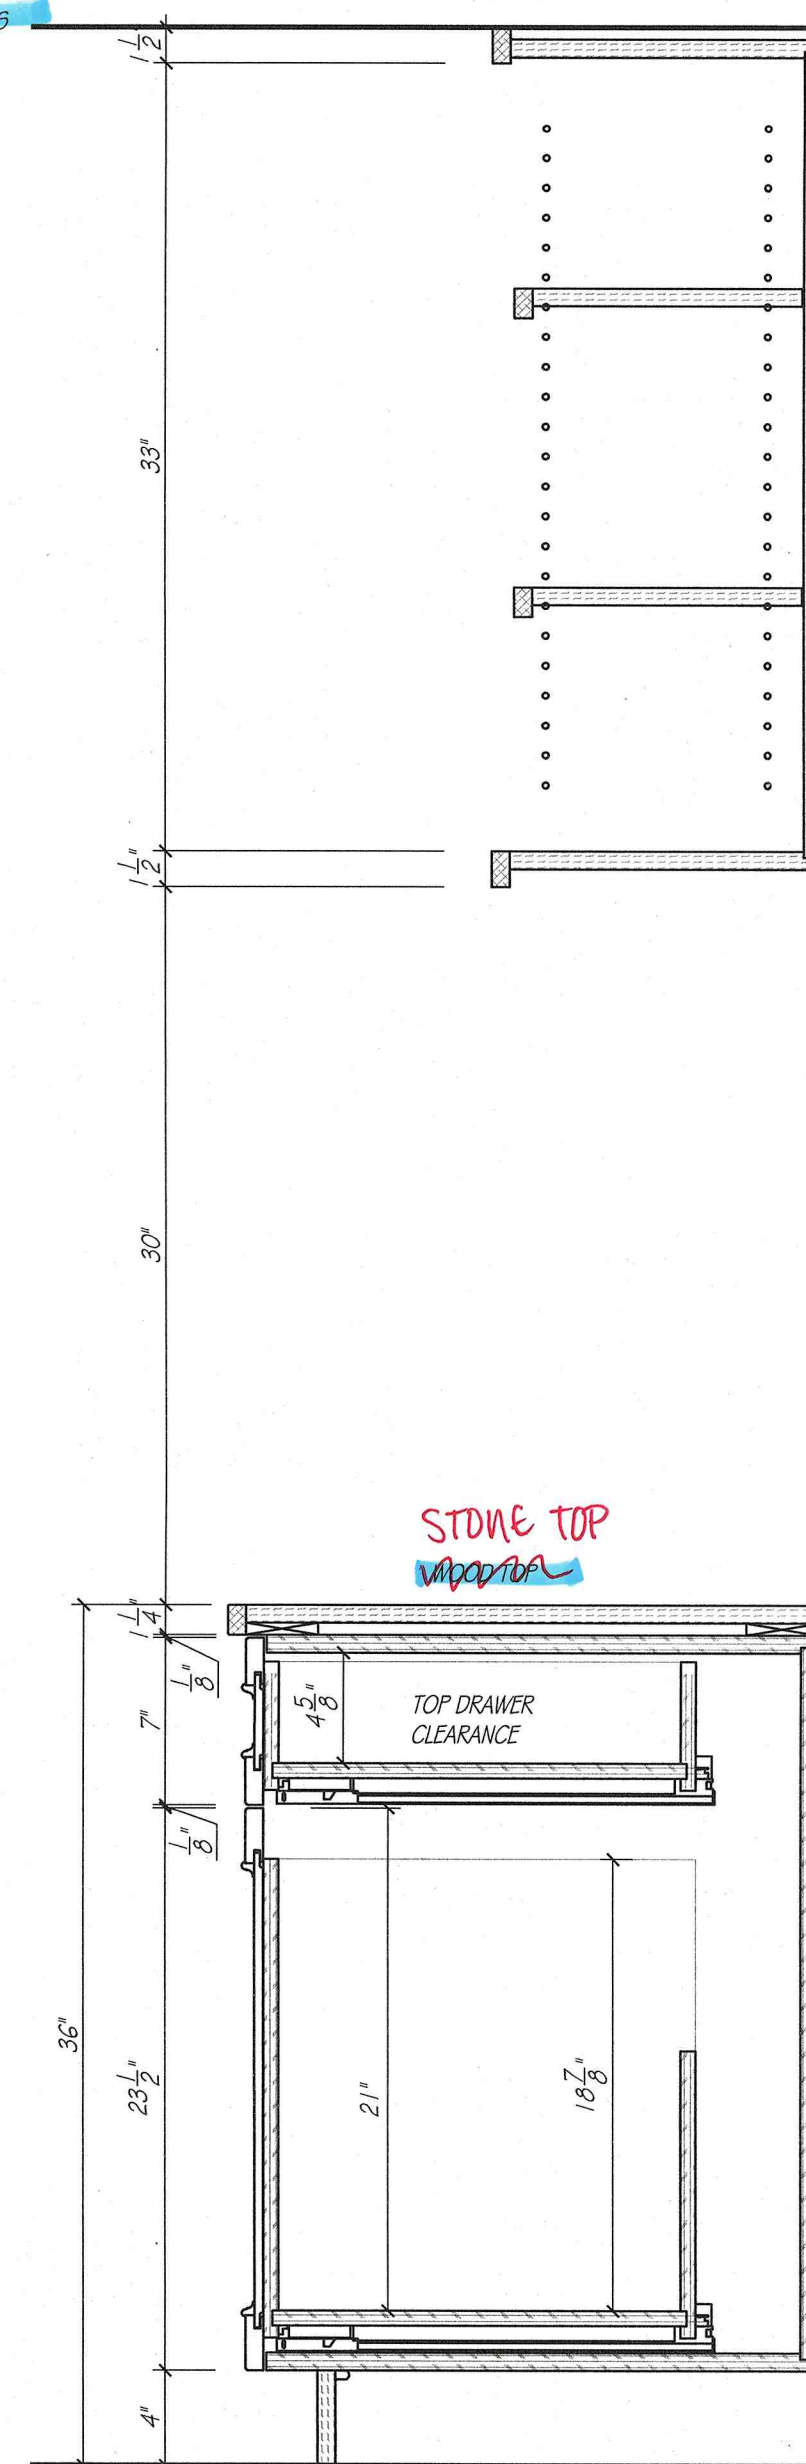


6 CABINET DETAIL
SCALE: 1 1/2\"/>


DEN	
CABINET CONSTRUCTION:	
EXTERIORS	PULL-OUT CHERRY
INTERIORS	HARD ROCK MAPLE MELAMINE
DRAWER BOXES	HARD ROCK MAPLE MELAMINE
FACE BANDING	MATCHING WOOD EDGE BANDING
CABINET HARDWARE & DRILLING	BY OTHERS
DRAWER SLIDE	PULL EXT. SOFT CLOSE CONCEALED SLIDE
COUNTERTOP SPECIFICATIONS:	
COUNTERTOP MATERIAL	WOOD & STONE
COUNTERTOP THICKNESS	1 1/4" ALLOWANCE
SUBTOP REQUIREMENTS	NONE
ROOM SPECIFICATIONS	
FLOORING - TYPE / ALLOWANCE	VERIFY 3/4" ALLOWANCE
CASING - W/ 1/4" REVEAL	3.34"

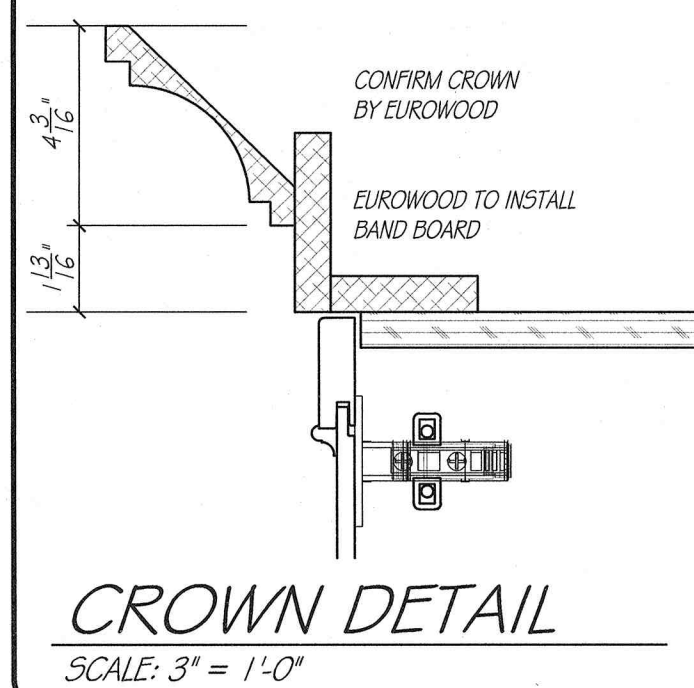


CROWN DETAIL
SCALE: 3\"/>

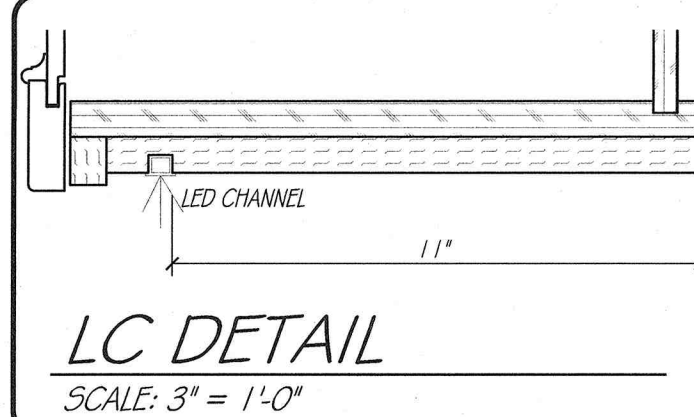

LC DETAIL
SCALE: 3\"/>

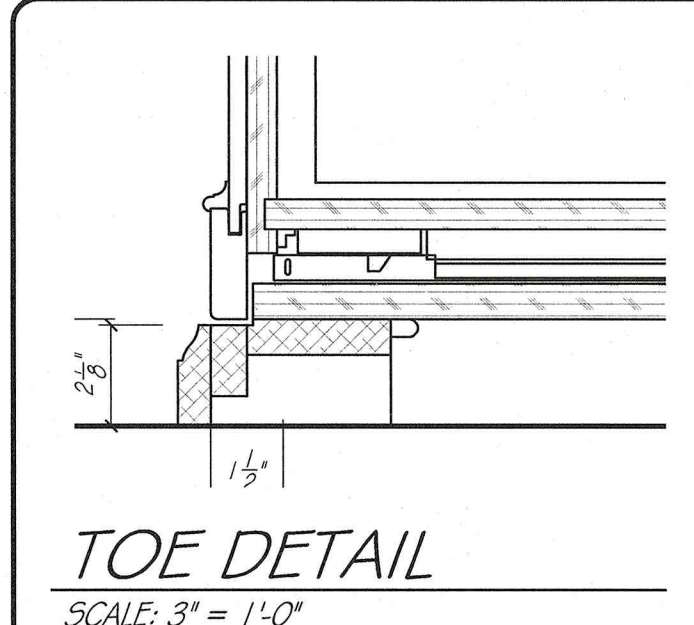

TOE DETAIL
SCALE: 3\"/>

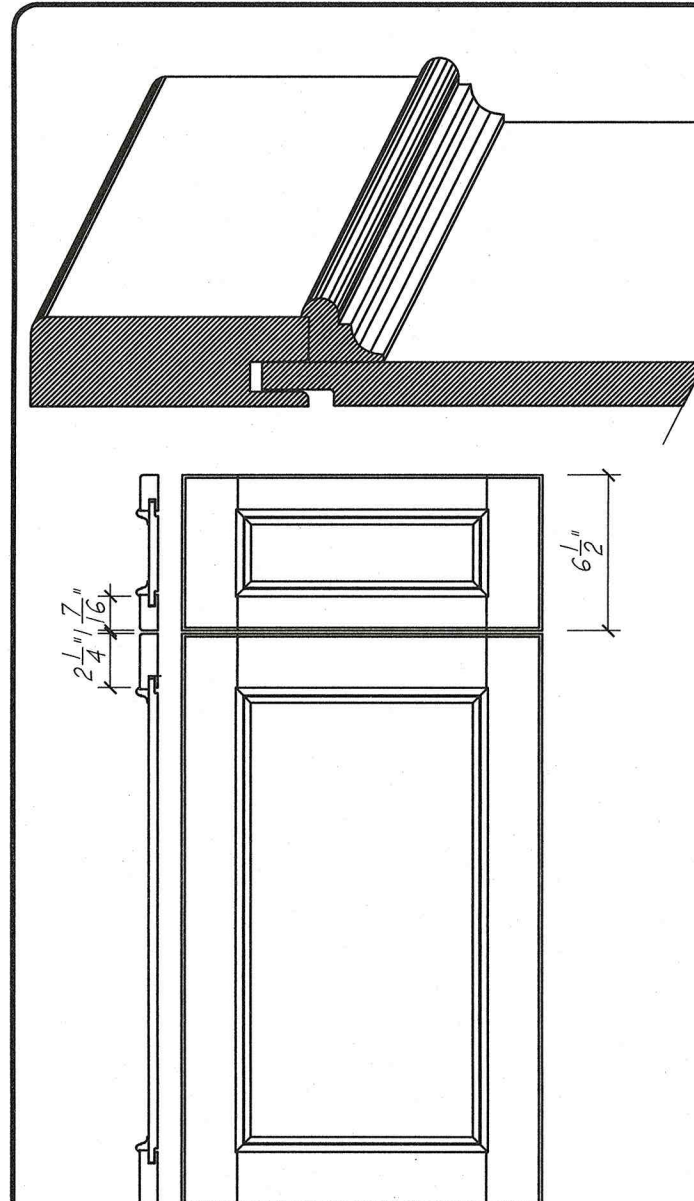


DOOR DETAIL
SCALE: 1 1/2\"/>




EUROWOOD
Cabinets INC.
3415 SO. 67TH ST.
OMAHA, NE 68106
TEL (402-393-4110)
FAX (402-393-8361)
(WWW.EUROWOOD.NET)

SHEET:	A9
DRAWN BY:	SJB
PLAN:	MAIN LEVEL
REVISIONS:	DEN
	20 MAY 26
	11 JUNE 26
	23 JUNE 26
	2 JULY 26
	8 JULY 26
	10 JULY 26
	24 JULY 26
	20 AUGUST 26
	27 AUGUST 26

PHIL & MICHELLE WOOD
3435 N. 140TH. CIRCLE
OMAHA, NE 68164

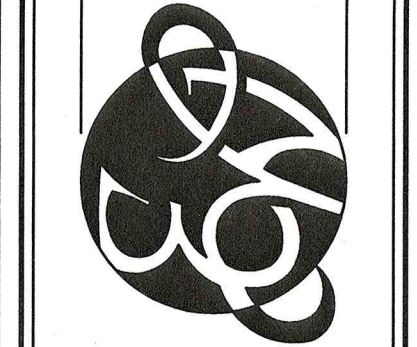

APPROVED BY:	
SIGNATURE	
DATE	
WOOD	
5588	

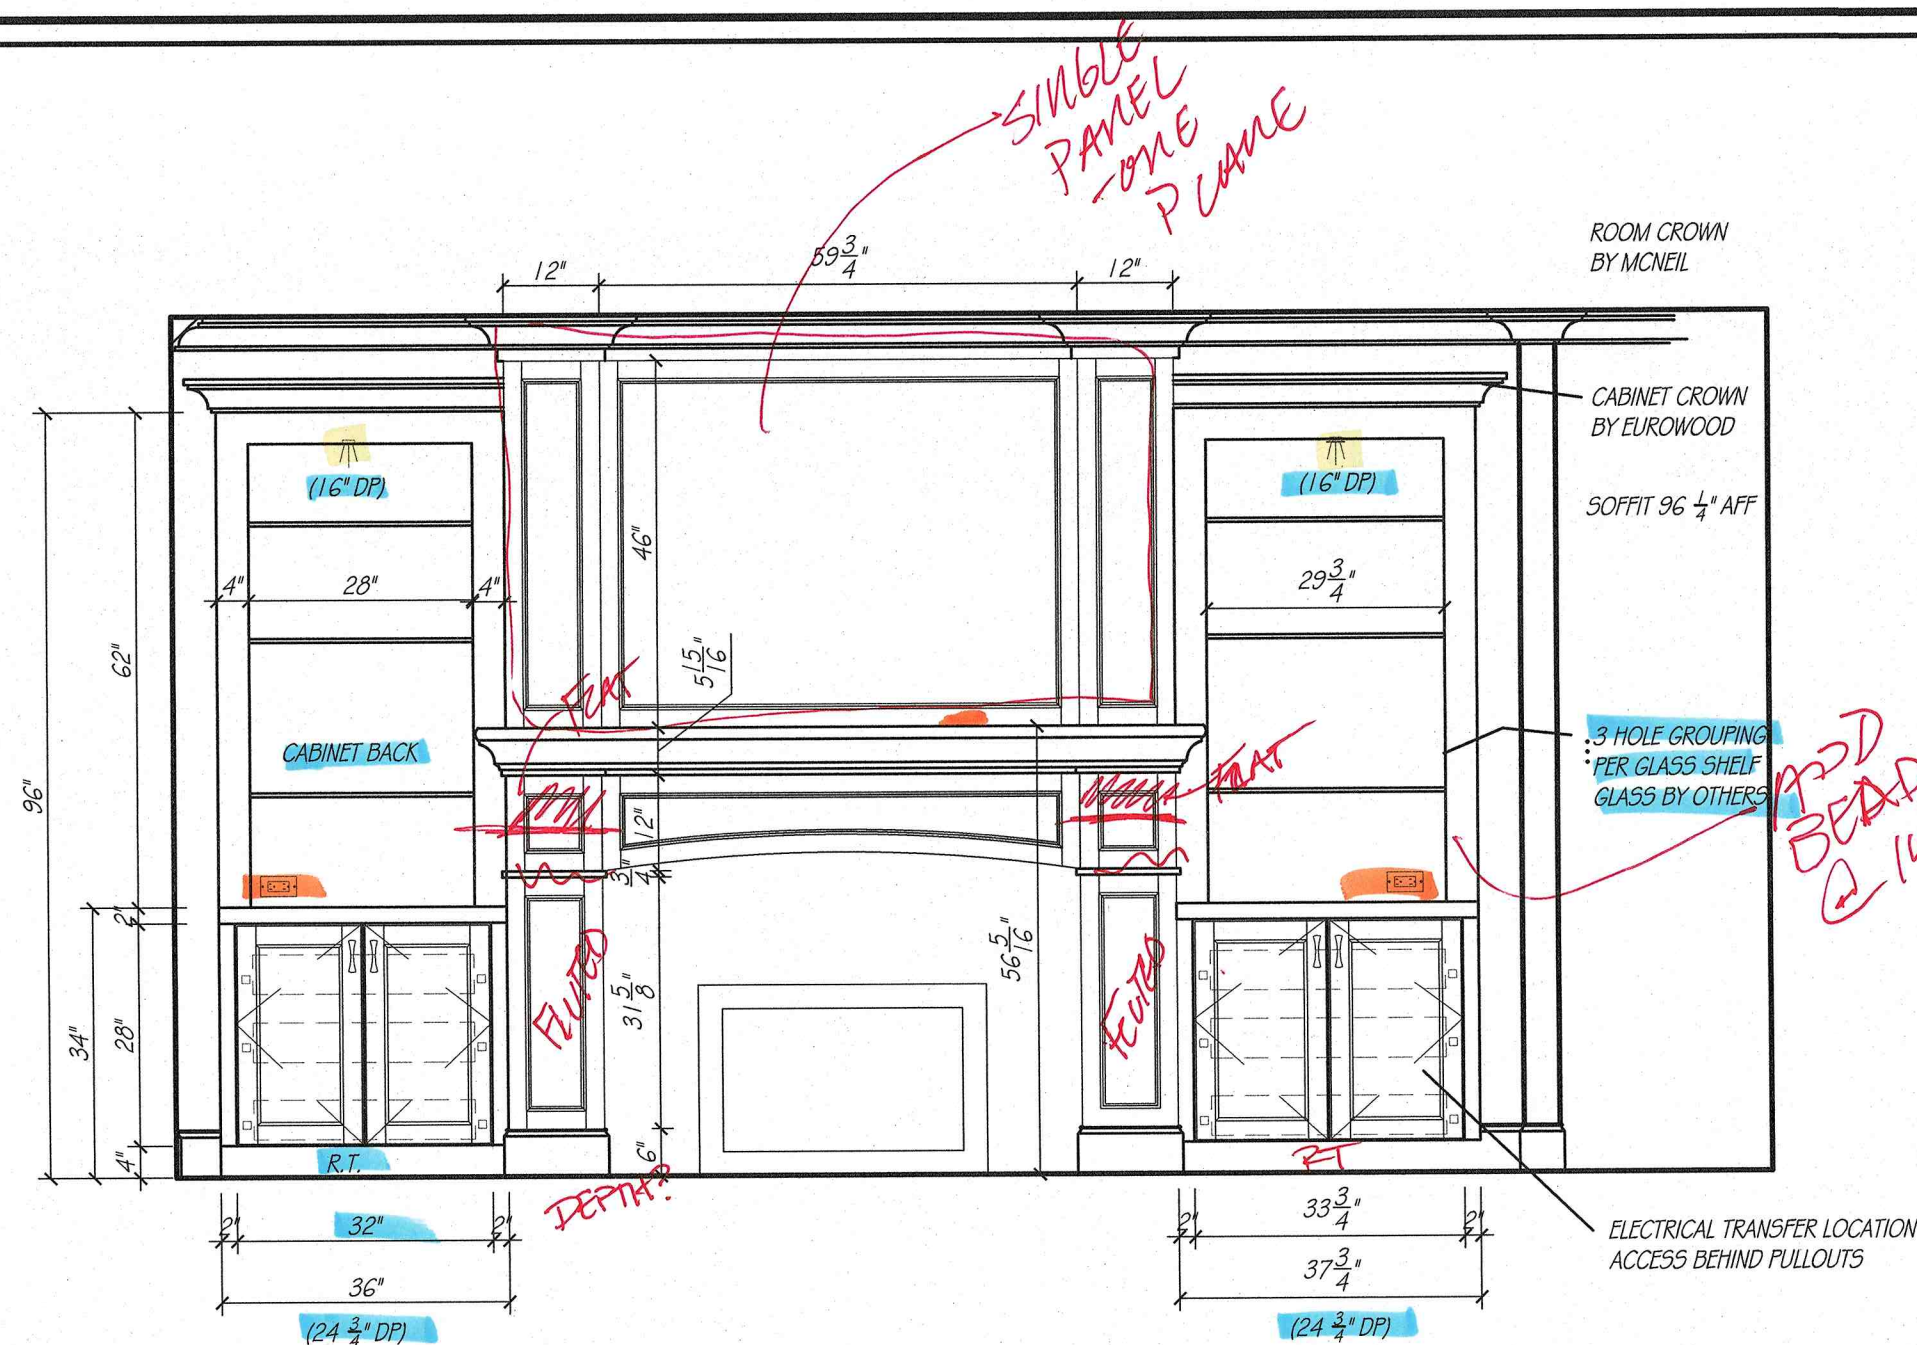

THOUGHTS

DOES THE TOP HAVE
BE ONE DEPTH WITH (3)
PANELS?


ADD DECORATIVE BEAD
AROUND DISPLAY "FULLER"?

NOT HAVE COLUMNS ABOVE
MOUNTABLE, JUST SIMPLE PANEL
WITH FRAME TV?

FRAME TV WITH
OVALATE GOLD FRAME


WIDTH = $63 \frac{9}{16}$ "
HEIGHT = $38 \frac{15}{16}$ "

COULD WE DO A LARGE
FRAMED BACK BOX THAT
HAS ARTICULATING MOUNT
THAT SITS INSIDE IT SO
TV CAN SIT FLUSH TO
PANEL?

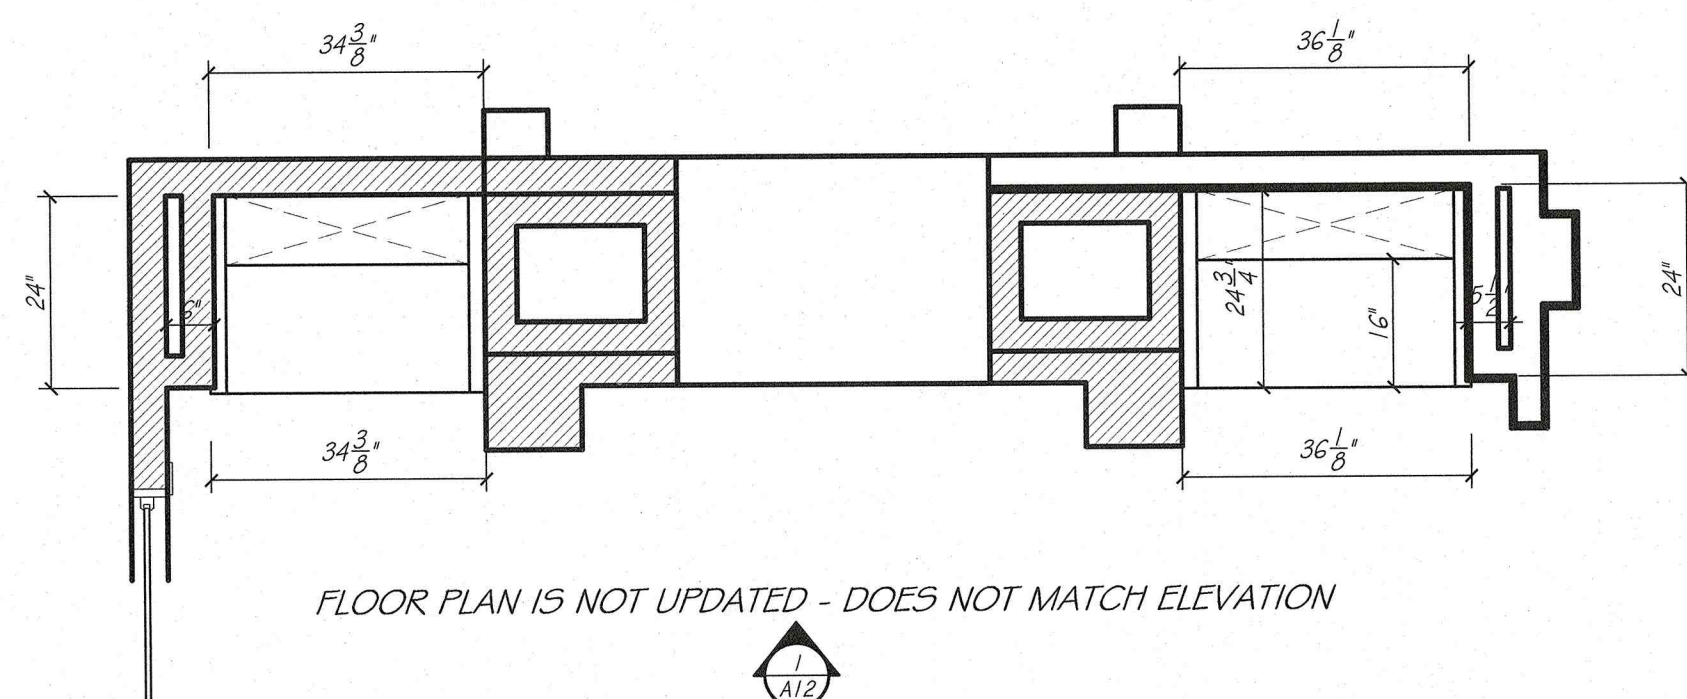

HEARTH ROOM

SCALE: 1/2" = 1'-0"

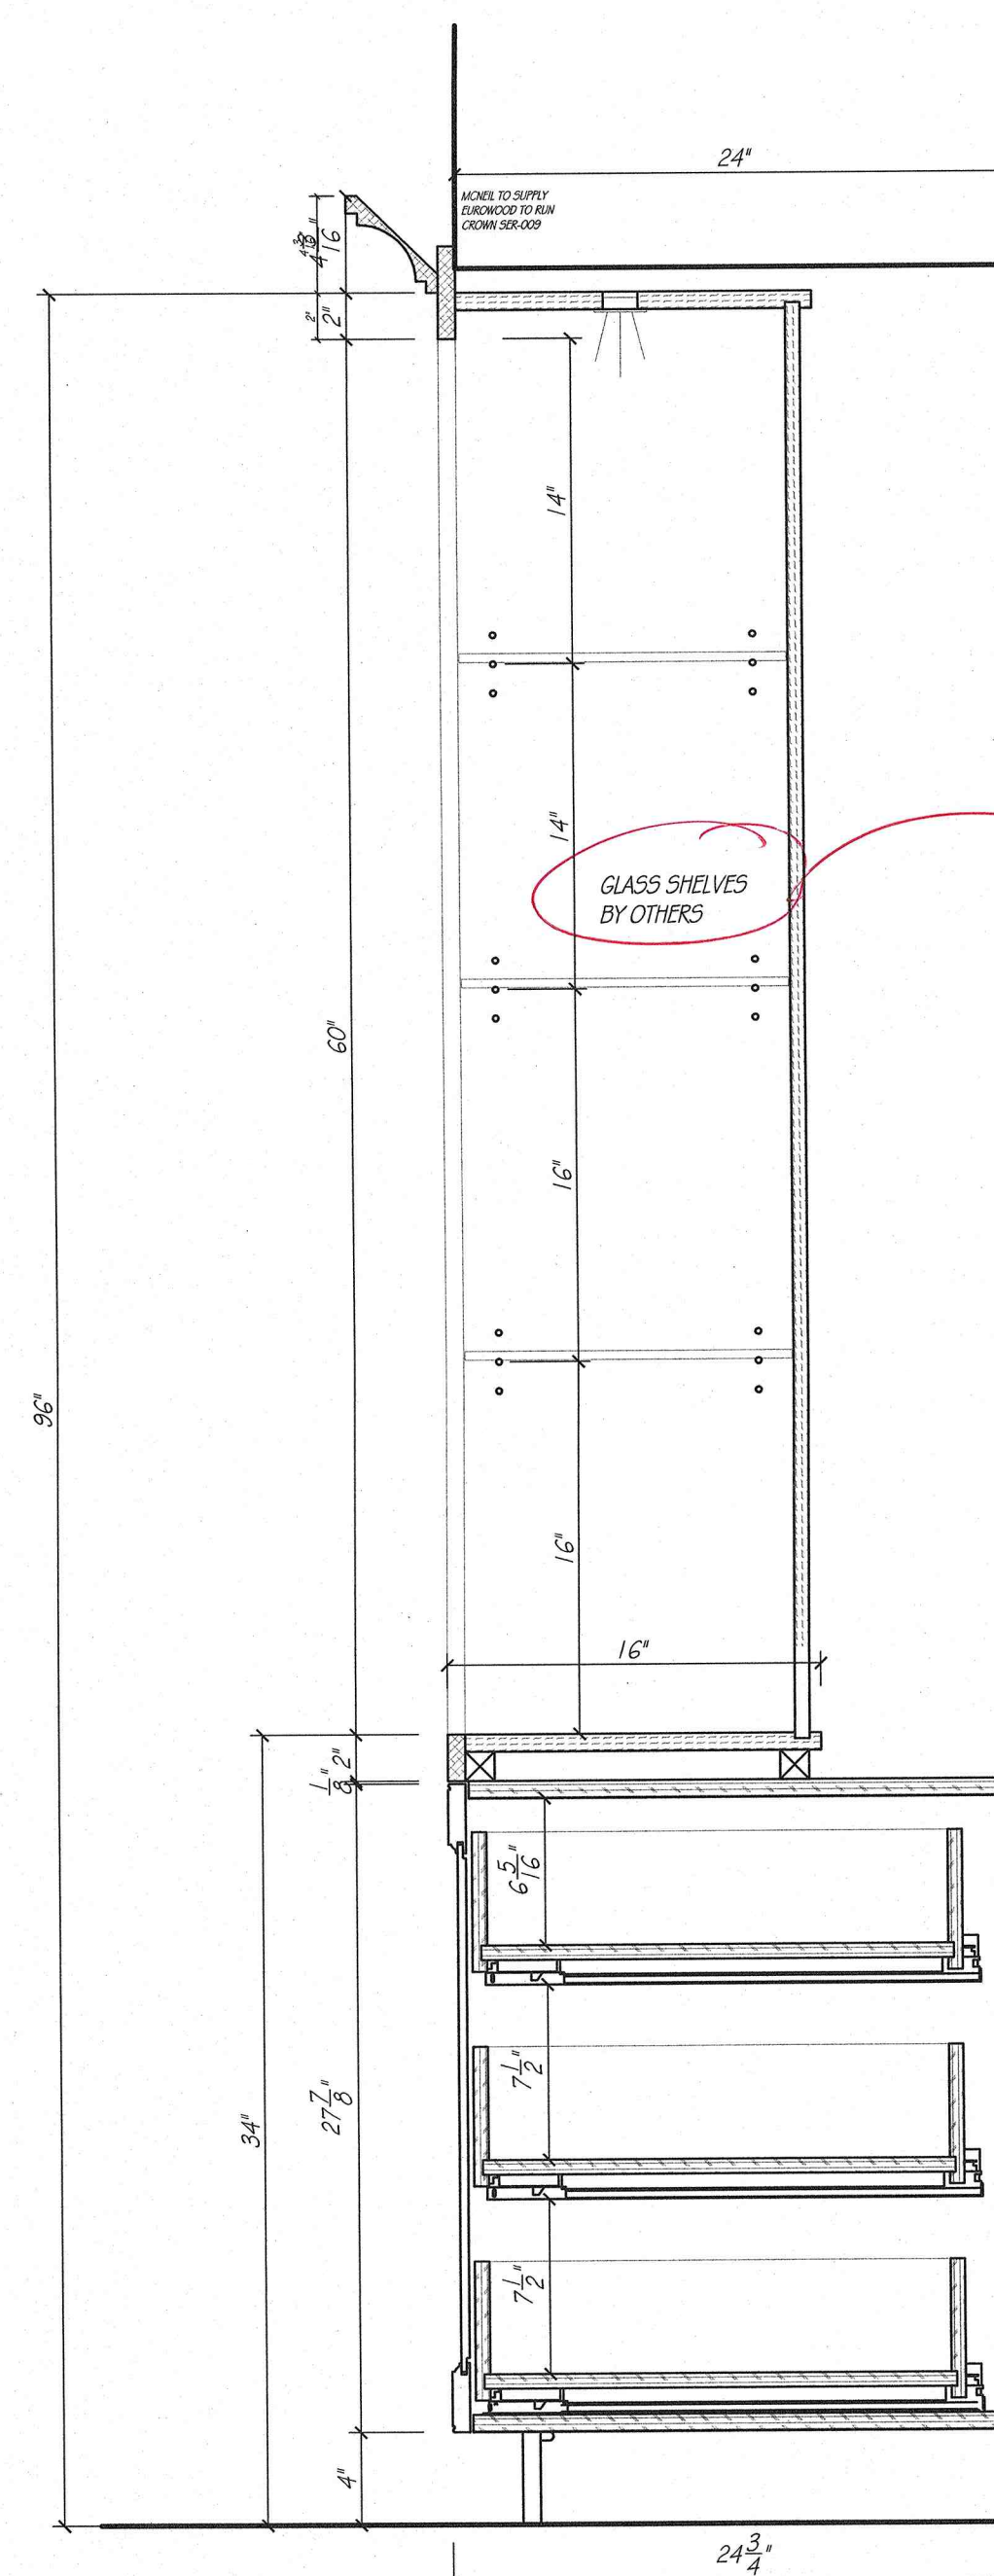

CABINET DETAIL

SCALE: 1 1/2" = 1'-0"

HEARTH ROOM

CABINET CONSTRUCTION:


EXTERIORS	PAINABLE
INTERIORS	HARD ROCK MAPLE MELAMINE
DRAWER BOXES	HARD ROCK MAPLE MELAMINE
FACE BANDING	MATCHING WOOD EDGE BANDING
CABINET HARDWARE & DRILLING	BY OTHERS
DRAWER SLIDE	FULL EXT. SOFT CLOSE CONCEALED SLIDES

COUNTERTOP SPECIFICATIONS:

COUNTERTOP MATERIAL	WOOD
COUNTERTOP THICKNESS	2"
SUBTOP REQUIREMENTS	STANDARD

ROOM SPECIFICATIONS

FLOORING - TYPE / ALLOWANCE	WOOD 1" ALLOWANCE
CASING W / 1/4" REVEAL	3.34"

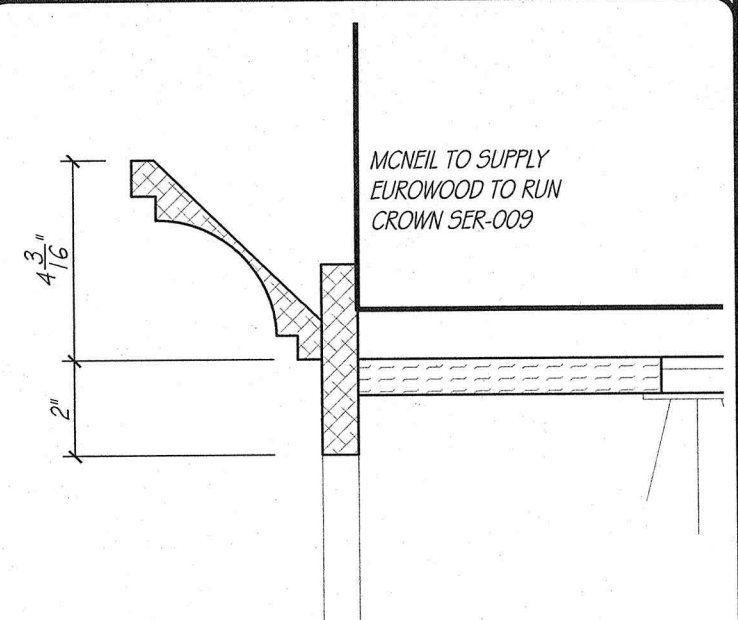


CROWN DETA.

NONE



LC DETAIL

SCALE: 3" = 1'-0"

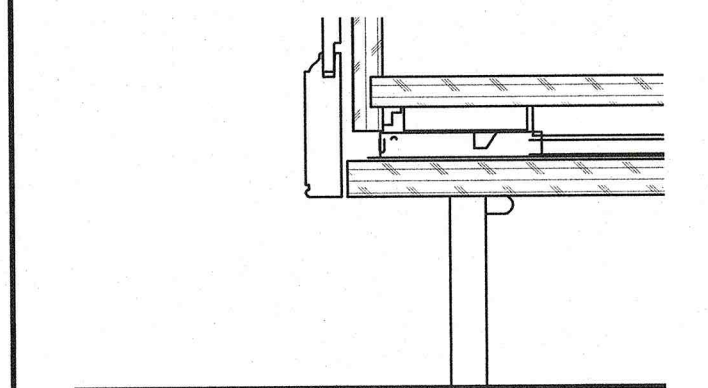

TOE DETAIL


SCALE: 3" = 1'-0"

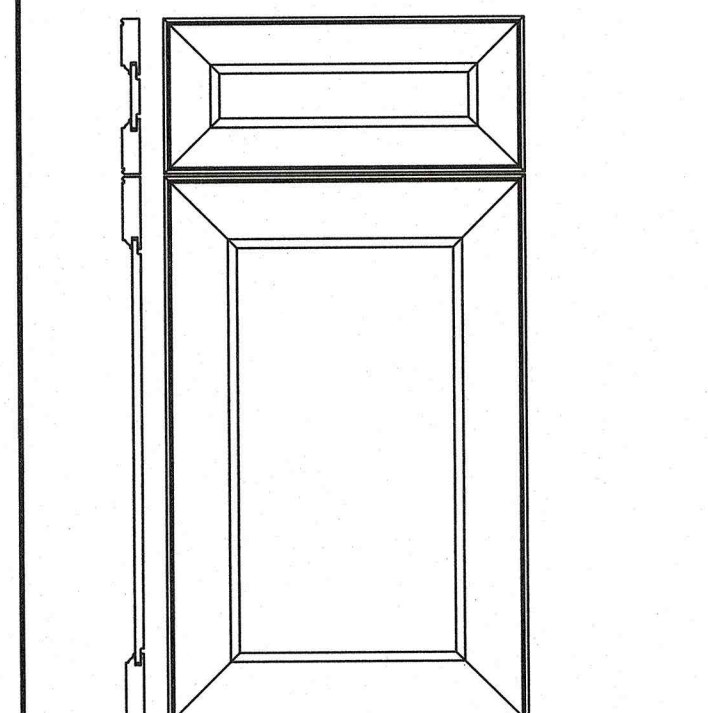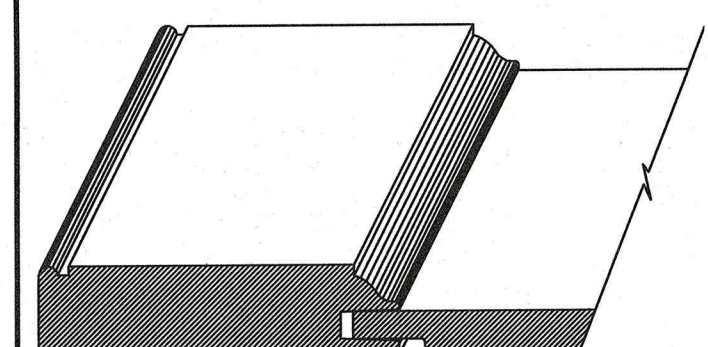

DOOR STYLE - MIDLAND (MODIFIED)
MITER CONSTRUCTION WITH 3" FRAMING
OUTSIDE EDGE - L-297 (BEAD)
INSIDE EDGE - DGE
CENTER PANEL - F-057

DOOR DETAIL

SCALE: 1 1/2" = 1'-0"

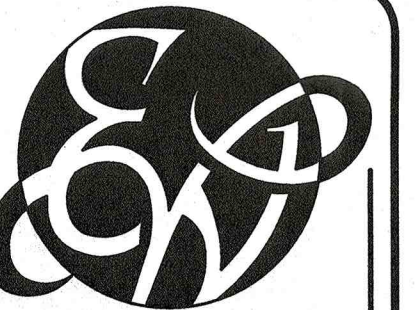

EUROWOOD

Cabinets Inc.

3415 SO. 67TH ST.
OMAHA, NE 68108

TEL (402-393-4110)

FAX (402-393-8361)

(WWW.EUROWOOD.NET)

SHEET: A13

DRAWN BY: SJB

PLAN: HEARTH ROOM

MAIN LEVEL

REVISIONS:

1 JUNE 26

11 JUNE 26





23 JUNE 26

2 JULY 26


8 JULY 26

24 JULY 26



27 AUGUST 26

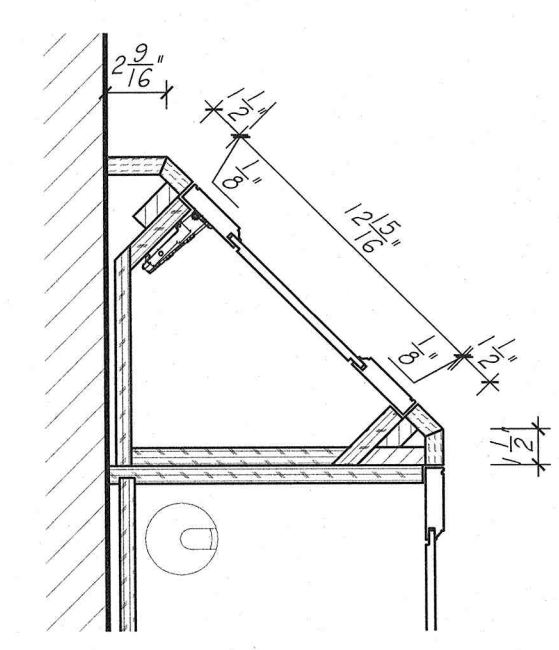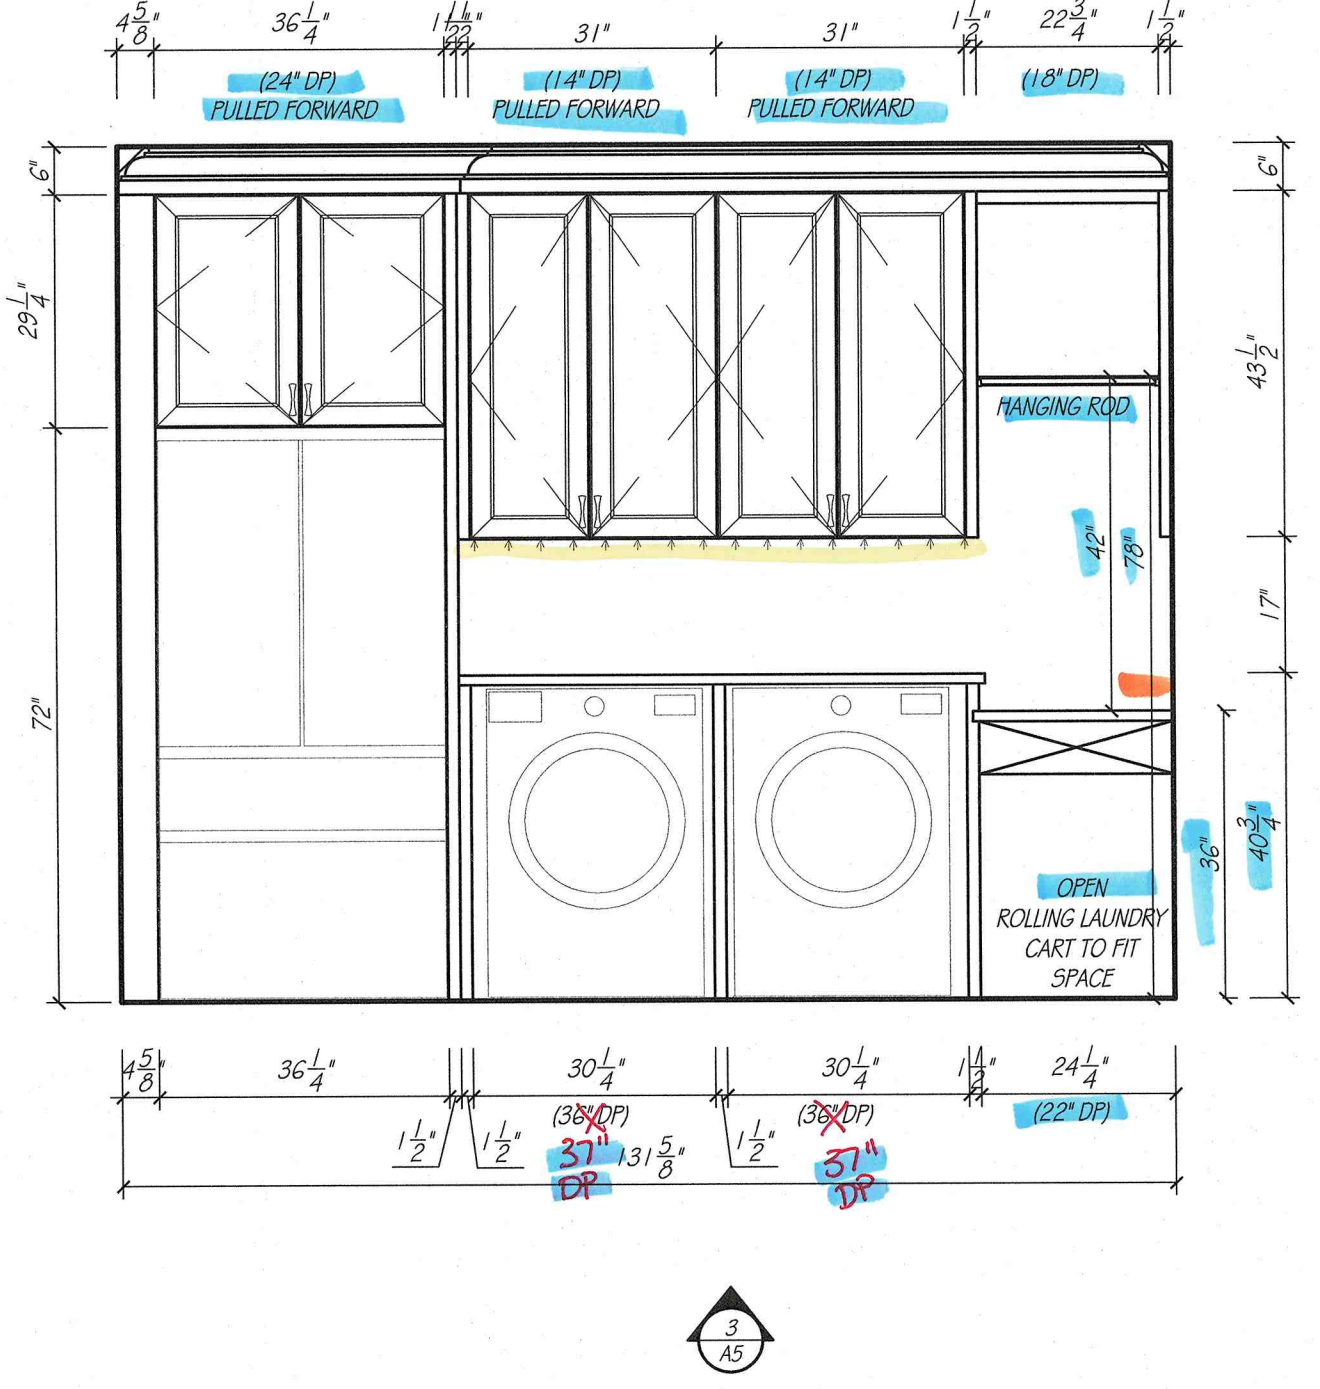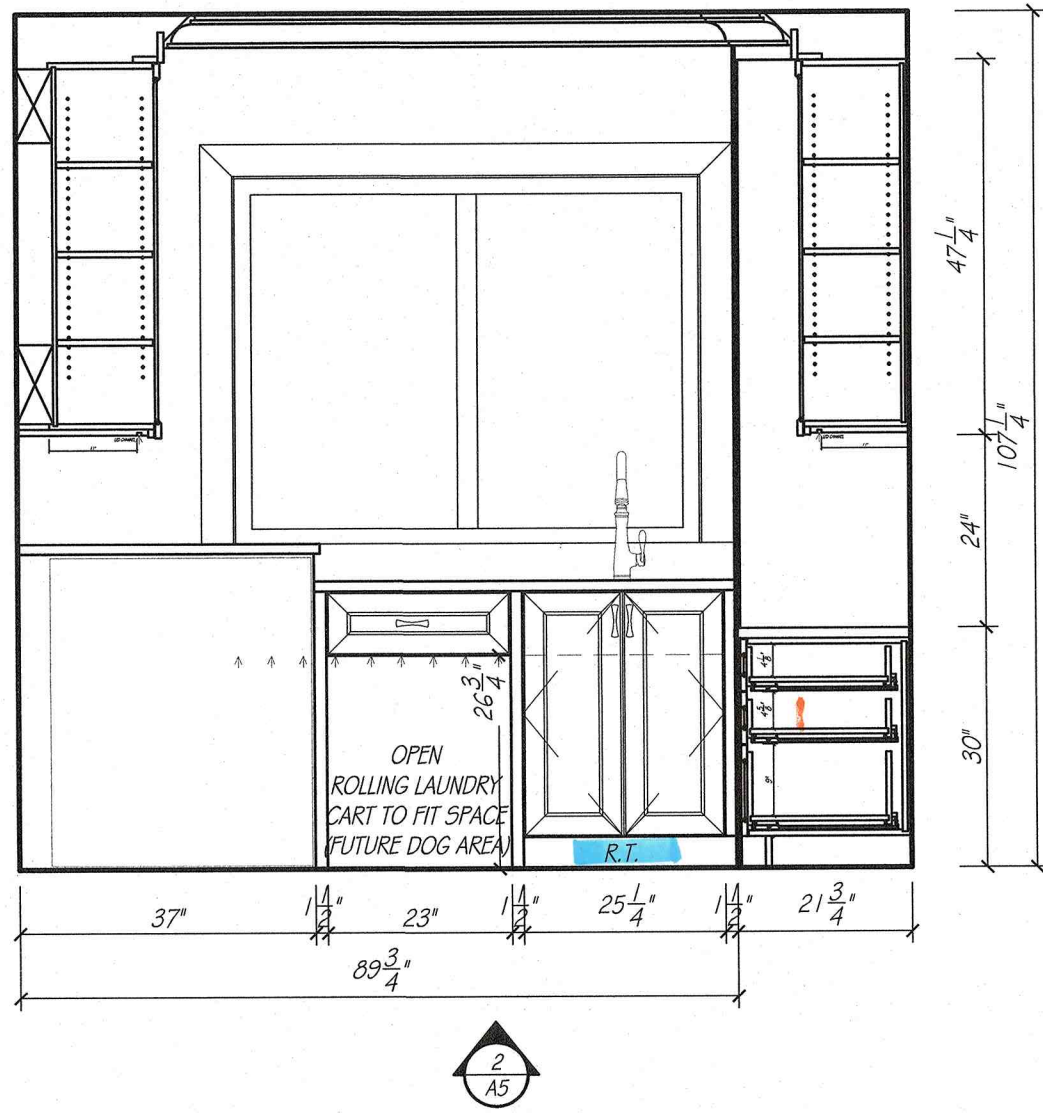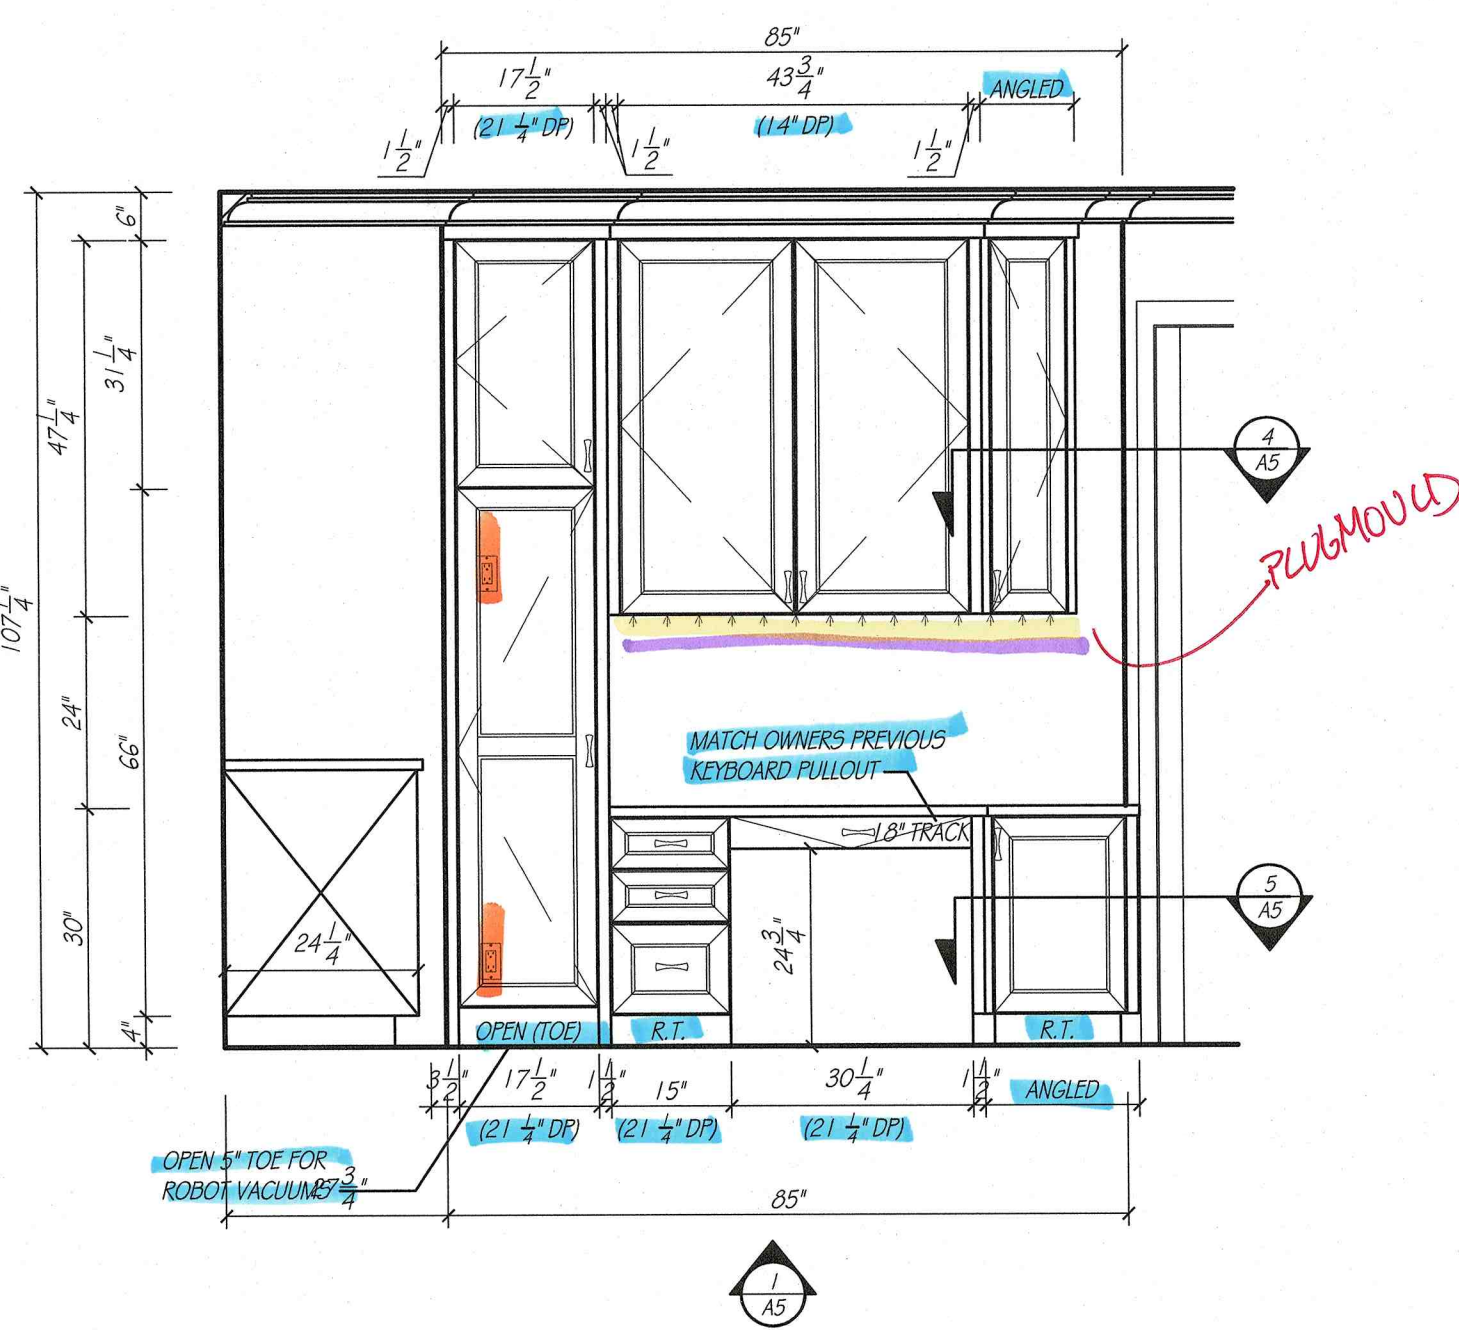


4 UPPER CABINET DETAIL
A5 SCALE: 1 1/2" = 1'-0"

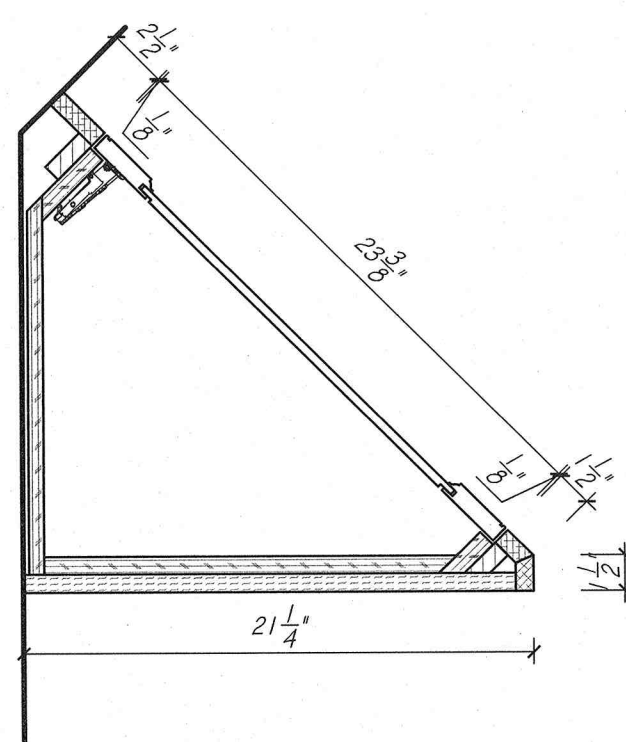

5 BASE CABINET DETAIL
A5 SCALE: 1 1/2" = 1'-0"

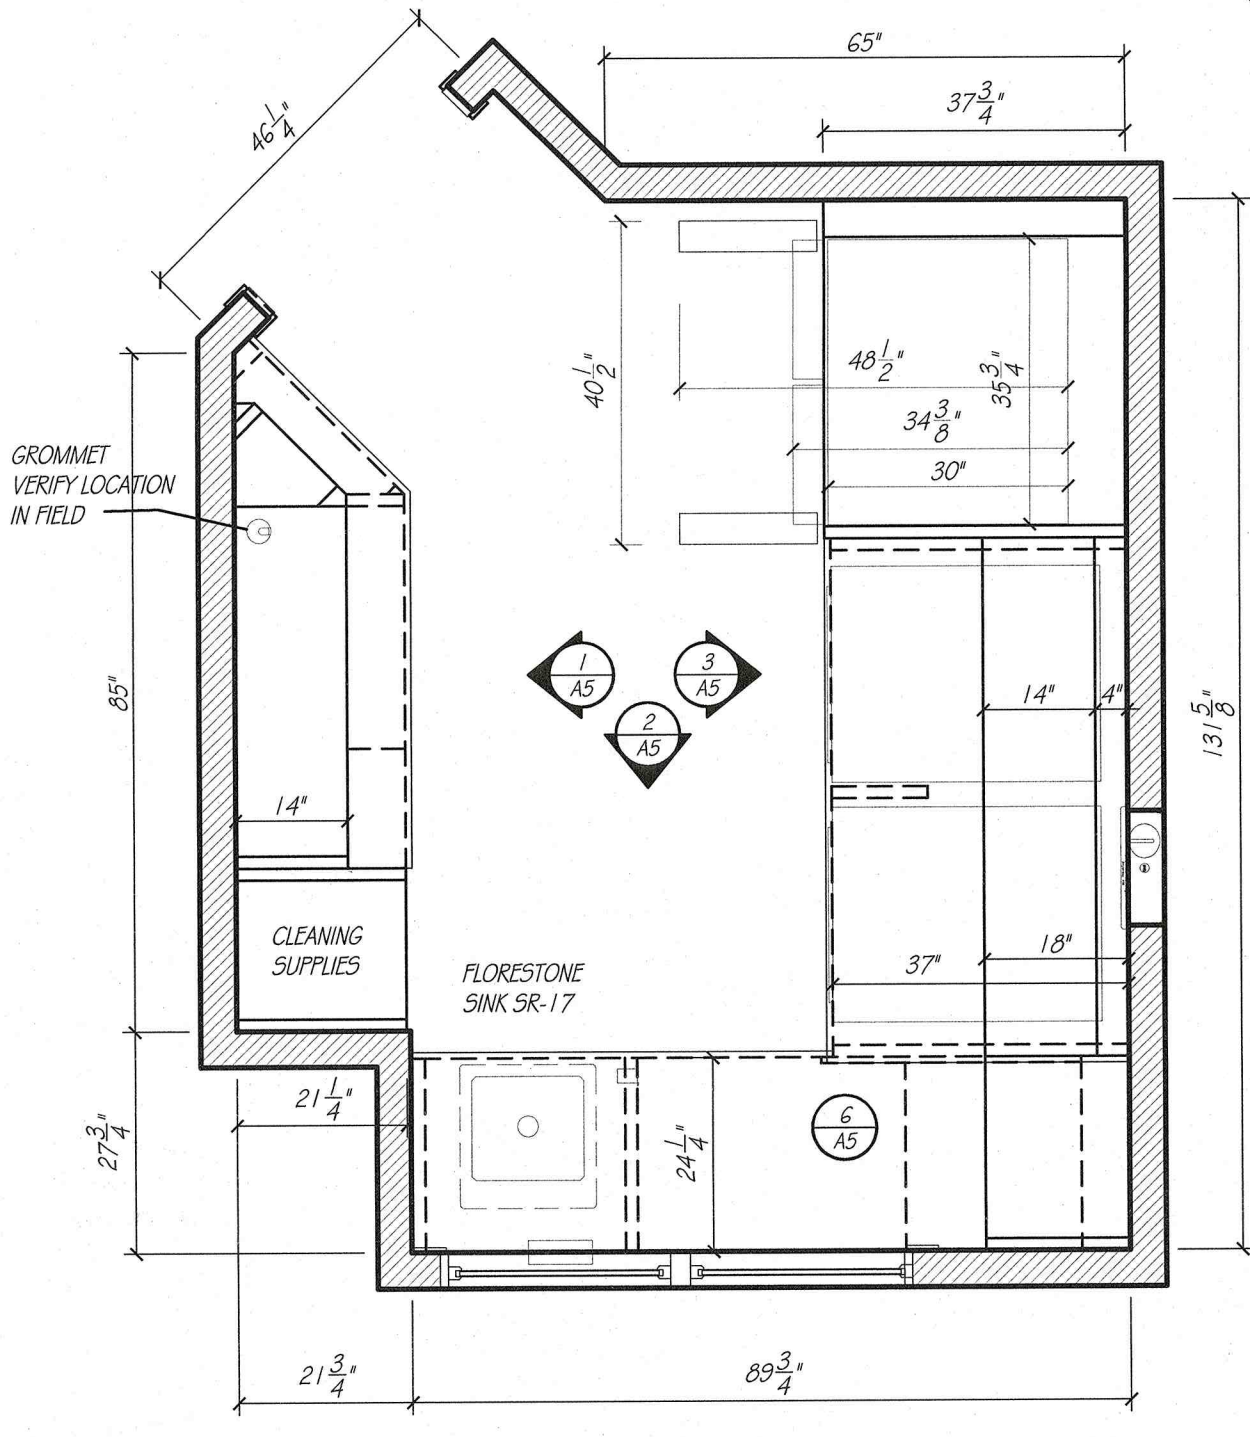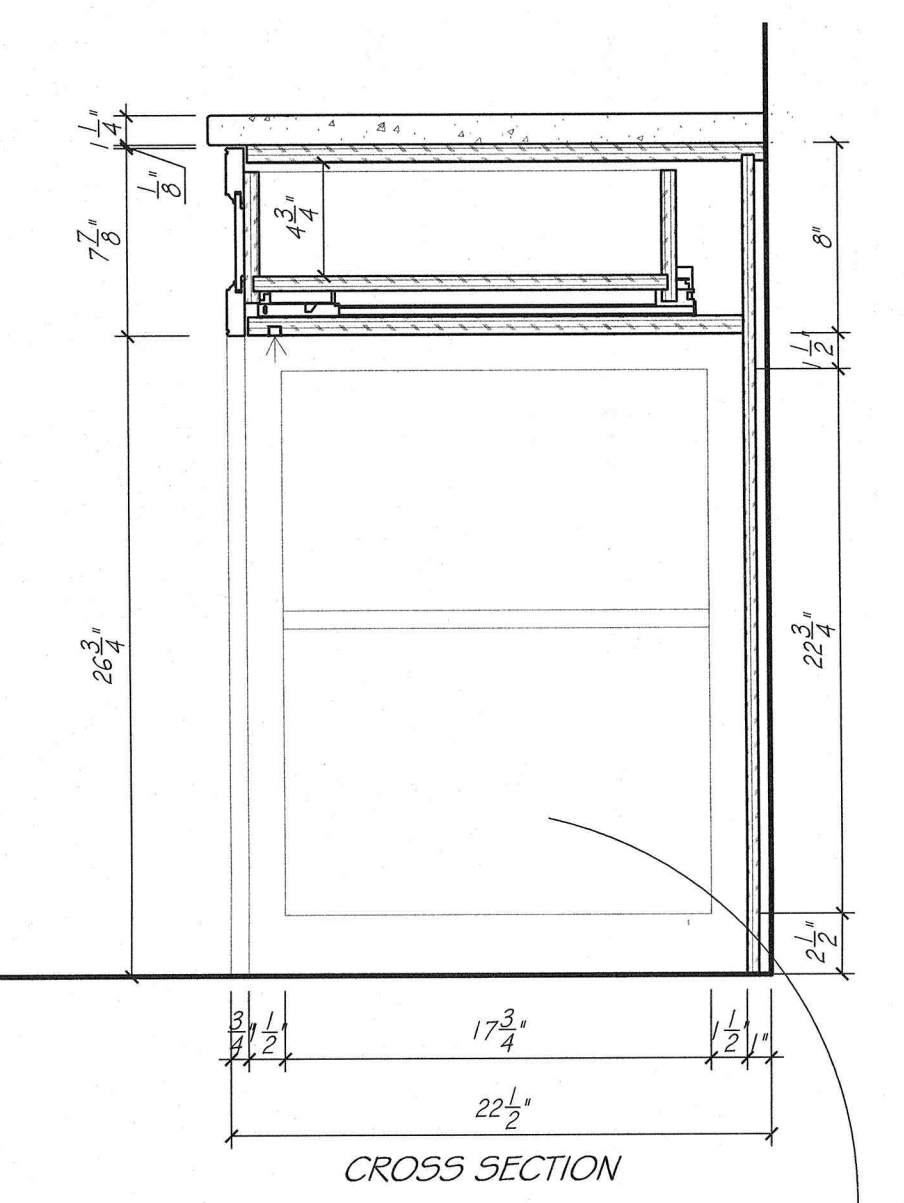






LAUNDRY
SCALE: 1/2" = 1'-0"

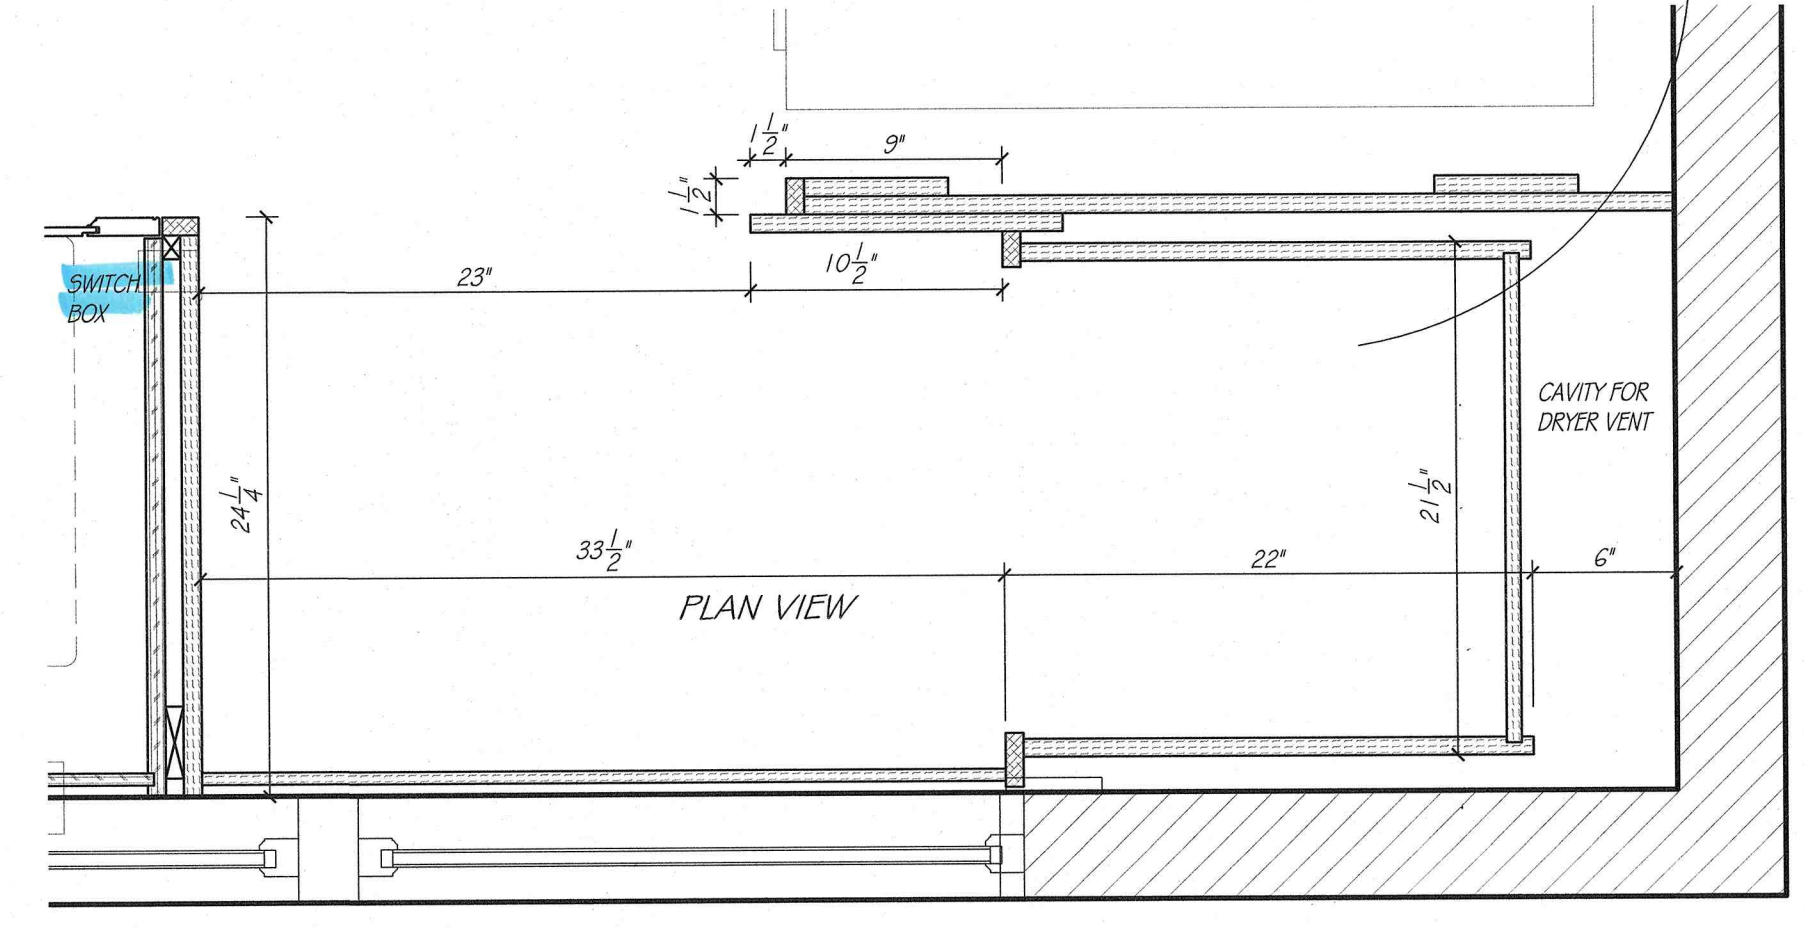

6 CABINET DETAIL
A5 SCALE: 1 1/2" = 1'-0"

ACCESSORIES


LAUNDRY	
CABINET CONSTRUCTION:	
INTERIORS	PAINABLE
INTERIORS	HARD ROCK MAPLE MELAMINE
DRAWER BOARDS	HARD ROCK MAPLE MELAMINE
FACE BANDING	MATCHING WOOD EDGE BANDING
CABINET HARDWARE & DRILLING	BY OTHERS
DRAWER SLIDE	FULL EXT. SOFT CLOSE CONCEALED SLIDES
COUNTERTOP SPECIFICATIONS:	
COUNTERTOP MATERIAL	QUARTZ
COUNTERTOP THICKNESS	1 1/2" ALLOWANCE
SUBTOP REQUIREMENTS	NONE
ROOM SPECIFICATIONS	
FLOORING - TYPE / ALLOWANCE	VERIFY 3/4" ALLOWANCE
CASING W/ 1/4" REVEAL	3/4"

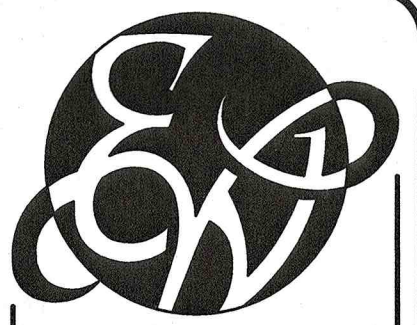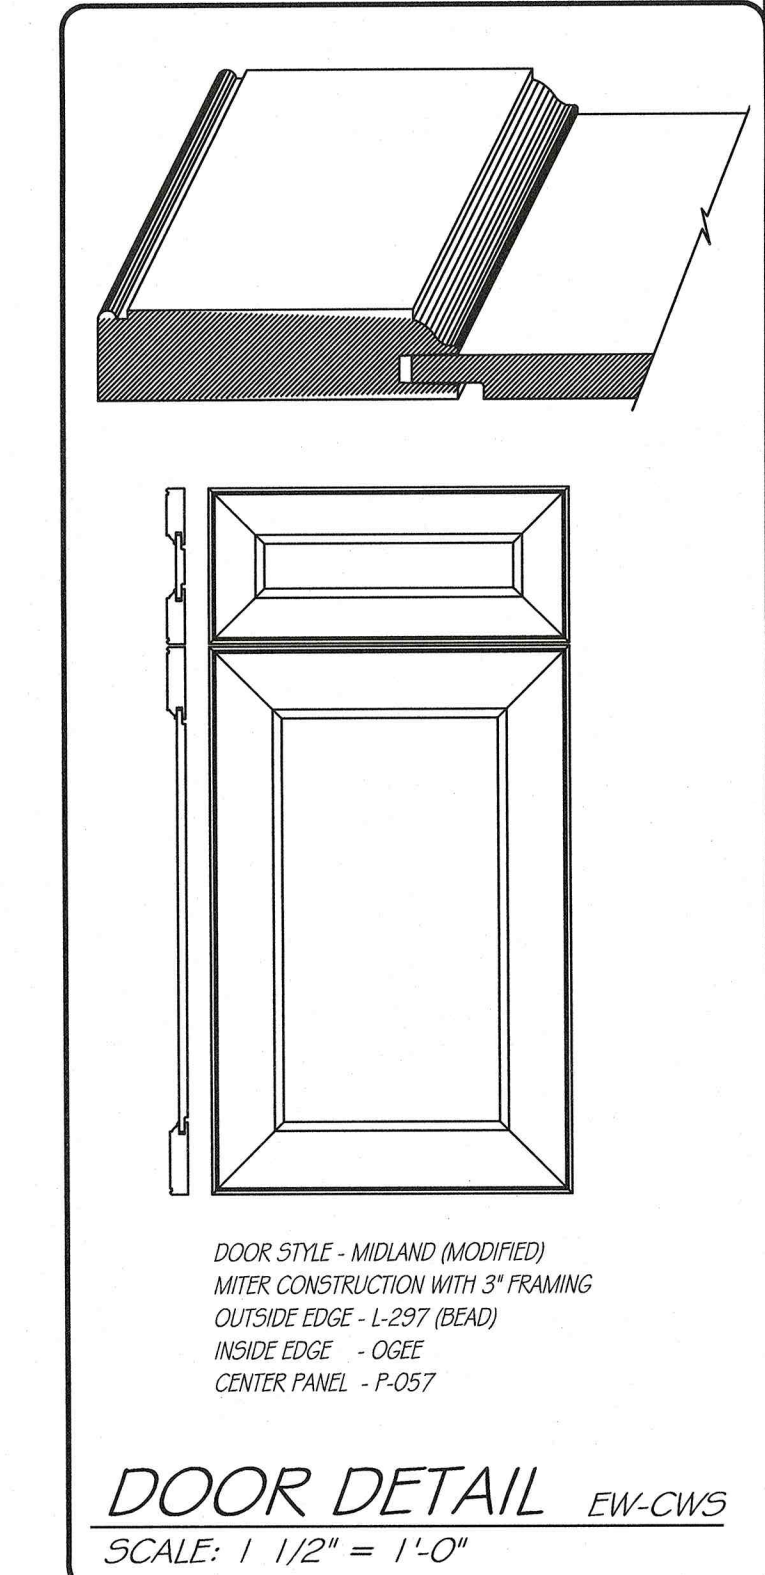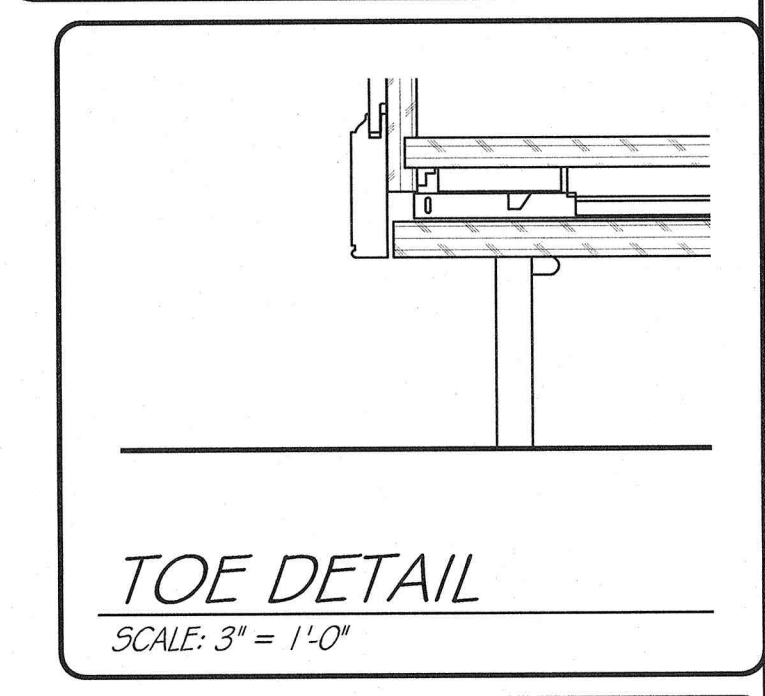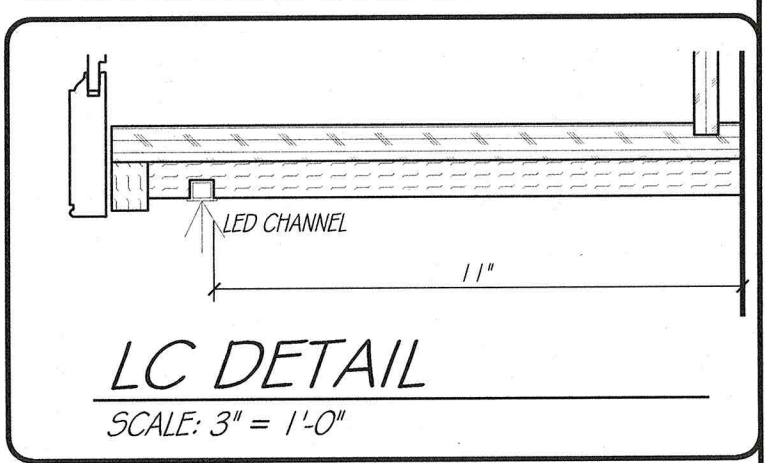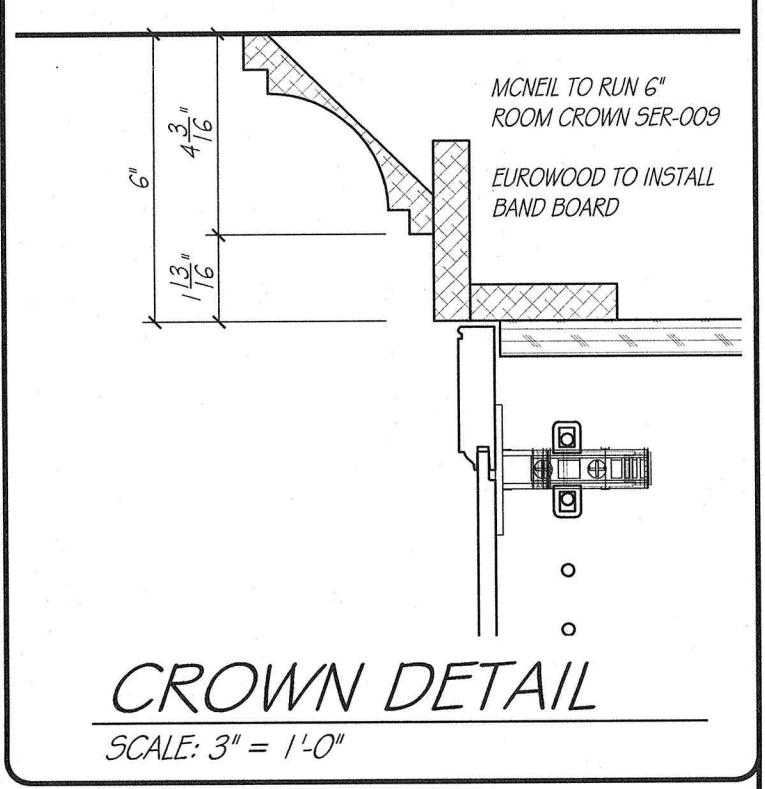









EUROWOOD
Cabinets INC.
3415 SO. 67TH ST.
OMAHA, NE 68108
TEL (402-393-4110)
FAX (402-393-8361)
(WWW.EUROWOOD.NET)

SHEET: A5
DRAWN BY: SJB
PLAN: MAIN LEVEL
LAUNDRY
REVISIONS:
2 MAY 26
11 JUNE 26
23 JUNE 26
2 JULY 26
8 JULY 26
24 JULY 26
27 AUGUST 26

PHIL & MICHELLE WOOD
3435 N. 140TH. CIRCLE
OMAHA, NE 68164

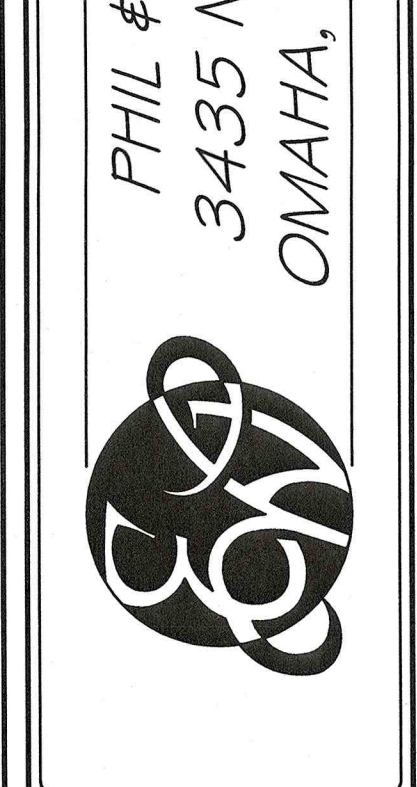

APPROVED BY:
SIGNATURE
DATE
WOOD
5588

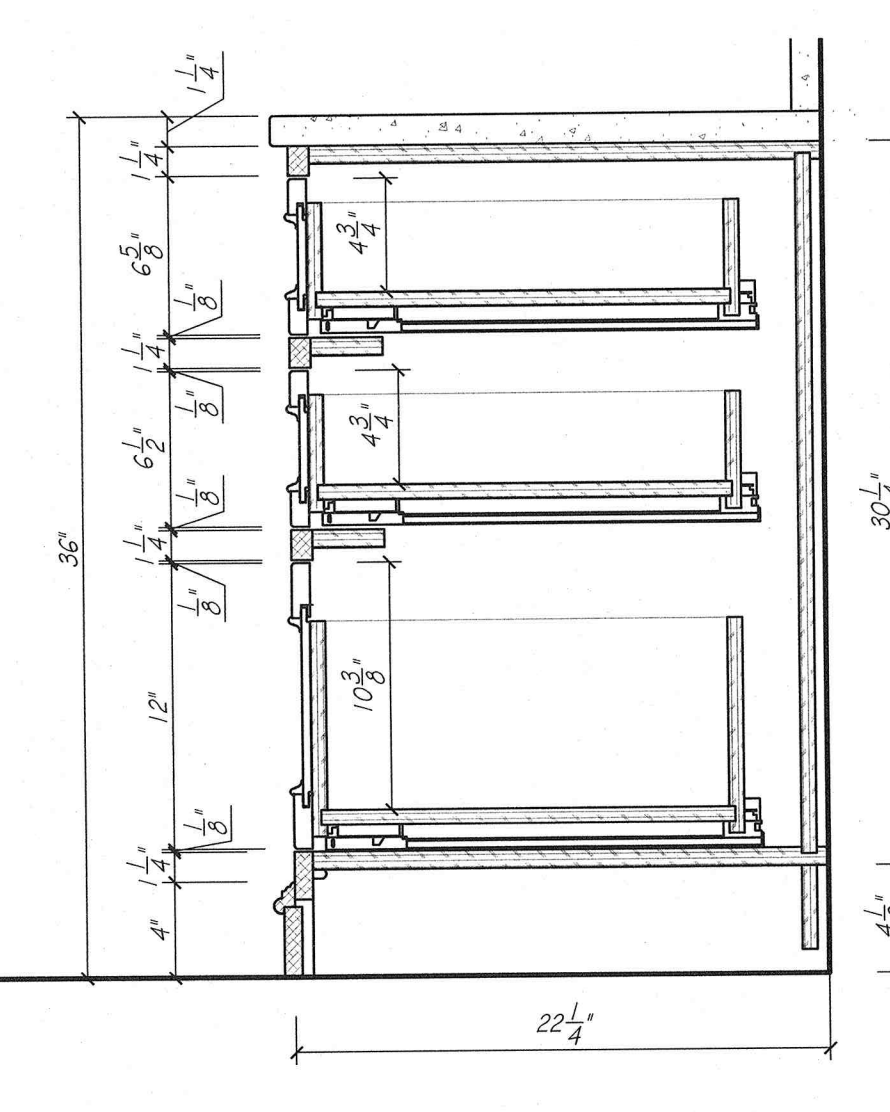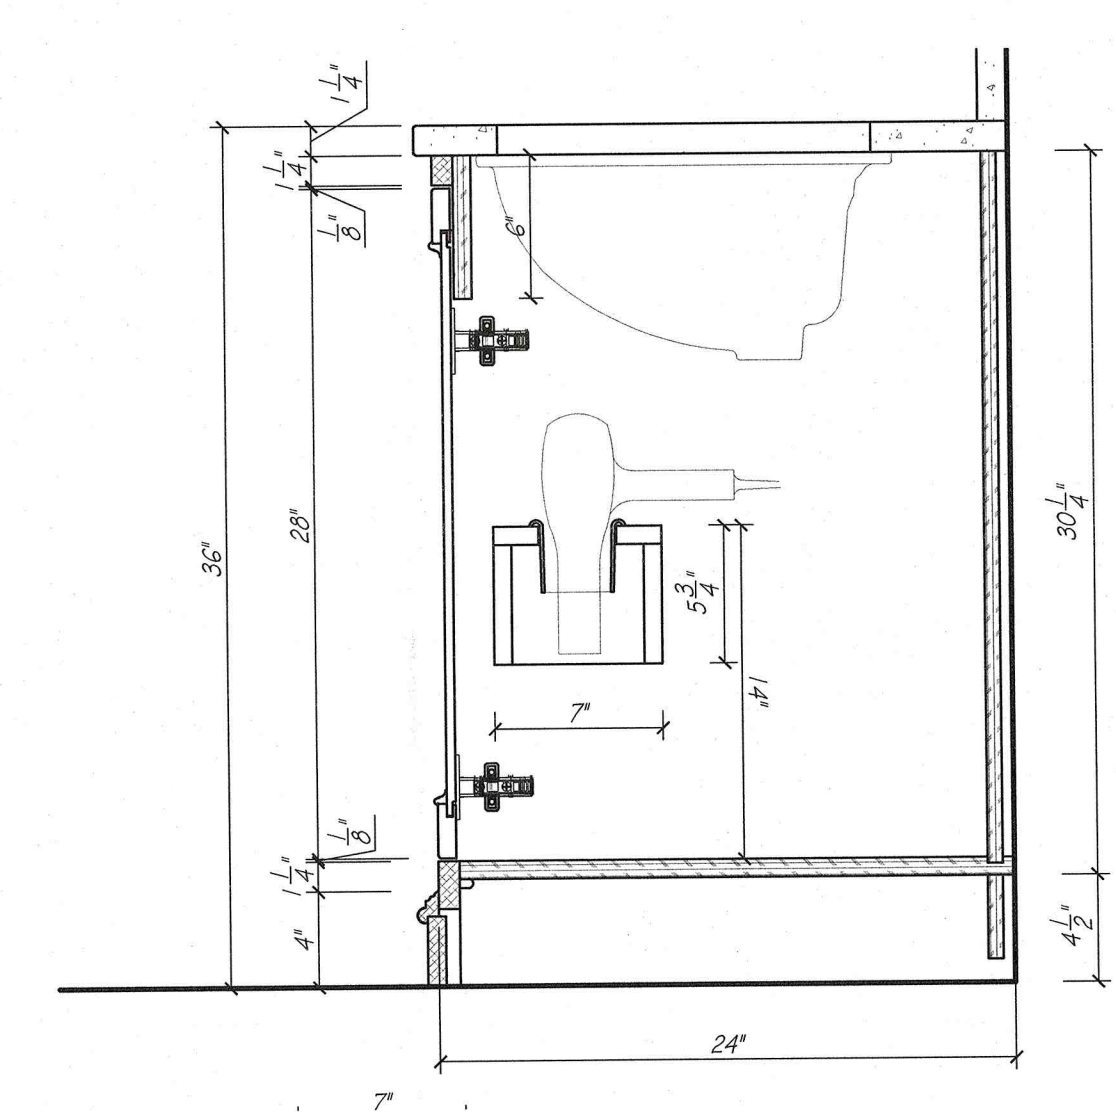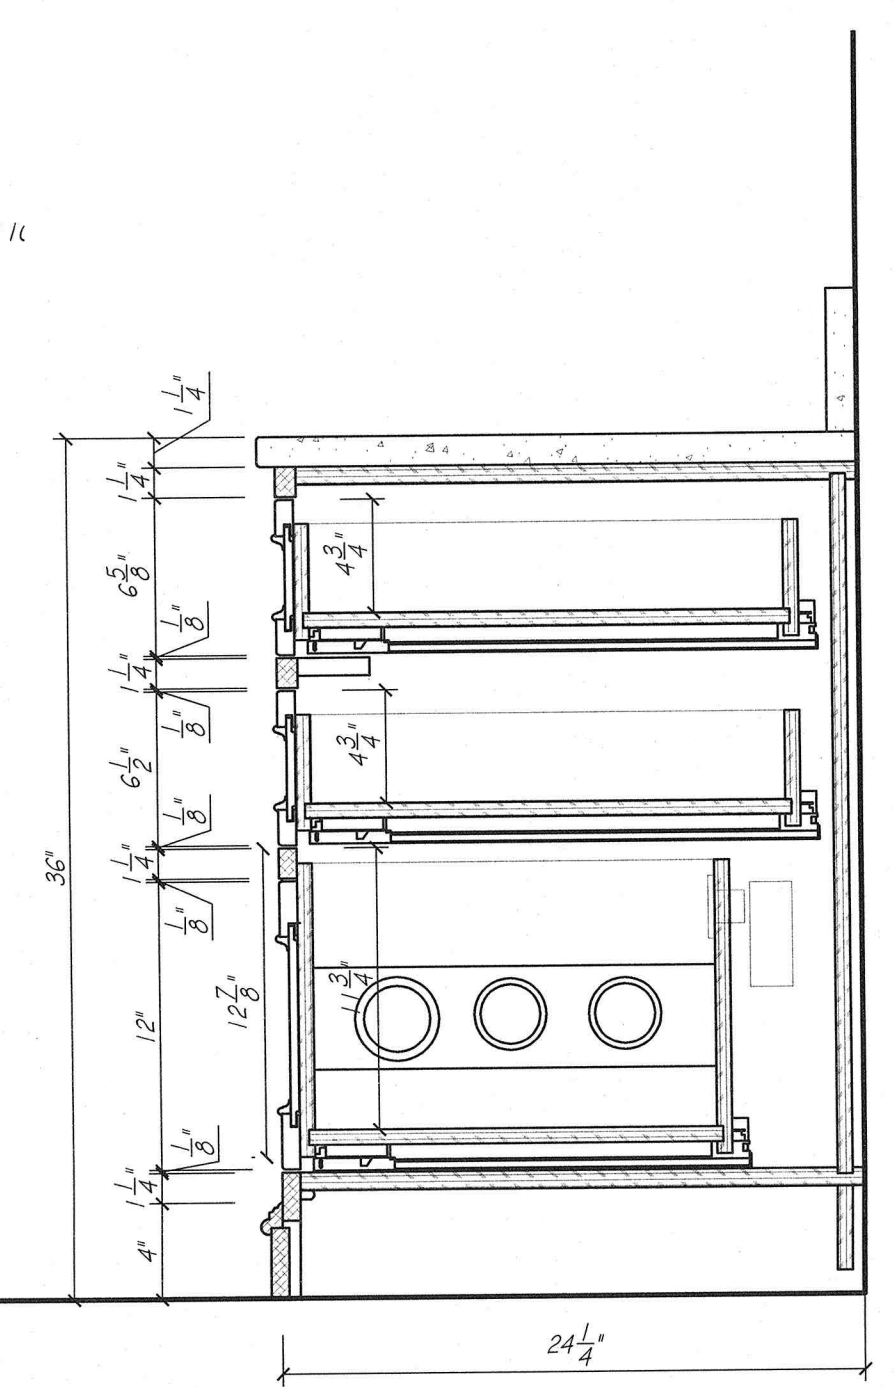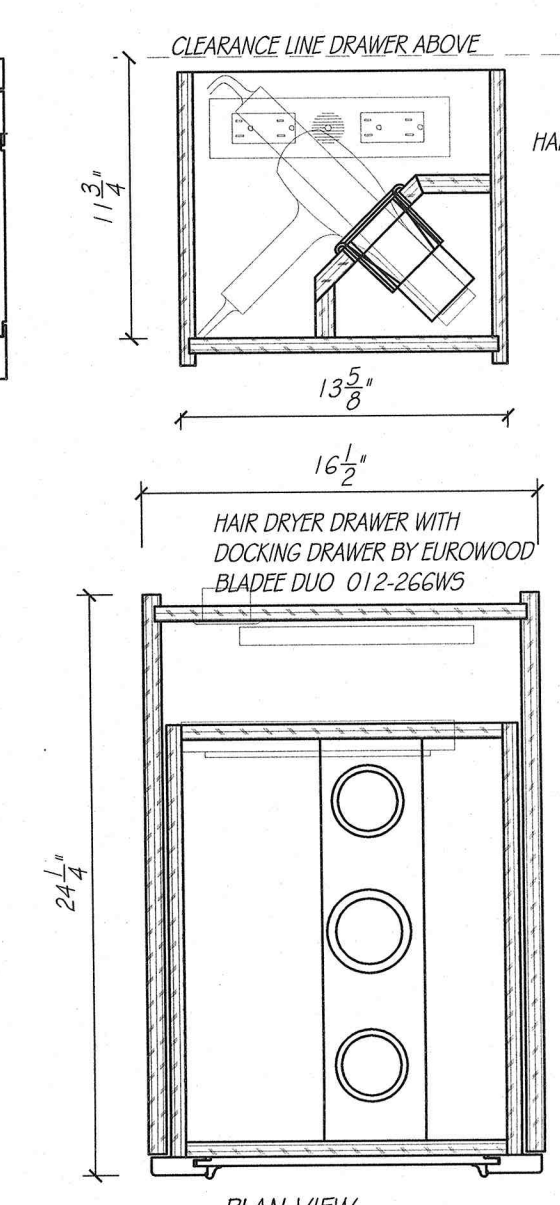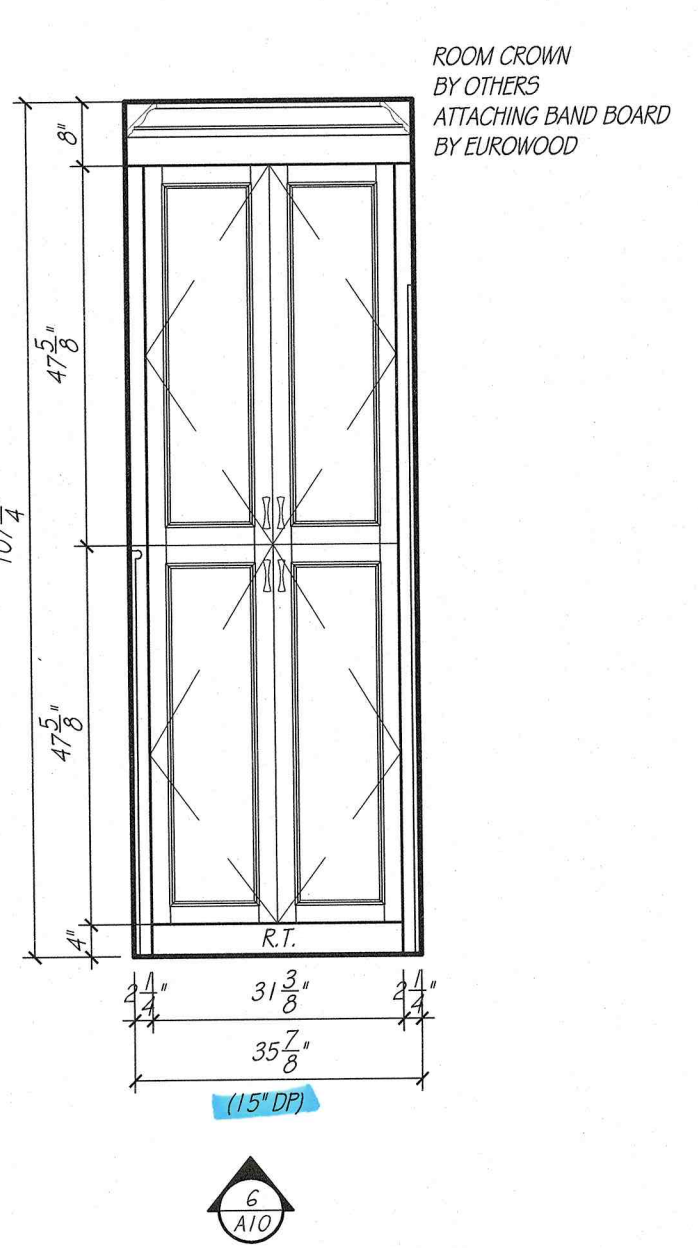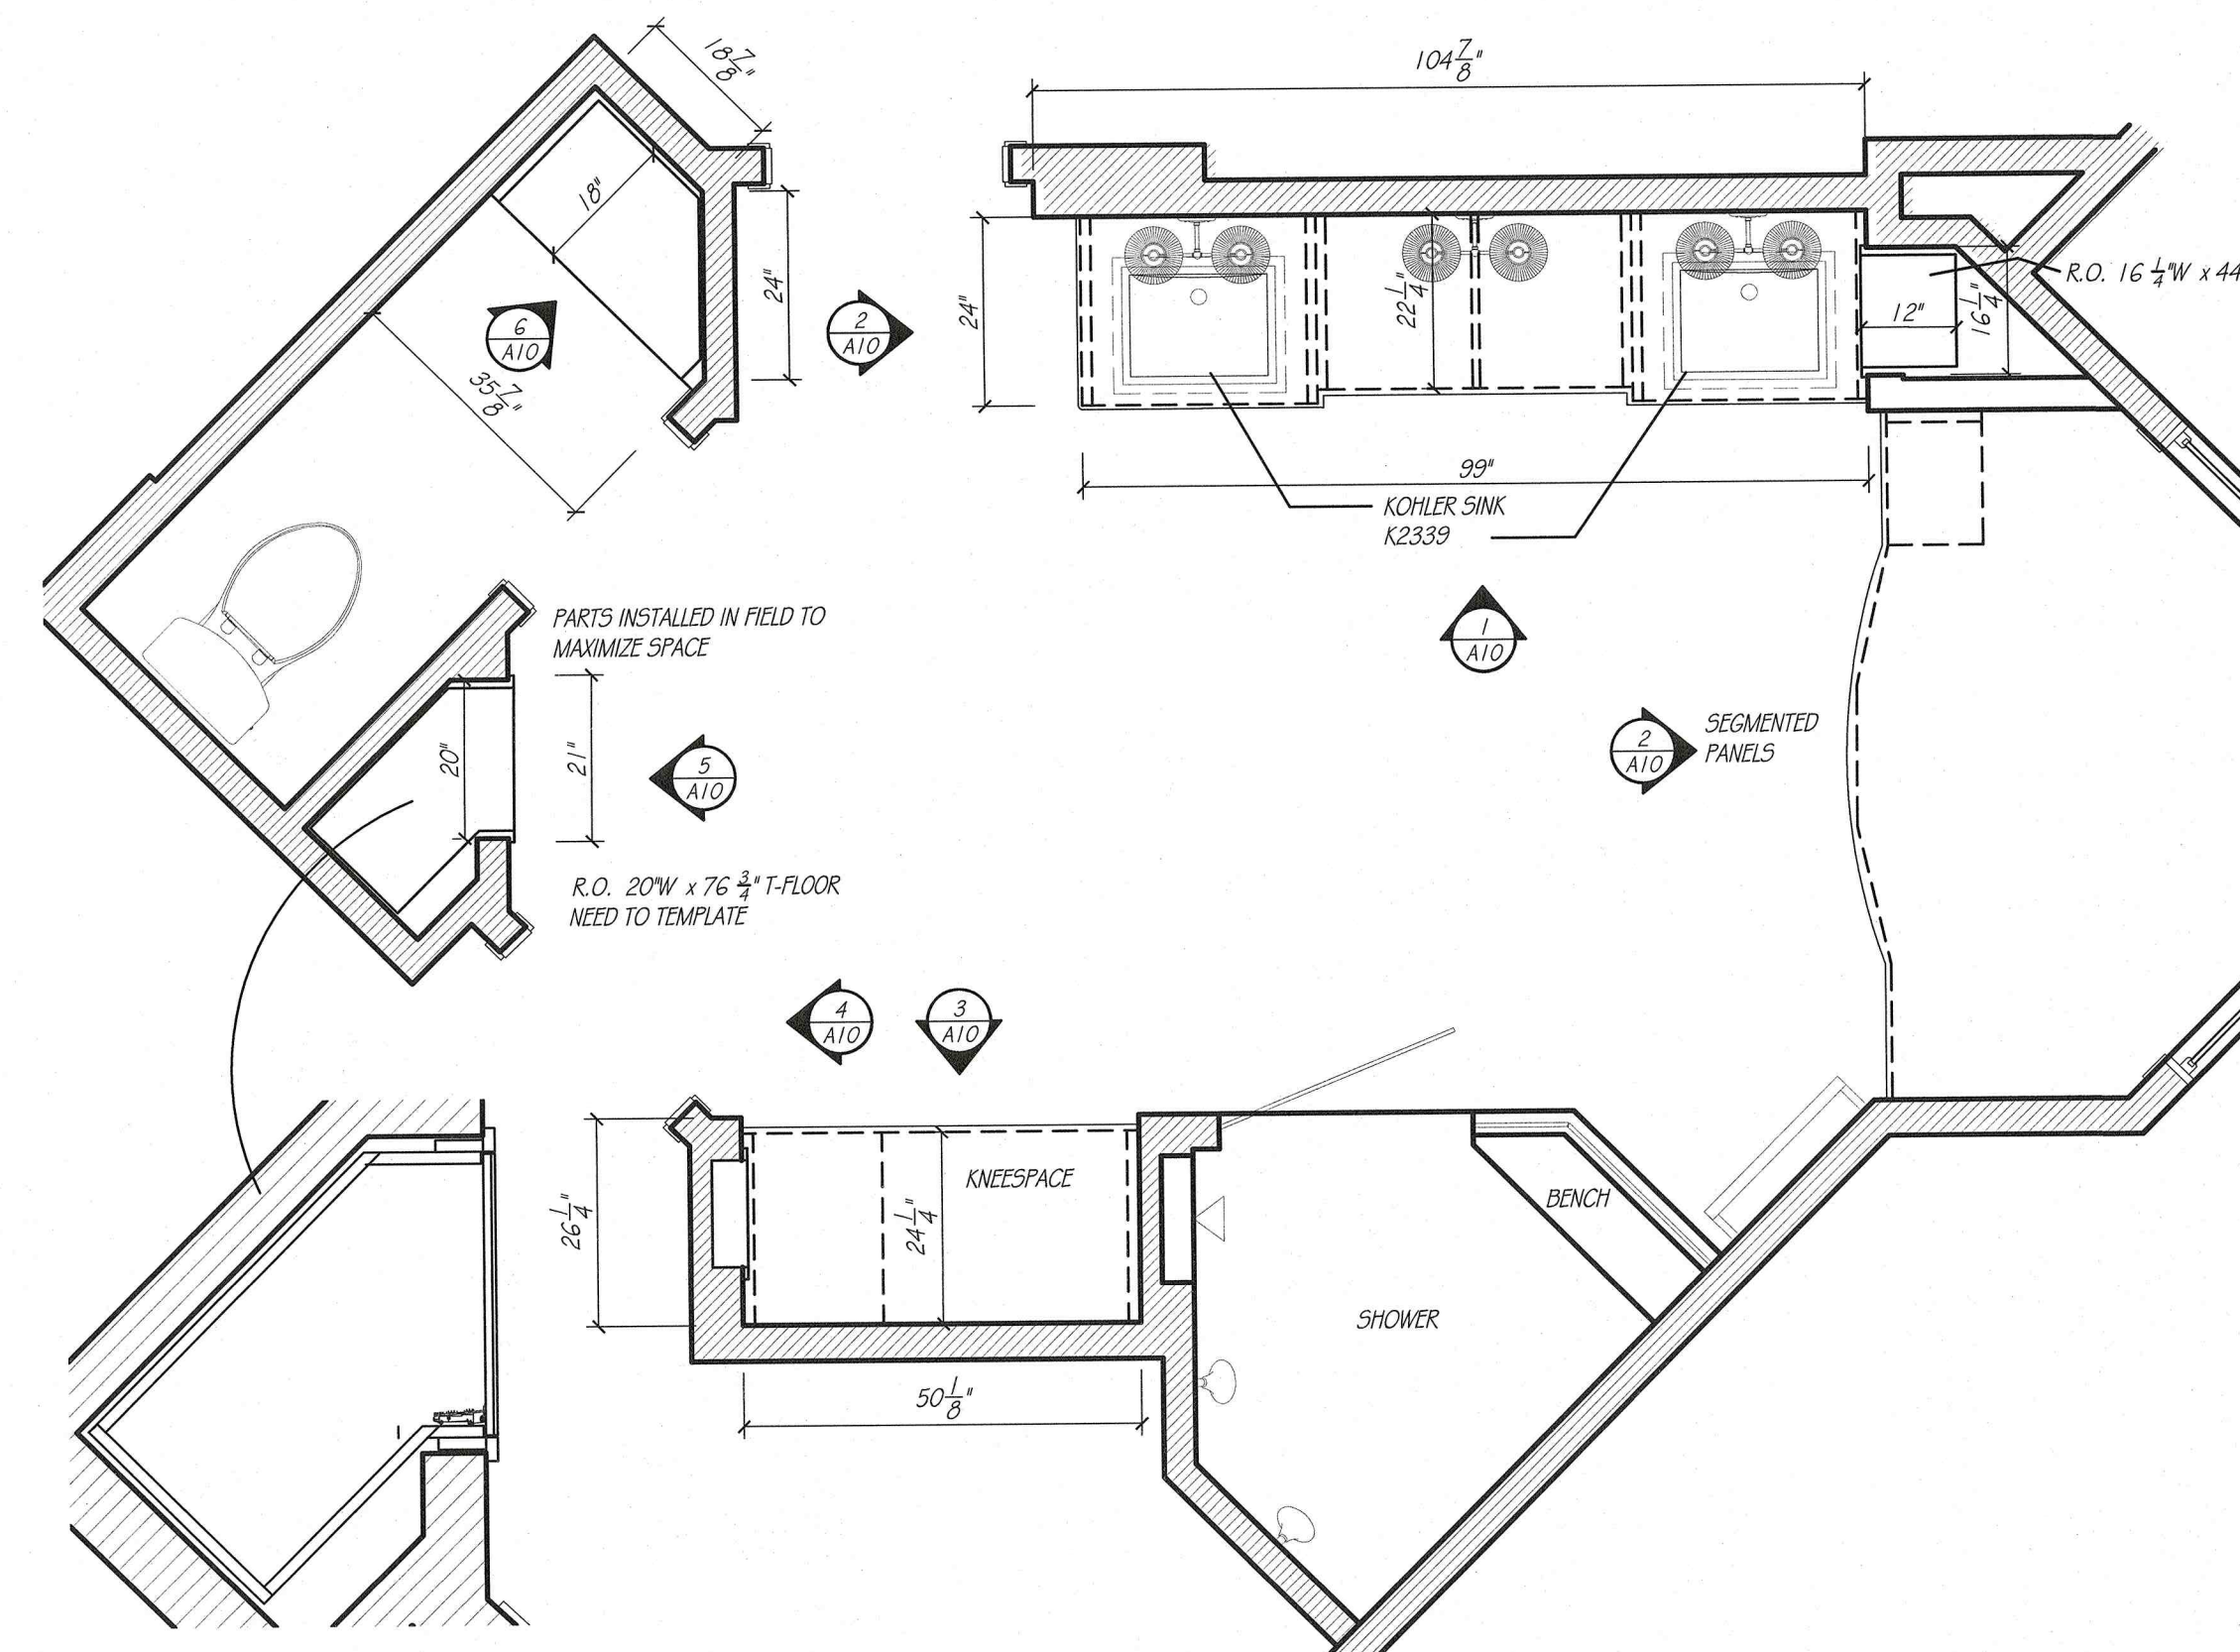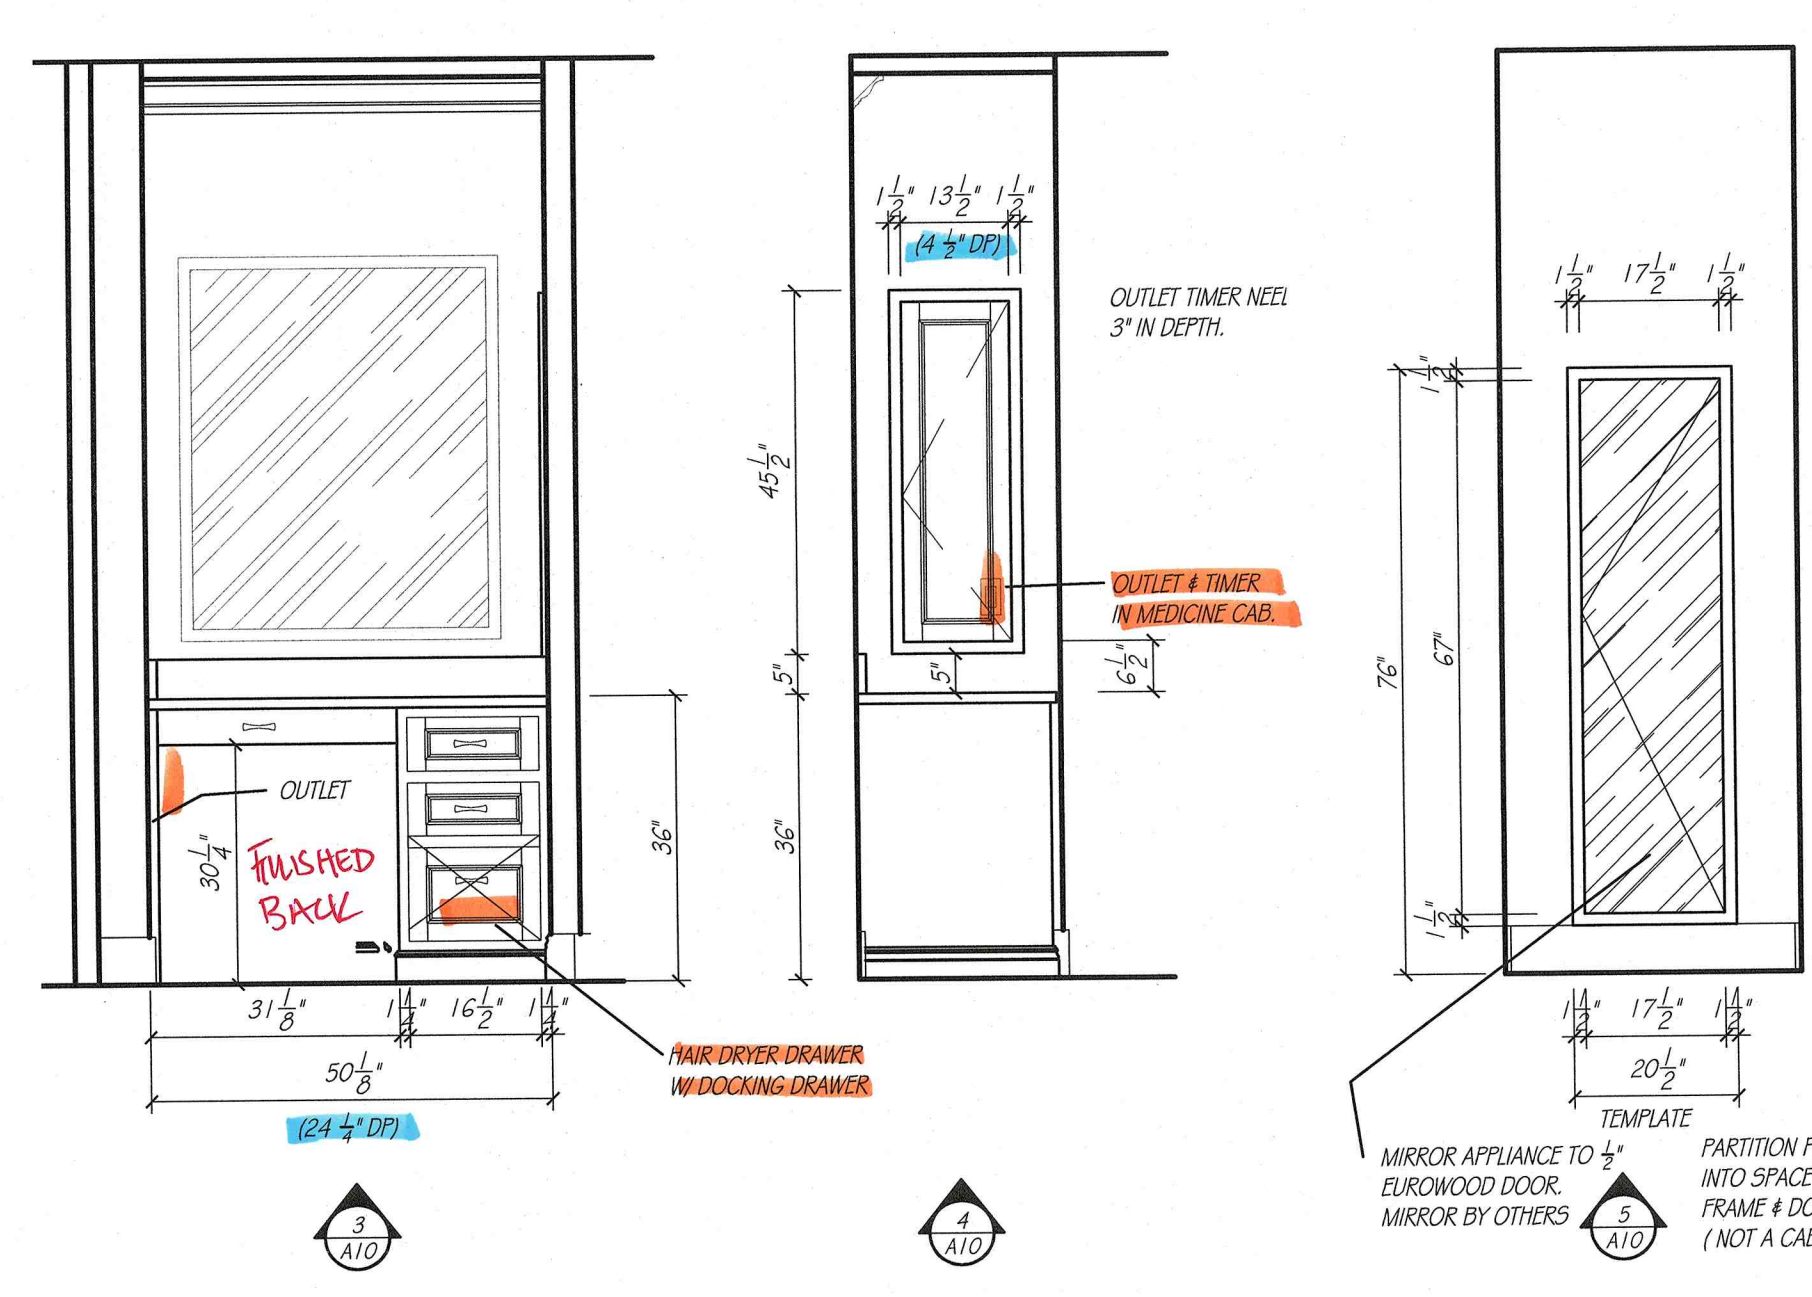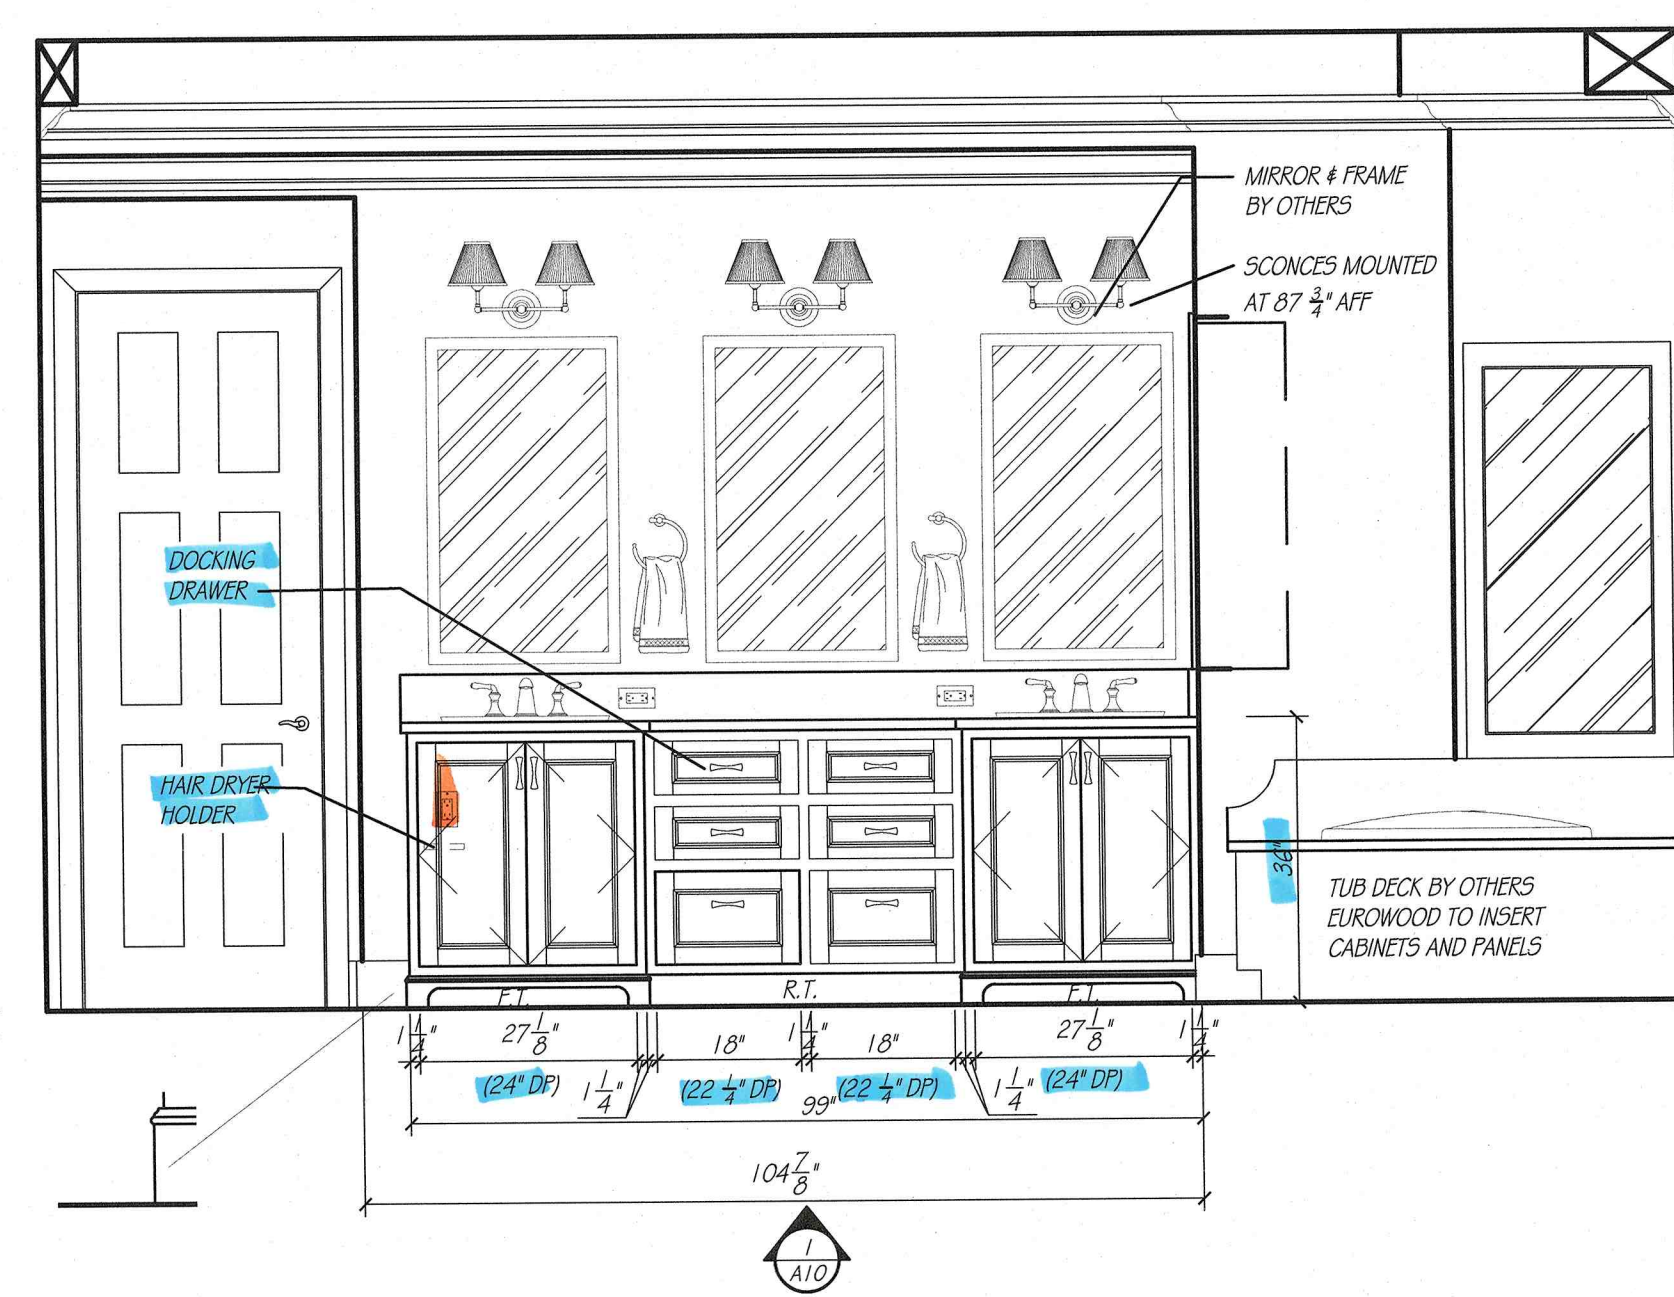


PRIMARY BATH
SCALE: 1/2" = 1'-0"

PRIMARY BATH	
CABINET CONSTRUCTION:	
COUNTERTOP	SPAWPALE
OUTLETS	HAIR DRYER MADE BY OTHERS
FACE BANDING	HAIR DRYER MADE BY OTHERS
CABINET HARDWARE & FINISHING	BY OTHERS
DOOR STYLE	HAIR DRYER MADE BY OTHERS
COUNTERTOP SPECIFICATIONS:	
COUNTERTOP MATERIAL	SPAWPALE
COUNTERTOP THICKNESS	1 1/2" MINIMUM
SUBTOP REQUIREMENTS	NONE
ROOM SPECIFICATIONS	
FLOORING	TYPE / ALLOWANCE
CASING	BY THE OTHERS

NONE
CROWN DETAIL
SCALE: 3" = 1'-0"

NONE
LC DETAIL
SCALE: 3" = 1'-0"

TOE DETAIL
SCALE: 3" = 1'-0"

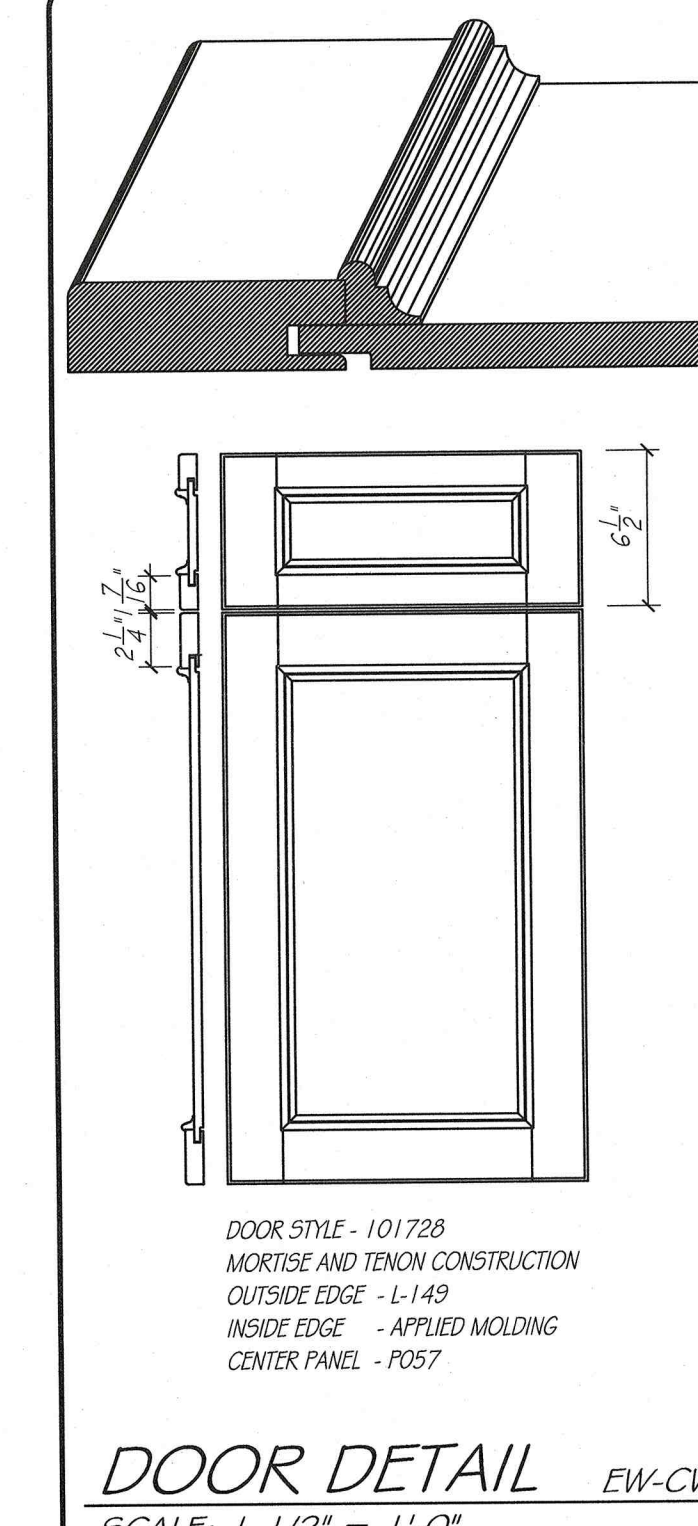


DOOR DETAIL
SCALE: 1/2" = 1'-0"

EUROWOOD
Cabinets
3415 SO. 87TH ST.
OMAHA, NE 68106
TEL (402-393-4110)
FAX (402-393-8361)
(WWW.EUROWOOD.NET)







SHEET: A10
DRAWN BY: SJB
PLAN: PRIMARY BATH
REVISIONS:
1. JUNE 26
2. JUNE 26
3. JULY 26
4. JULY 26
PHIL & MICHELLE WOOD
3435 N. 140TH. CIRCLE
OMAHA, NE 68164


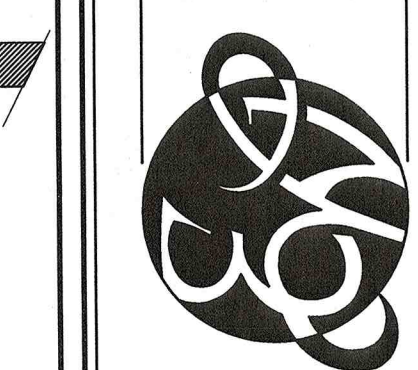


APPROVED BY:
SIGNATURE
DATE
WOOD
5588

BATH 3	
CABINET CONSTRUCTION:	
COUNTERTOP	SPAWPALE
OUTLETS	HAIR DRYER MADE BY OTHERS
FACE BANDING	HAIR DRYER MADE BY OTHERS
CABINET HARDWARE & FINISHING	BY OTHERS
DOOR STYLE	HAIR DRYER MADE BY OTHERS
COUNTERTOP SPECIFICATIONS:	
COUNTERTOP MATERIAL	SPAWPALE
COUNTERTOP THICKNESS	1 1/2" MINIMUM
SUBTOP REQUIREMENTS	NONE
ROOM SPECIFICATIONS	
FLOORING	TYPE / ALLOWANCE
CASING	BY THE OTHERS

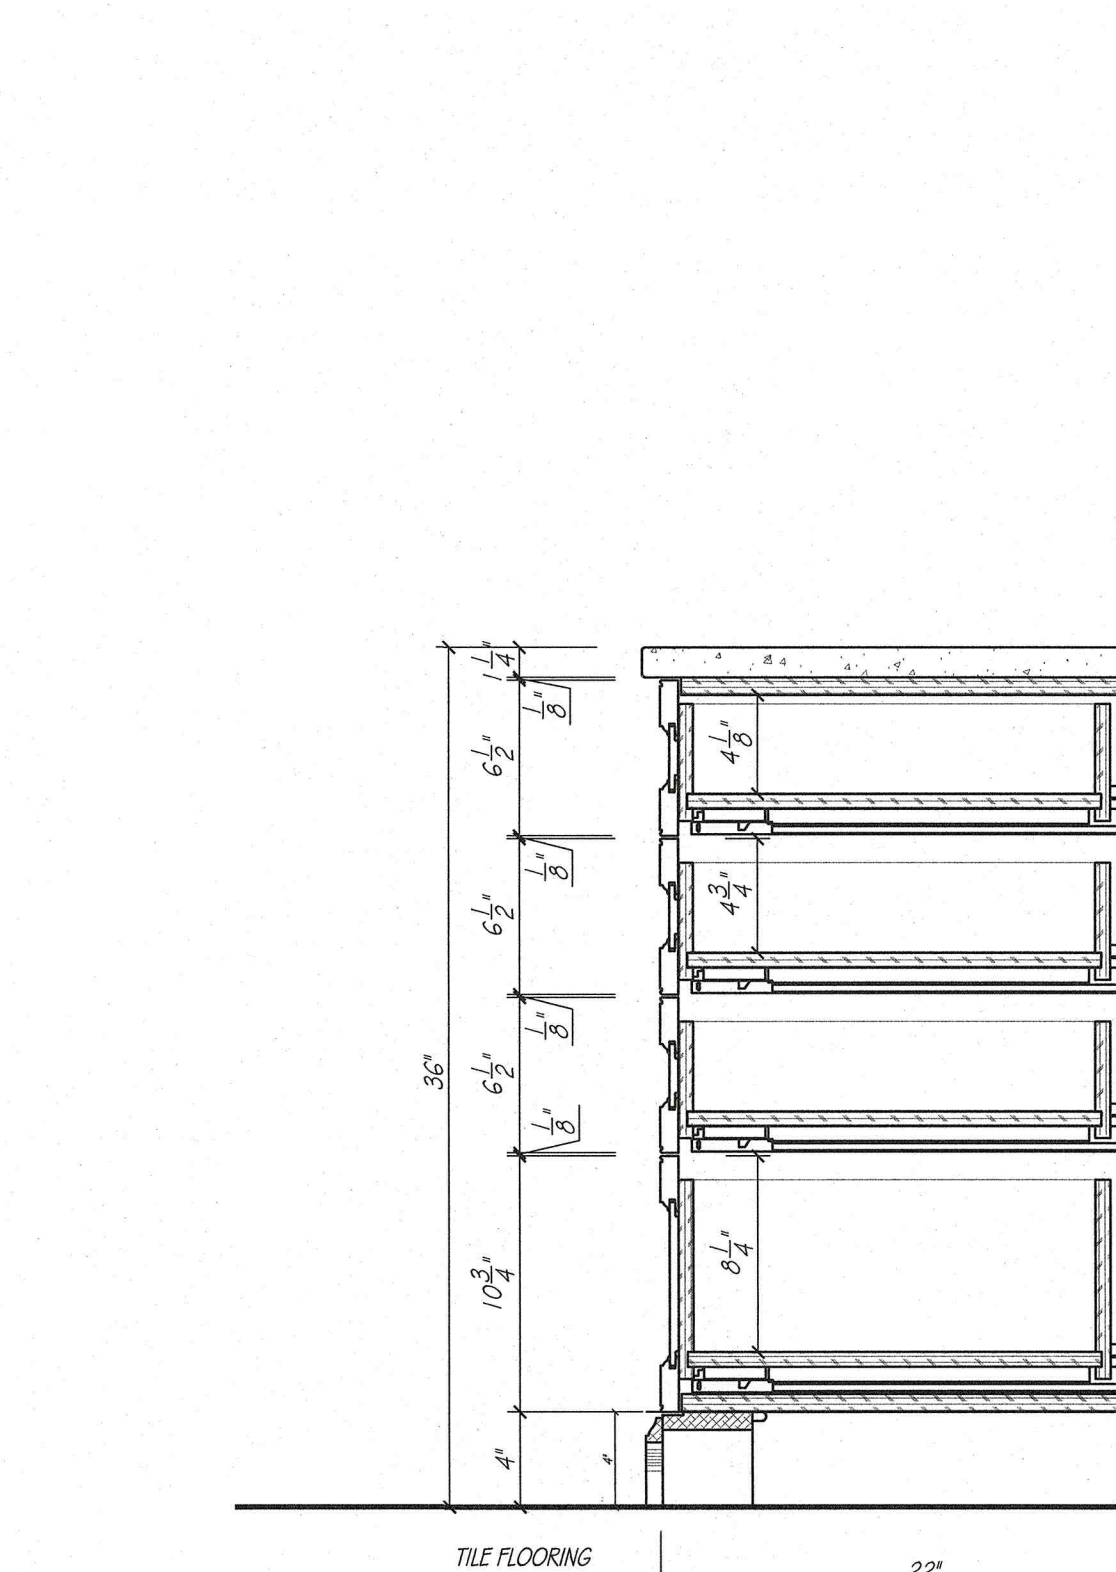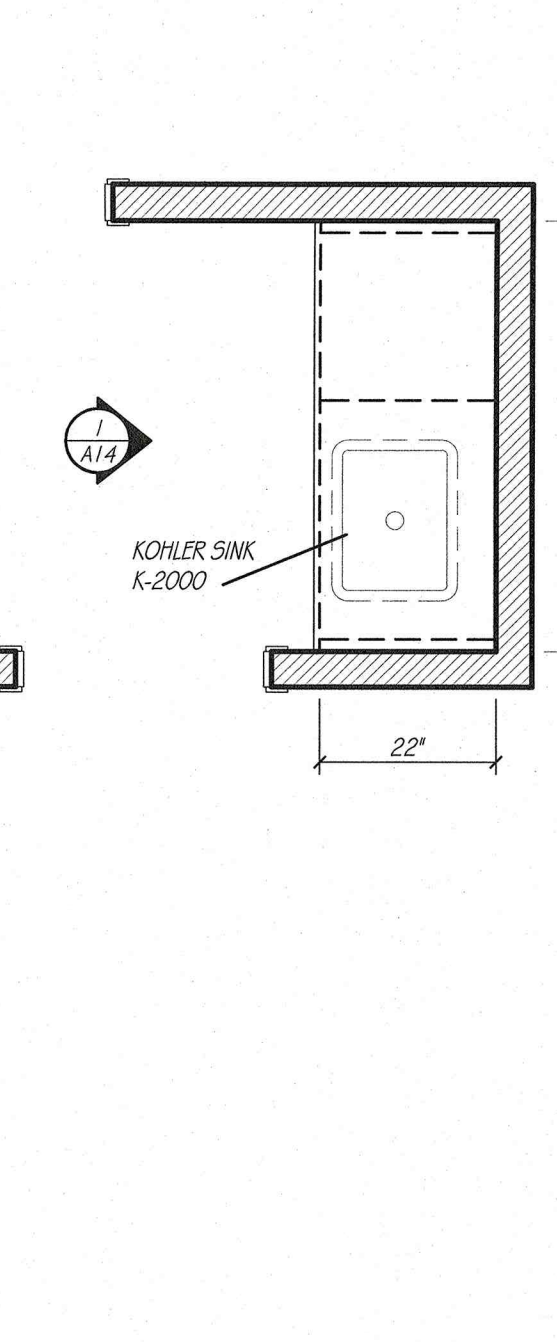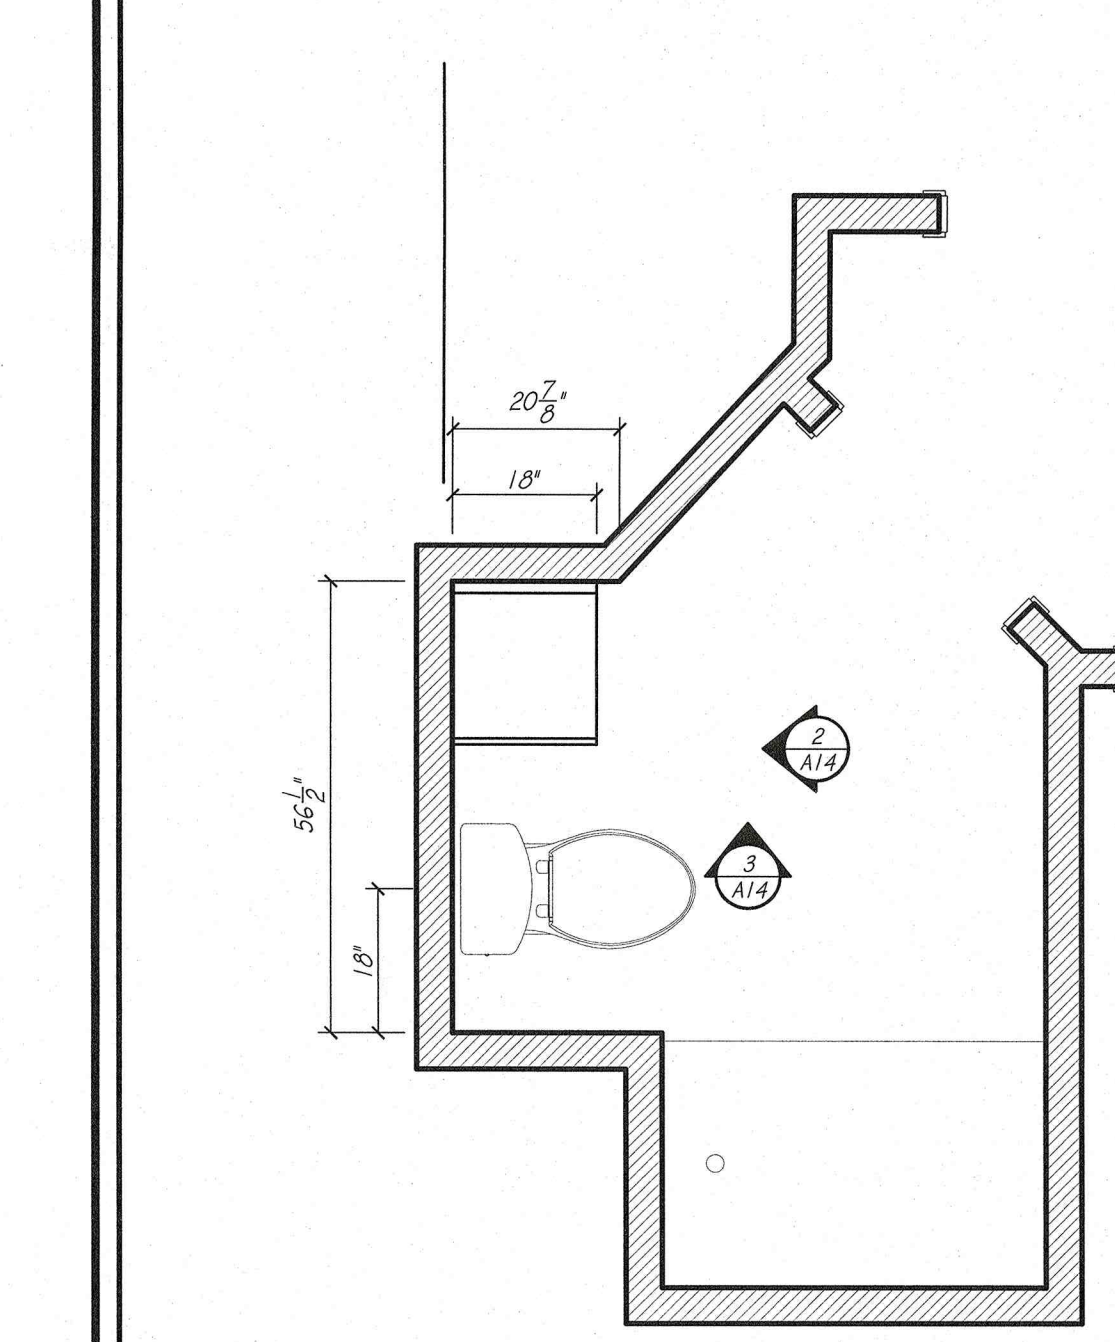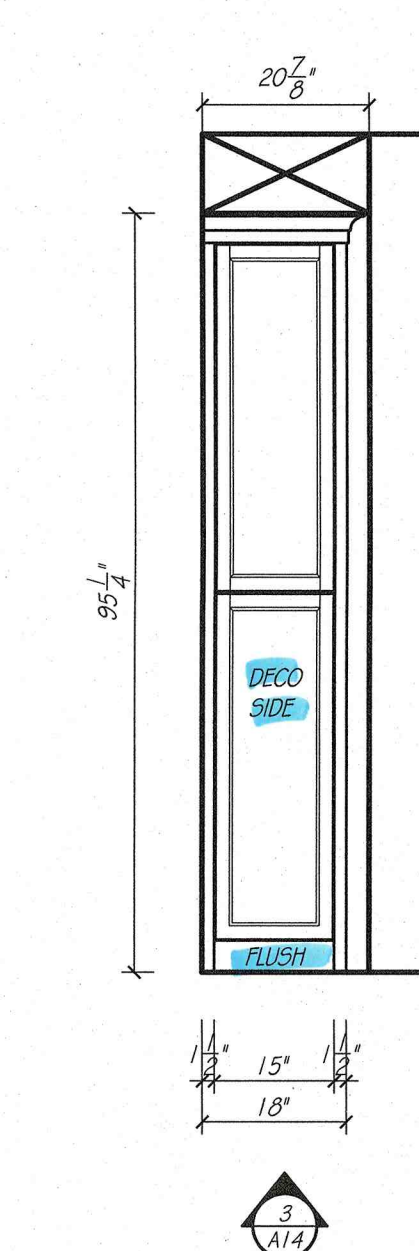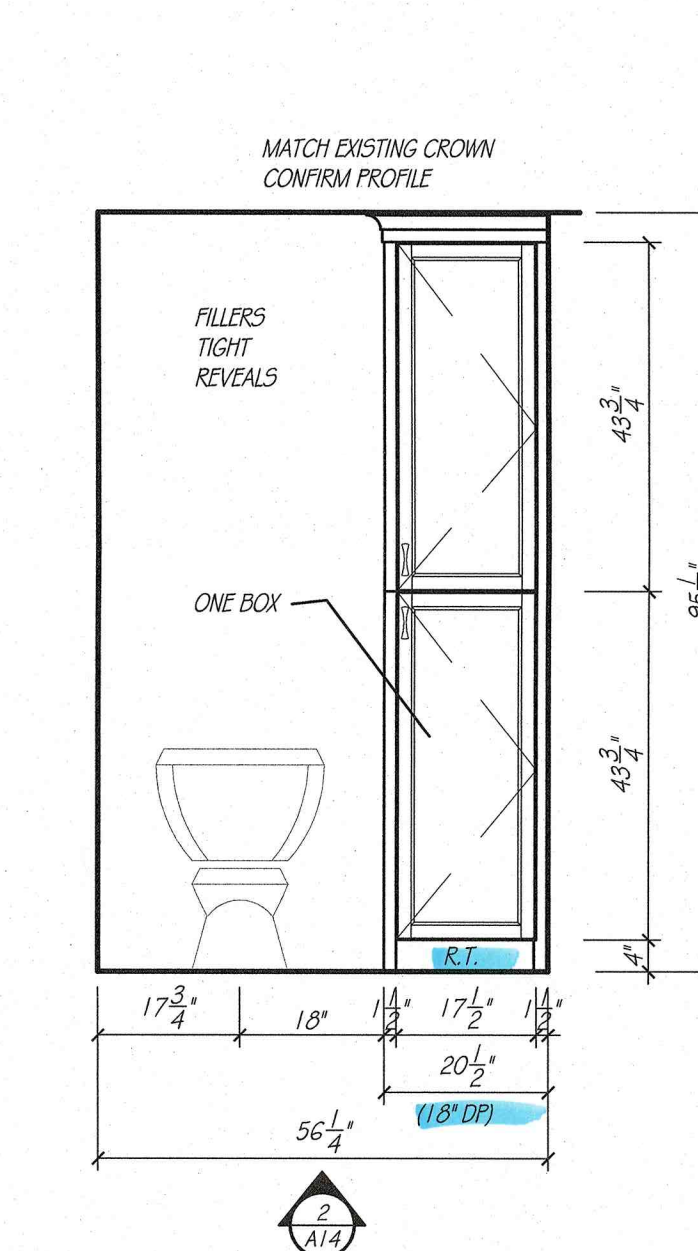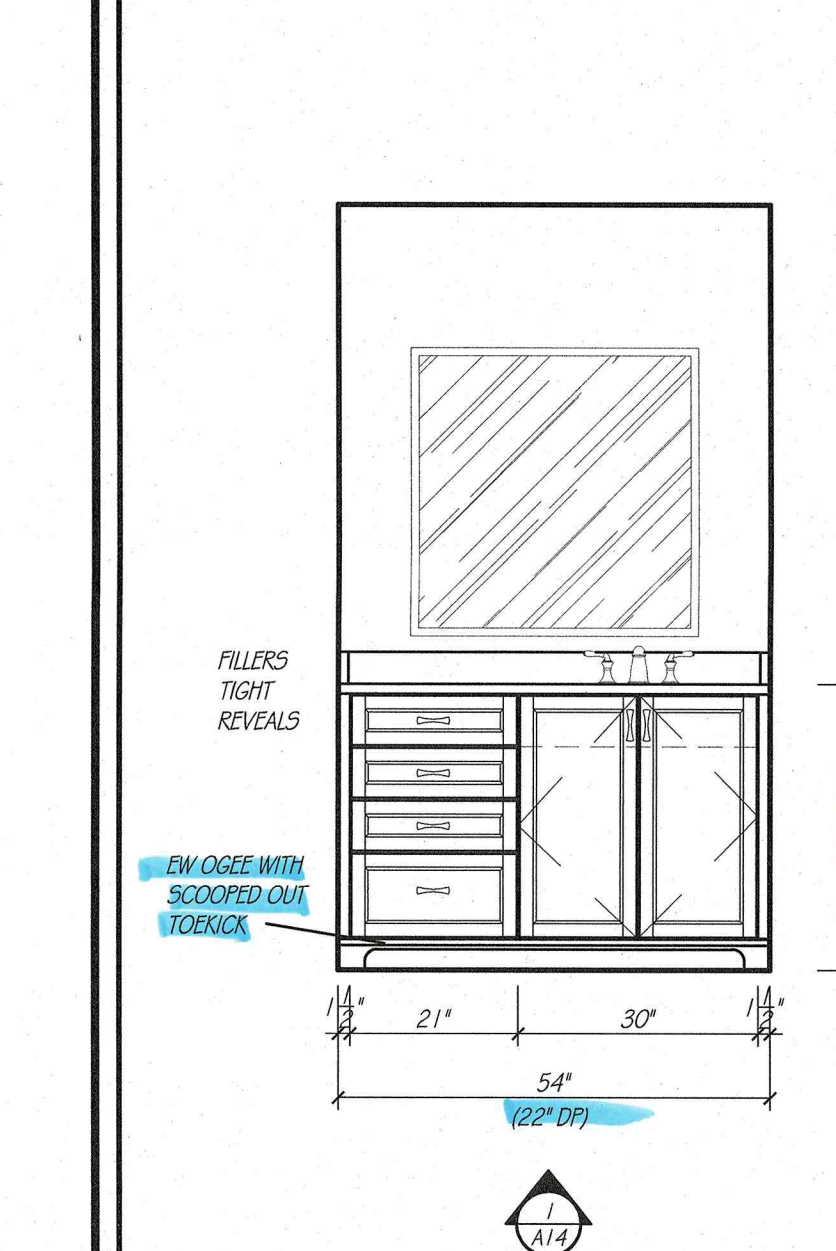

BATH 3
SCALE: 1/2" = 1'-0"

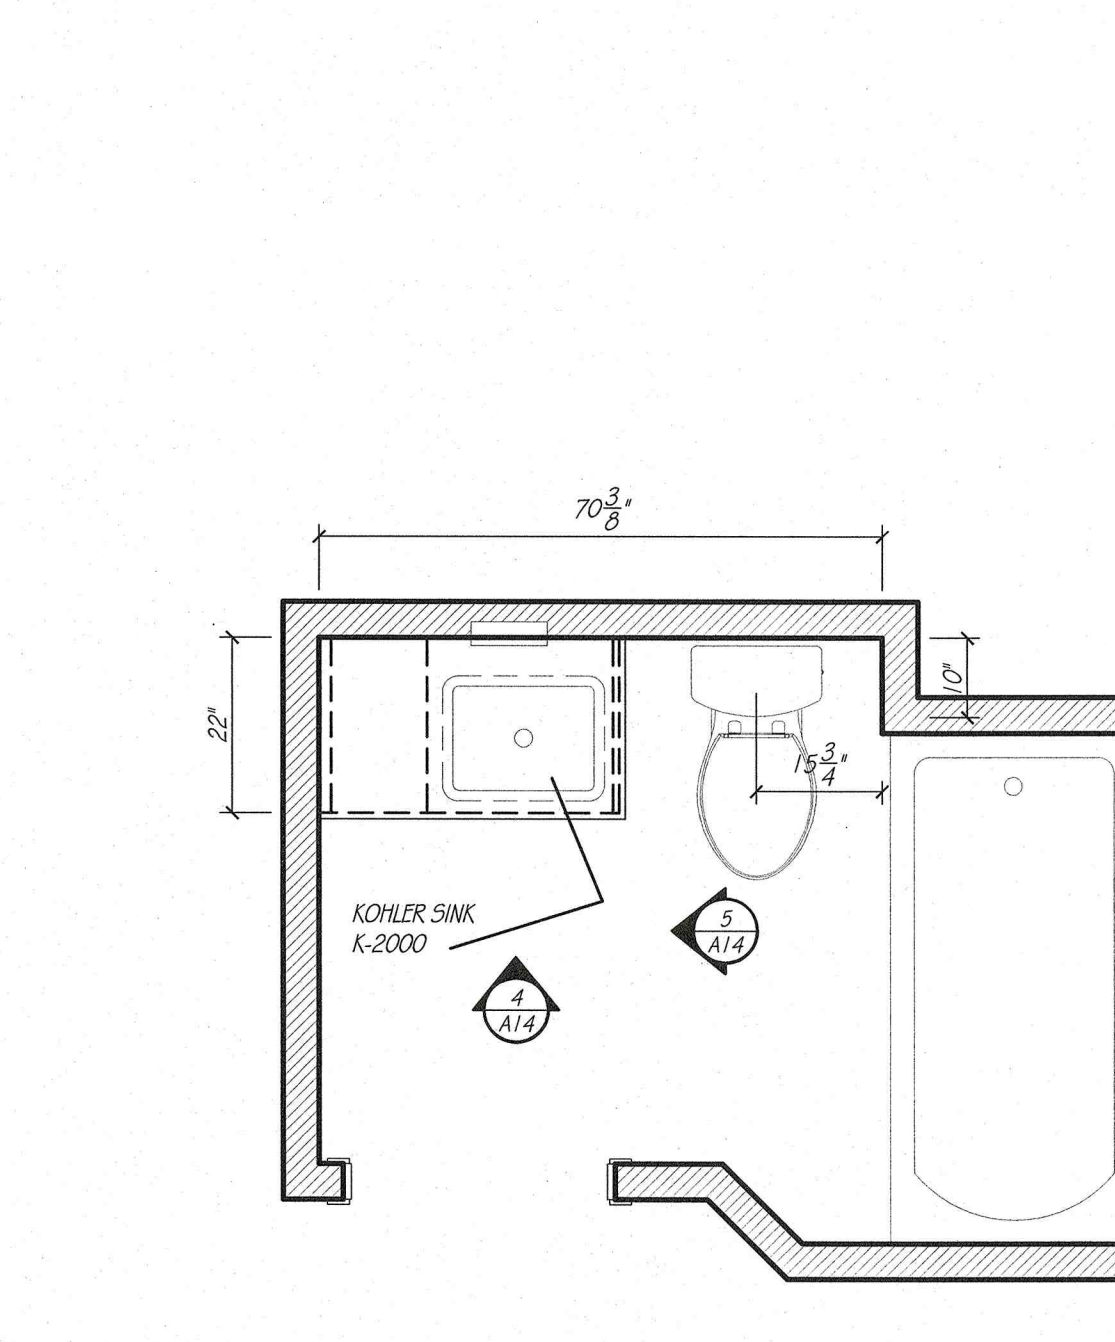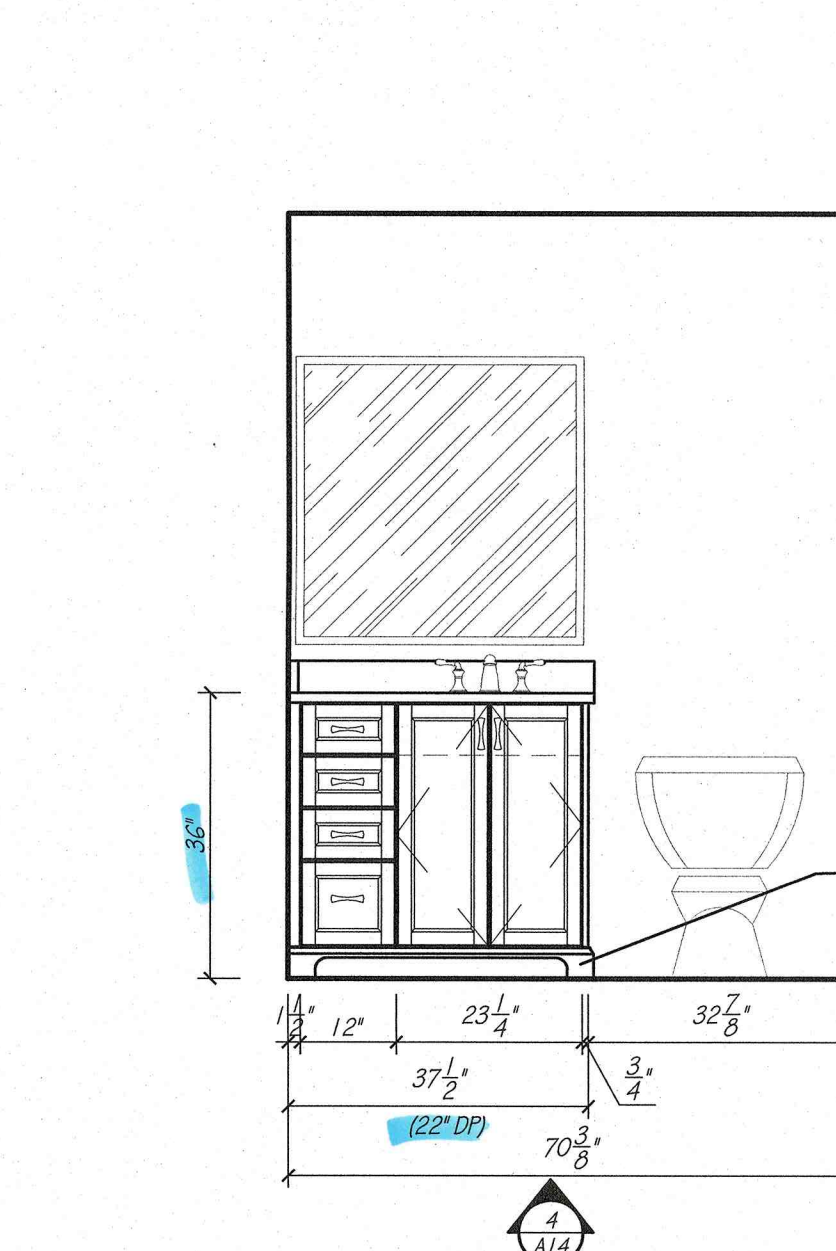

BATH 3
SCALE: 1/2" = 1'-0"


BATH 3	
CABINET CONSTRUCTION:	
COUNTERTOP	SPAWPALE
OUTLETS	HAIR DRYER MADE BY OTHERS
FACE BANDING	HAIR DRYER MADE BY OTHERS
CABINET HARDWARE & FINISHING	BY OTHERS
DOOR STYLE	HAIR DRYER MADE BY OTHERS
COUNTERTOP SPECIFICATIONS:	
COUNTERTOP MATERIAL	SPAWPALE
COUNTERTOP THICKNESS	1 1/2" MINIMUM
SUBTOP REQUIREMENTS	NONE
ROOM SPECIFICATIONS	
FLOORING	TYPE / ALLOWANCE
CASING	BY THE OTHERS

SHEET: A10
DRAWN BY: SJB
PLAN: BATH 3
REVISIONS:
1. JUNE 26
2. JUNE 26
3. JULY 26
4. JULY 26
NONE
CROWN DETAIL
SCALE: 3" = 1'-0"

NONE
LC DETAIL
SCALE: 3" = 1'-0"

TOE DETAIL
SCALE: 3" = 1'-0"

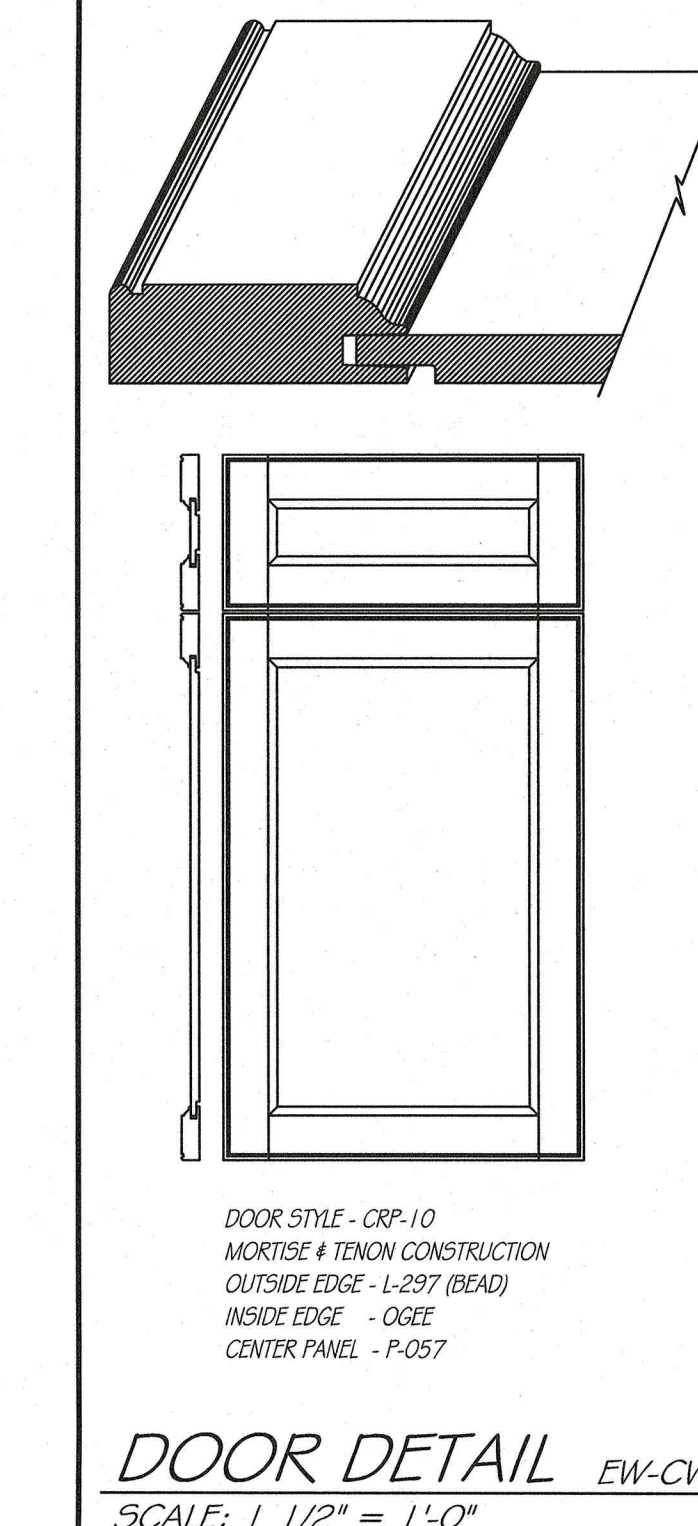

DOOR DETAIL
SCALE: 1/2" = 1'-0"

EUROWOOD
Cabinets
3415 SO. 87TH ST.
OMAHA, NE 68106
TEL (402-393-4110)
FAX (402-393-8361)
(WWW.EUROWOOD.NET)

SHEET: A10
DRAWN BY: SJB
PLAN: BATH 3
REVISIONS:
1. JUNE 26
2. JUNE 26
3. JULY 26
4. JULY 26
PHIL & MICHELLE WOOD
3435 N. 140TH. CIRCLE
OMAHA, NE 68164



APPROVED BY:
SIGNATURE
DATE
WOOD
5588



EUROWOOD

Cabinets Inc.

3415 SO. 67TH ST.
OMAHA, NE 68106

TEL (402-393-4110)

FAX (402-393-8361)

(WWW.EUROWOOD.NET)

SHEET:

A3

DRAWN BY:

SJB

PLAN:

MAIN LEVEL

KITCHEN

REVISIONS:

10 JULY 26

24 JULY 26

27 AUGUST 26

PHIL & MICHELLE WOOD
3435 N. 140TH. CIRCLE
OMAHA, NE 68164



APPROVED BY:

SIGNATURE



DATE

DUPLICATION OF THESE DRAWINGS IS
PROHIBITED WITHOUT WRITTEN CONSENT
OF EUROWOOD CABINETS
© 2000, EUROWOOD CABINETS INC.

WOOD

5588


THERMADOR DOUBLE OVEN 30"
MODEL-MED302LWS
FLUSH INSTALL

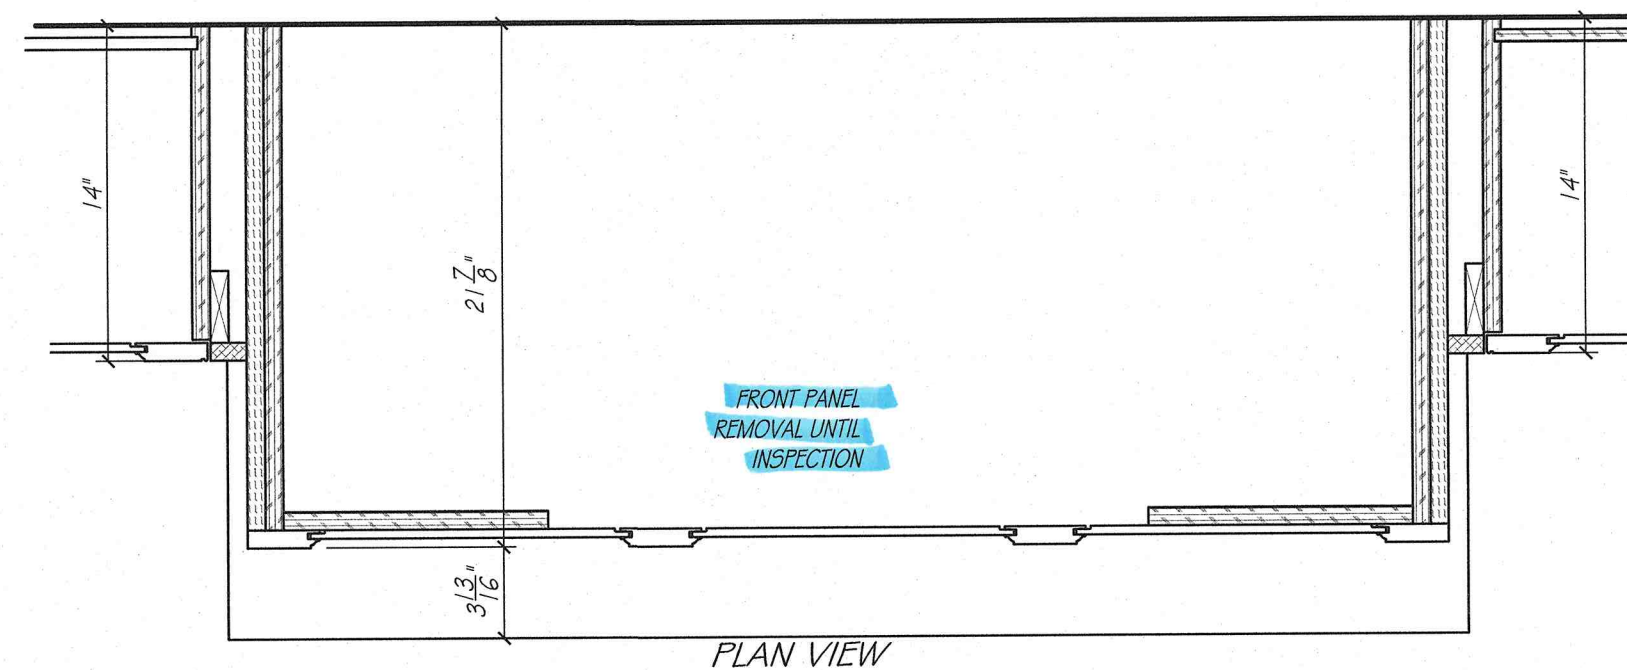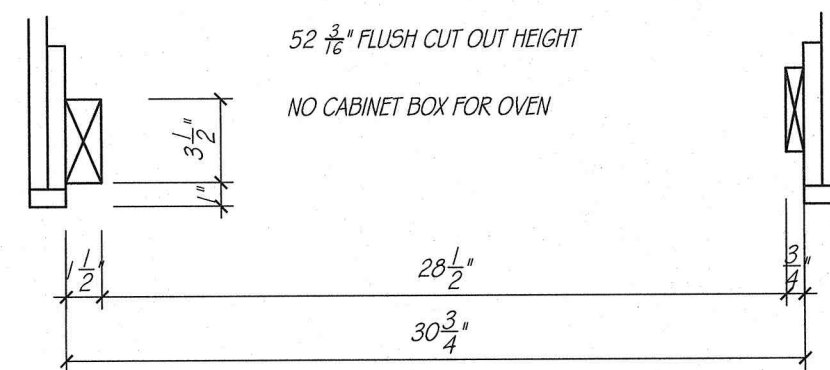

HOOD DETAIL

SCALE: 1 1/2" = 1'-0"

THERMADOR DISHWASHER
MODEL-DWHD660EPR

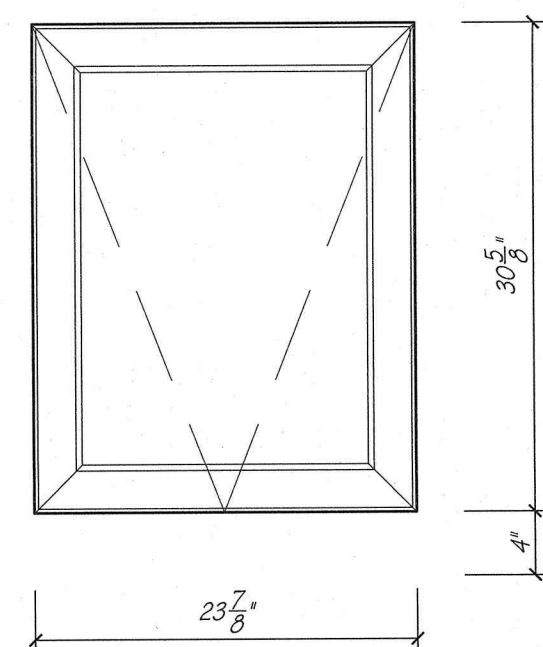


PANEL #1 23 7/8" W x 30 5/8" T
PANEL ATTACHES FROM BACK

3/8" FILLER PANEL ABOVE DISHWASHER
SEPARATE PIECE TO BE POCKET SCREWED
TO ADJACENT CABINETS

PANEL IS MADE TALLER THAN SPEC
AND WILL LIP OVER CONTROLS, IN ORDER TO
ALIGN WITH ADJACENT FRONTS

SUB ZERO REFRIGERATOR 48" (CLASSIC)
MODEL - CL4850UFD/O


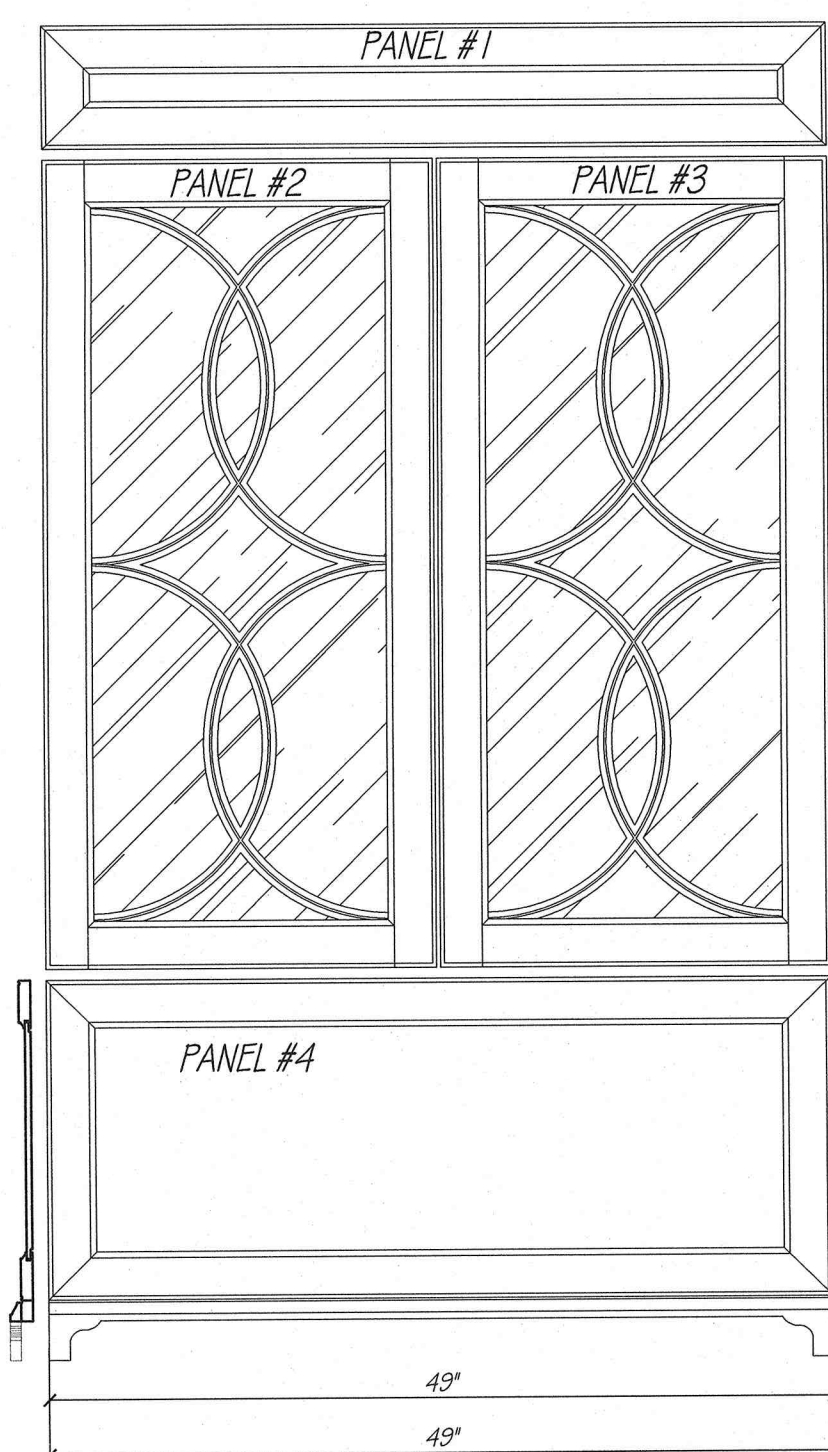


PANEL #1 49" W x 7 3/4" T
PANEL ATTACHES FROM BACK
WITH ROUTED & BACKER PANEL STRIP

PANEL #2&3 24 3/8" W x 50 5/8" T
PANEL ATTACHES FROM BACK
WITH ROUTED BACKER PANEL
MIRROR BY OTHERS


PANEL #4 49" W x 20" T
PANEL ATTACHES FROM BACK
WITH ROUTED BACKER PANEL STRIP
ATTACHED FURNITURE TOE TO BOTTOM

PROVIDE BLOCKING STRIPS
2 @ 3 1/2" W x 84" T x 1 1/4" D
1 @ 3 1/2" W x 50" T x 1/2" D
SET BACK FROM CABINET FACE 2 3/16"

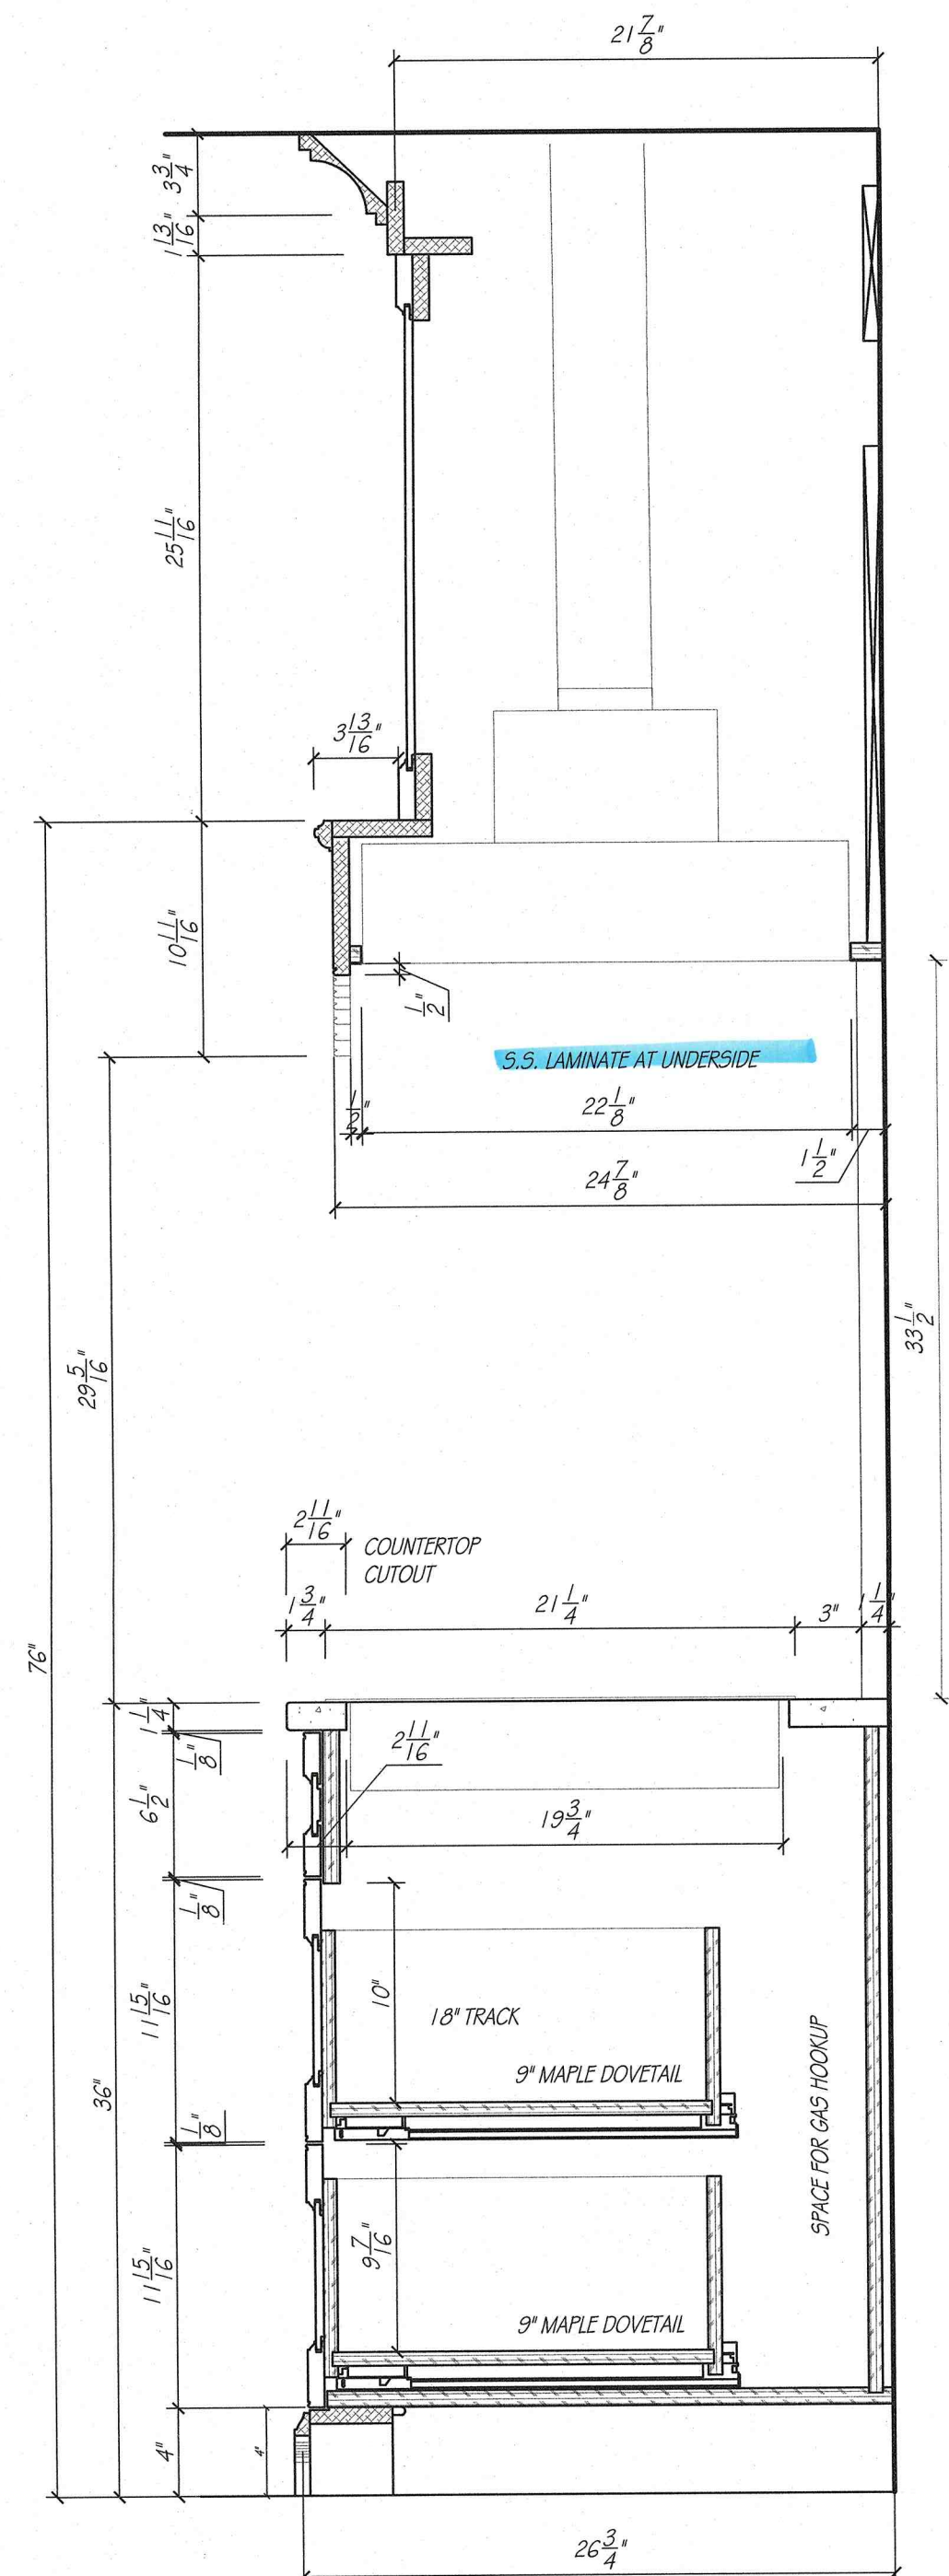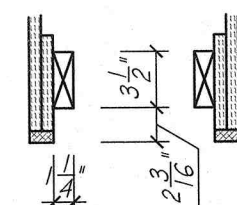


10
A3 CABINET DETAIL

SCALE: 1 1/2" = 1'-0"

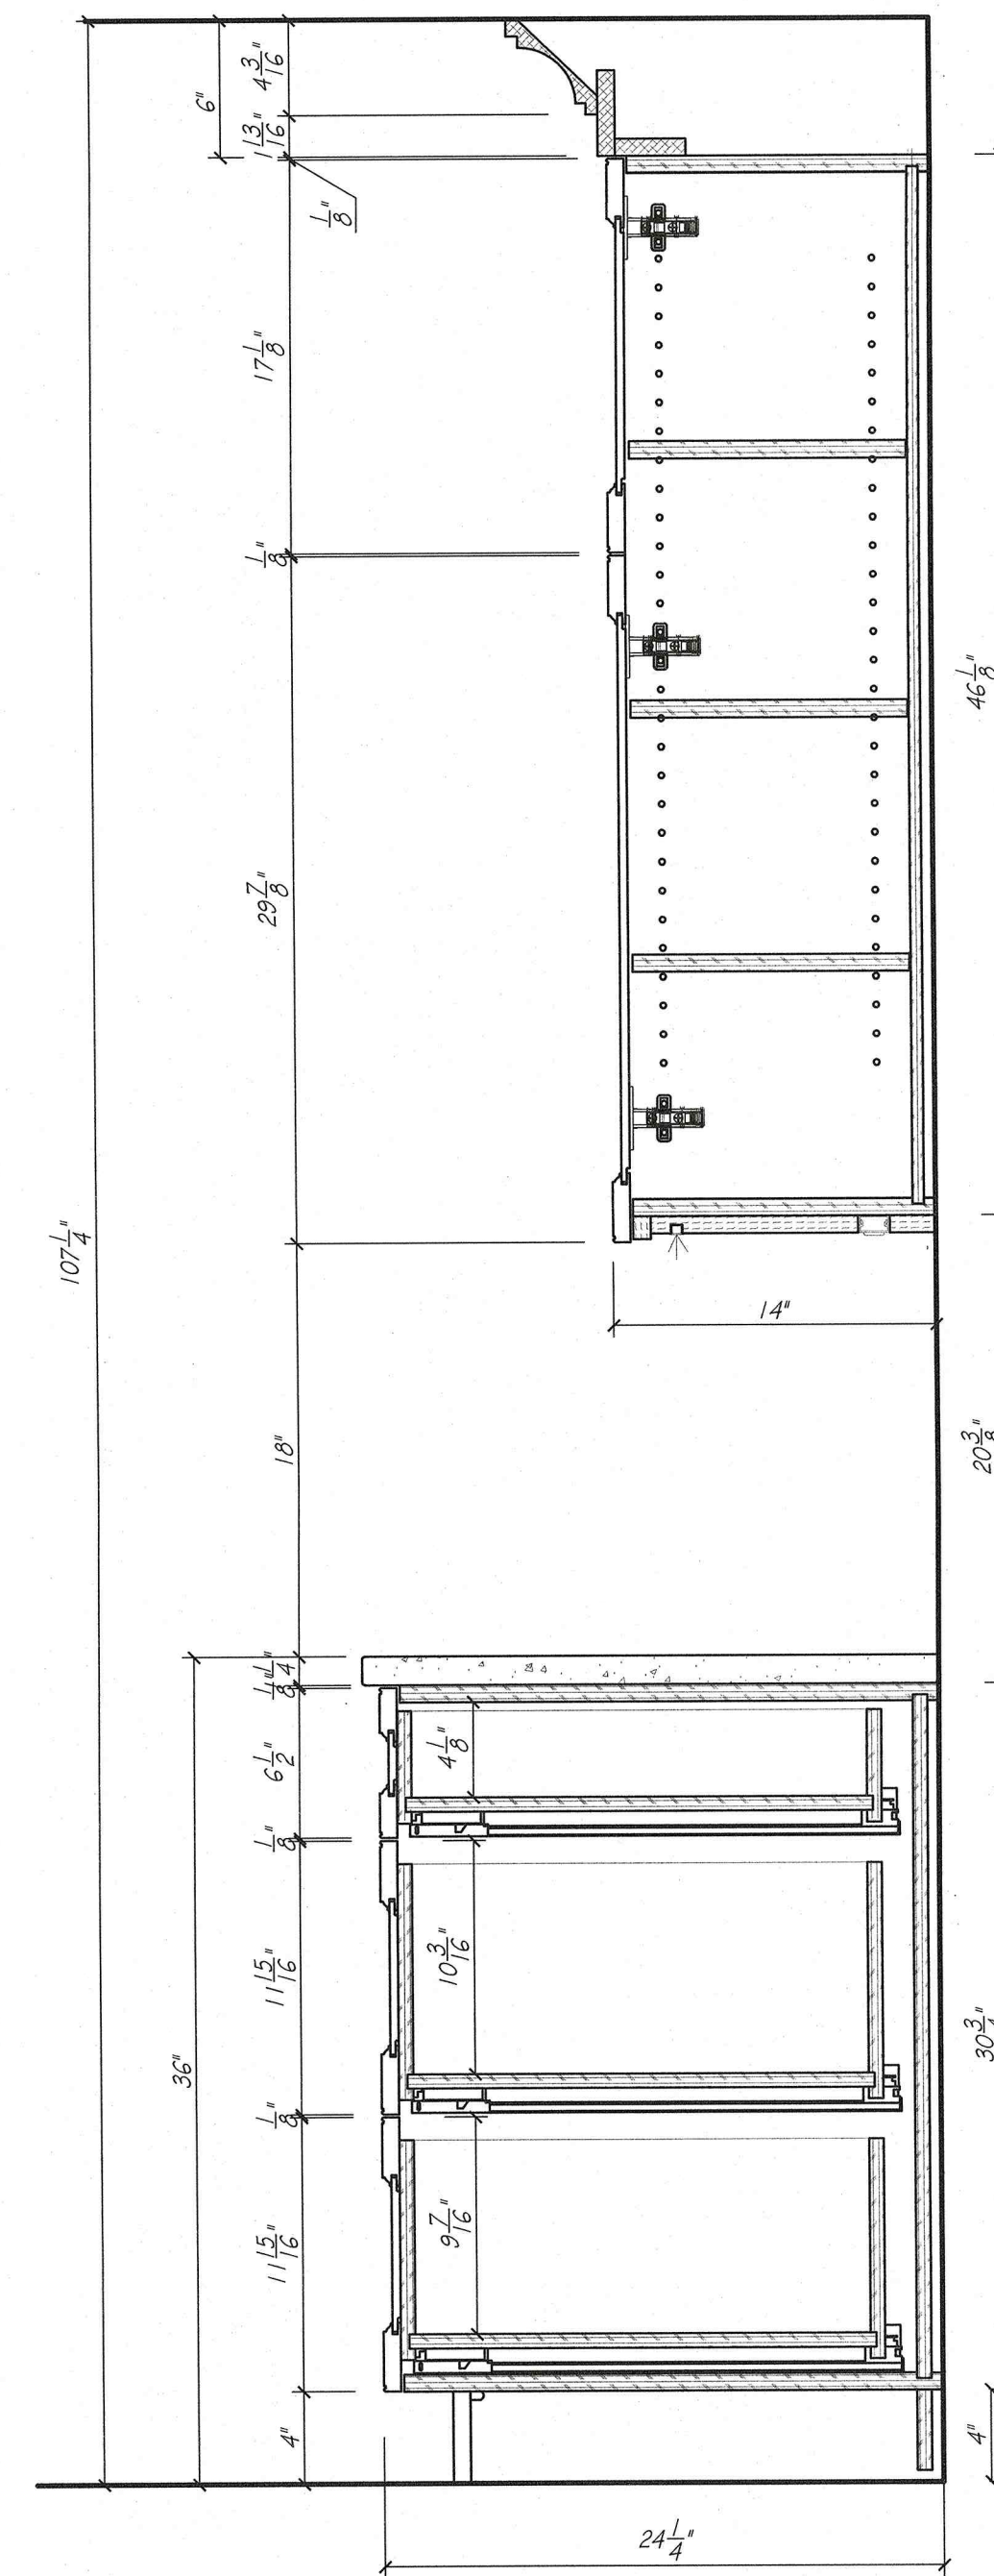

11
A3 CABINET DETAIL



SCALE: 1 1/2" = 1'-0"

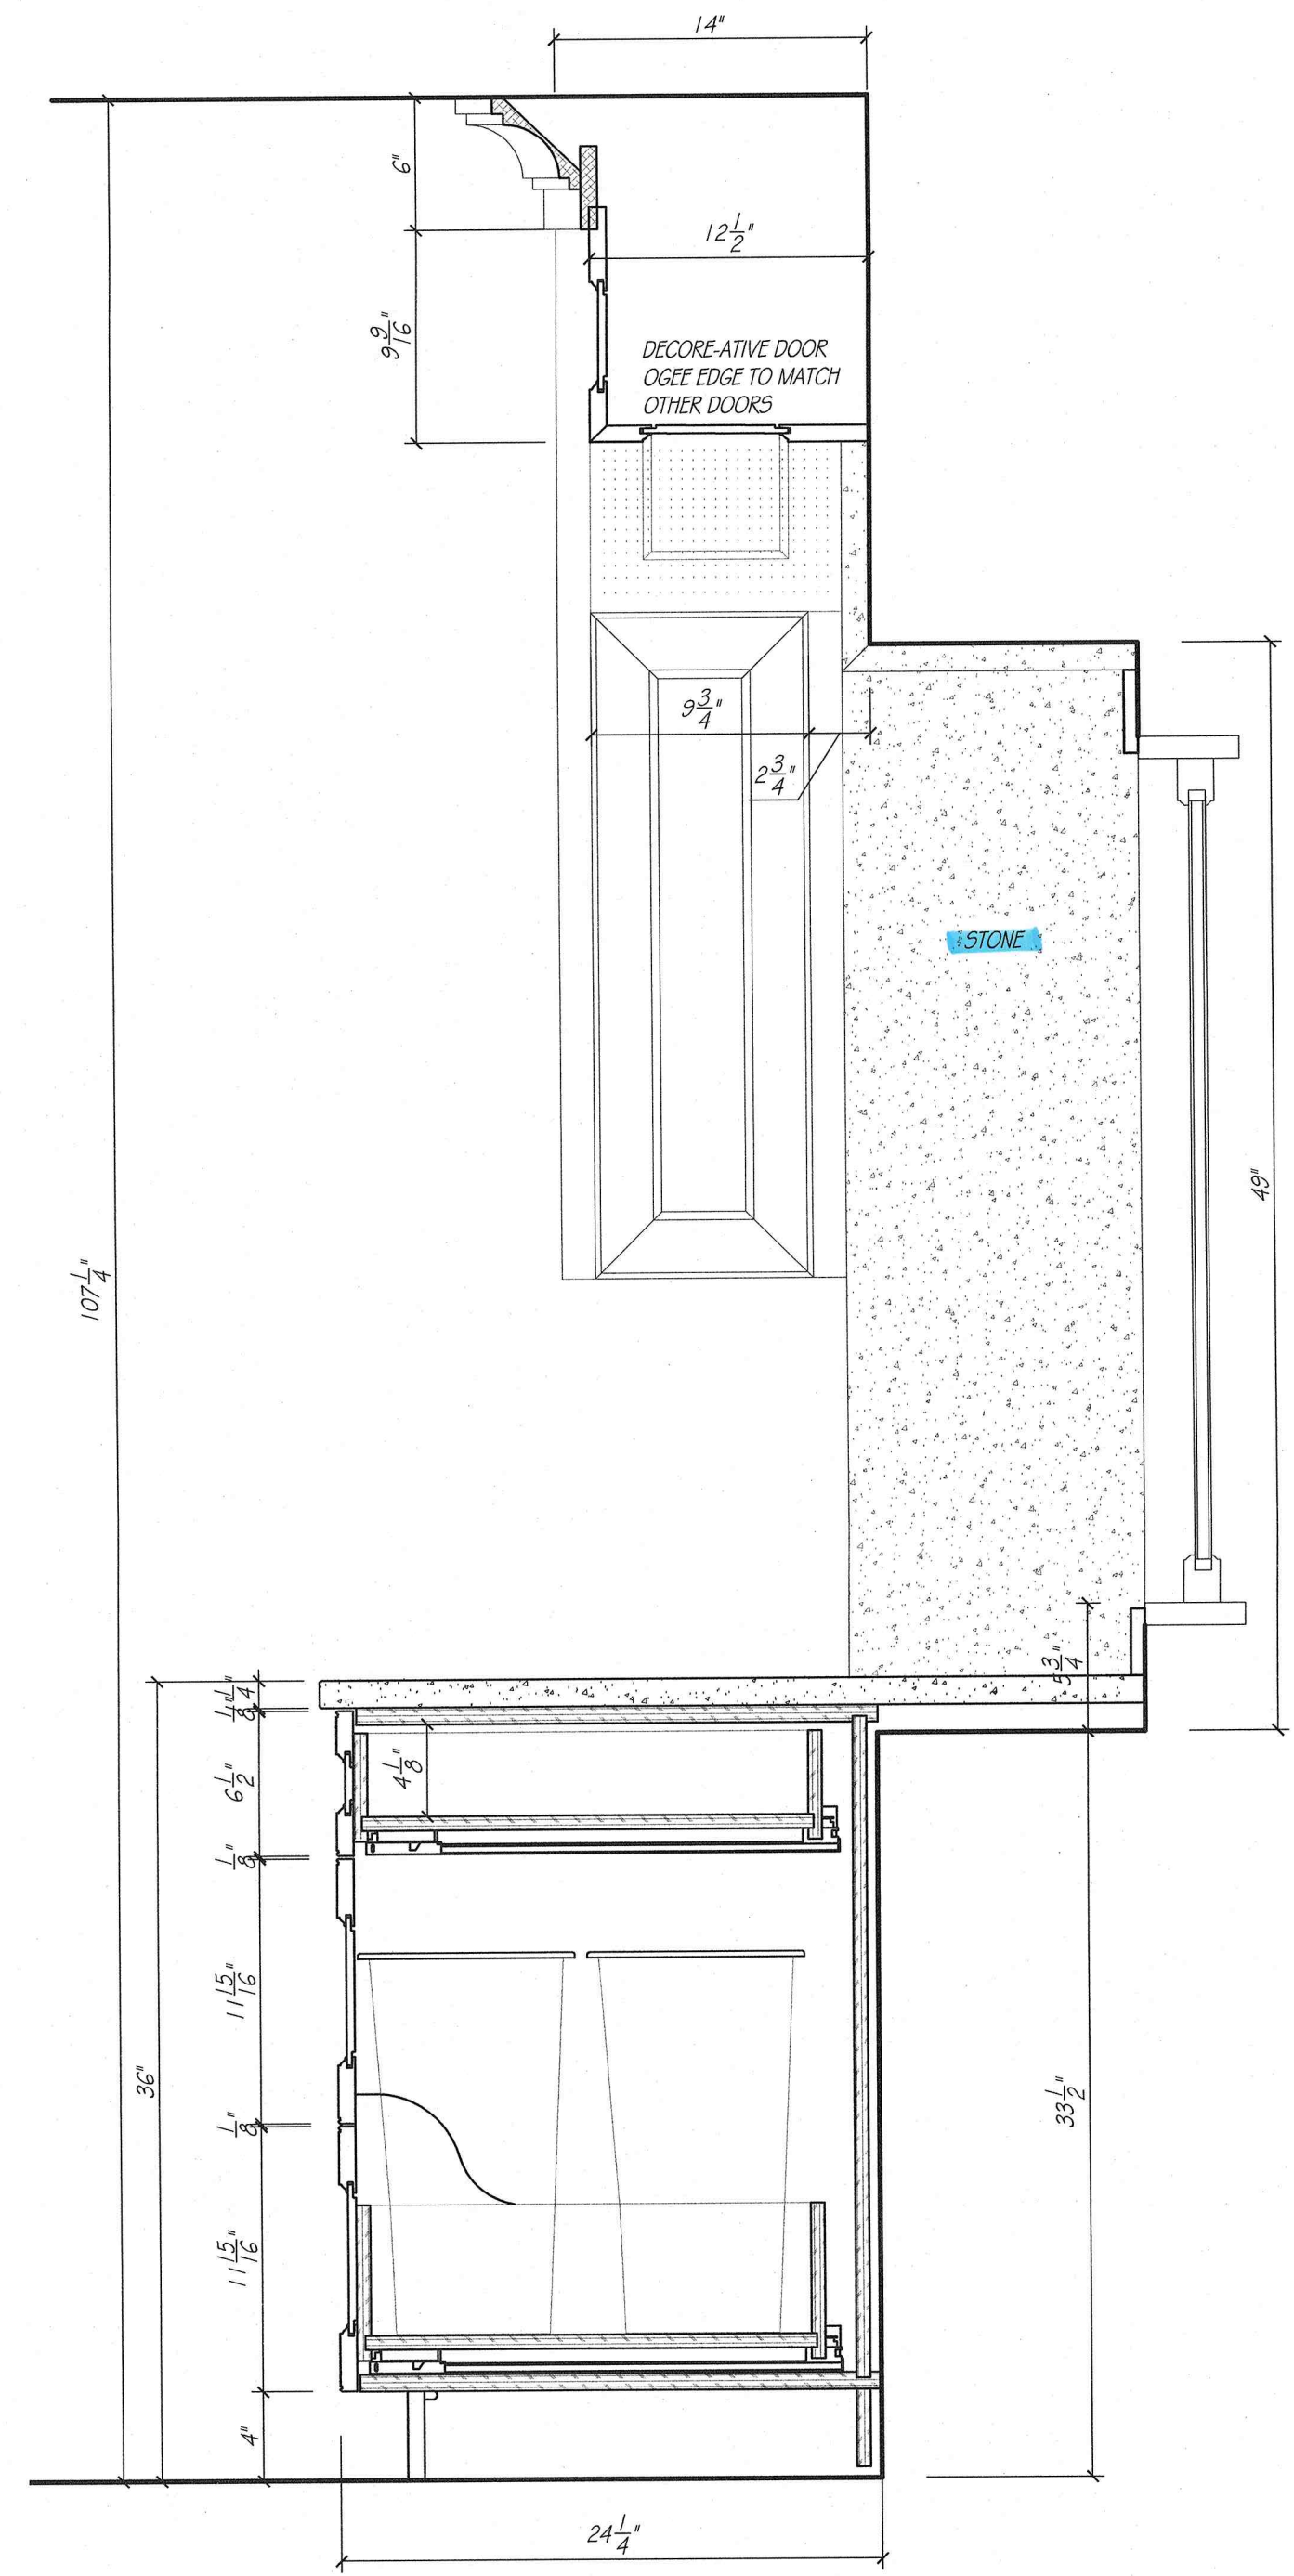

12
A3 CABINET DETAIL

SCALE: 1 1/2" = 1'-0"

Ogee EDGE TO MATCH
OTHER DOORS

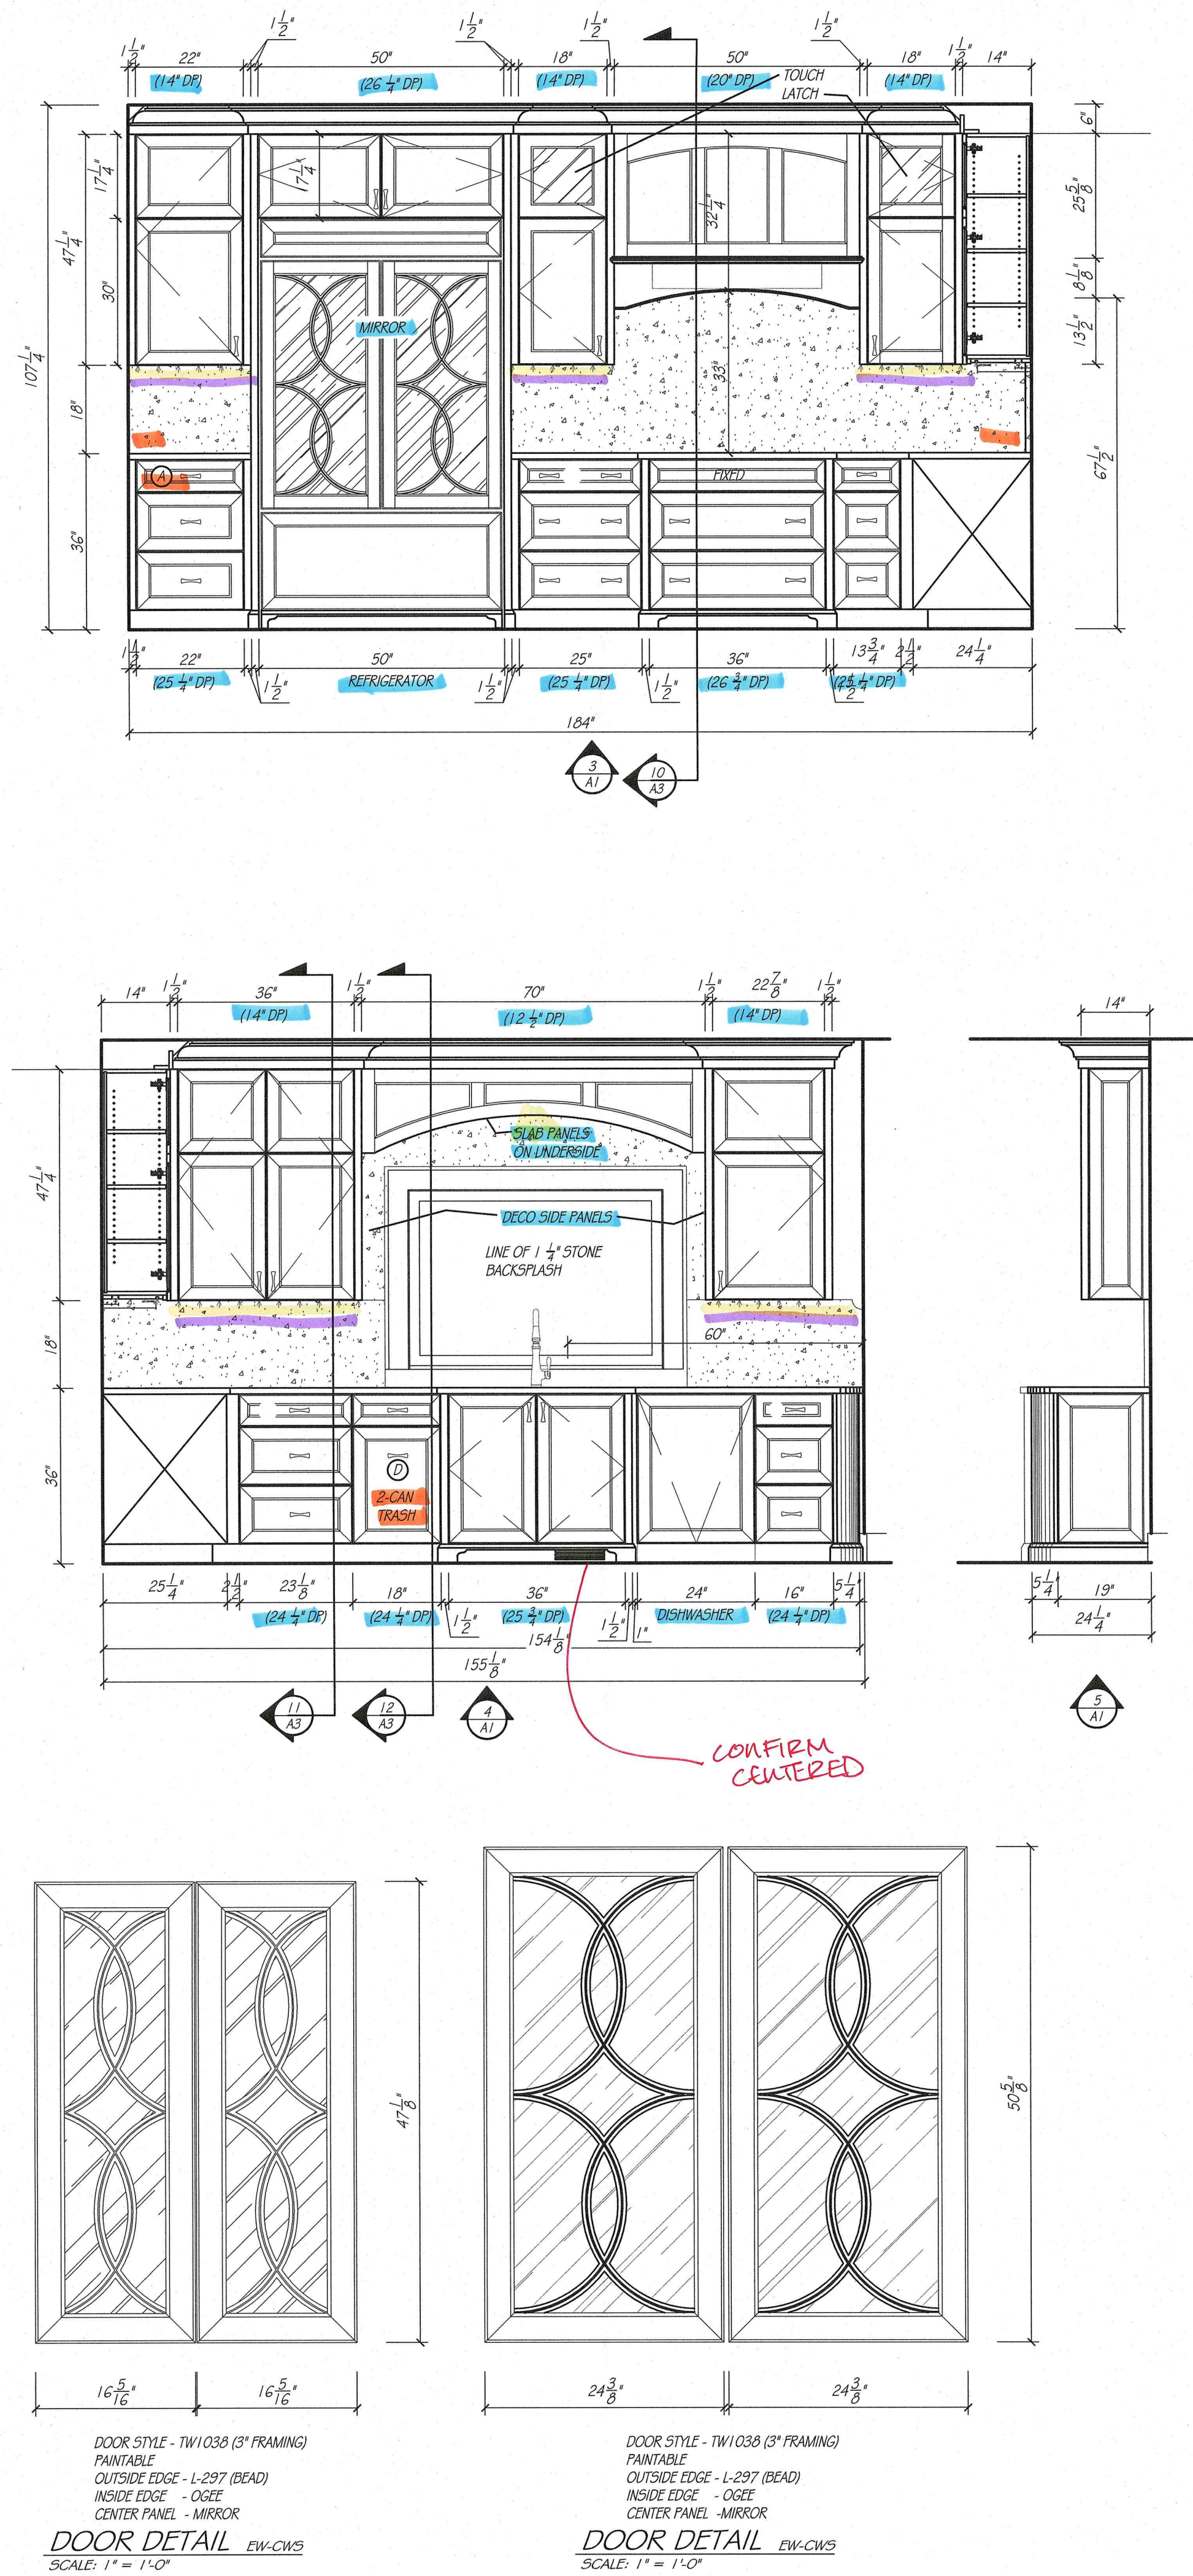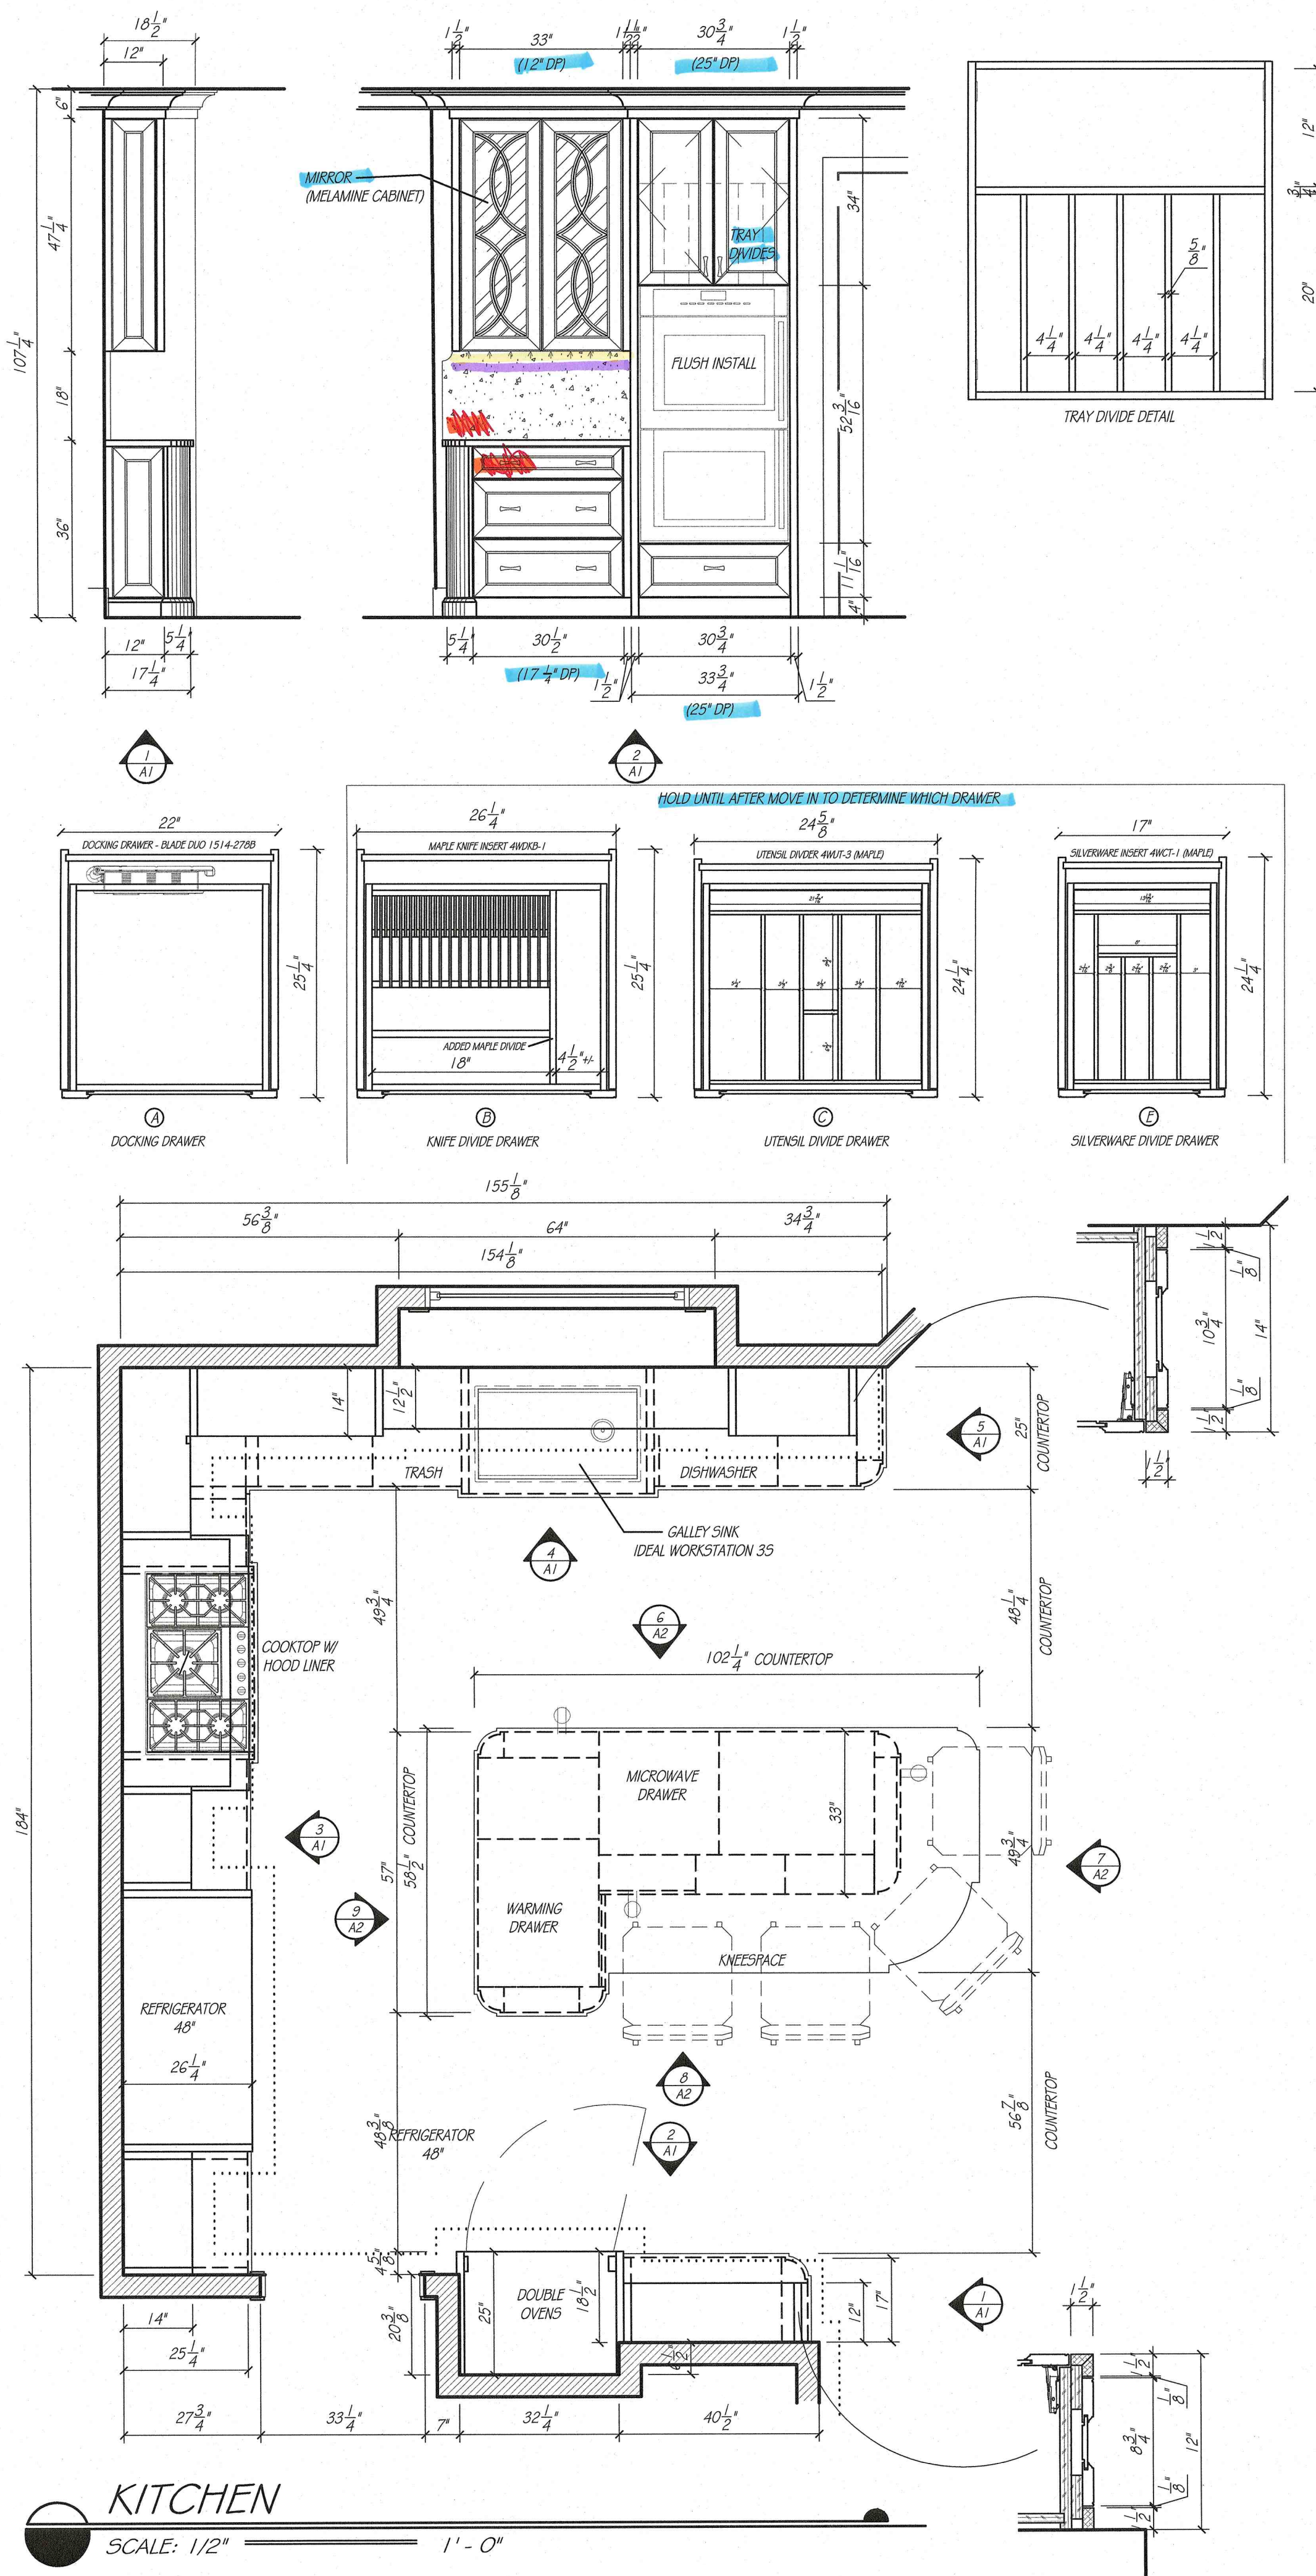

NOTES
DRAWER BOXES ARE MAPLE DOVETAIL DRAWERS






ACCESSORIES

- ① DOCKING DRAWER
BLADE DDD 1514-2788
- ② DOUBLE KNIFE BLOCK 4WCKB-1 (MAPLE)
REV-A-SHELF
- ③ UTENSIL DIVIDER 4WUT-3 (MAPLE)
REV-A-SHELF
- ④ 2-CAN TRASH PULLOUT 35QT (MAPLE)
4WCSC-1835DM-2
- ⑤ SILVERWARE DIVIDE 4WCT-15H (MAPLE)

APPLIANCE SELECTIONS

- THERMADOR DOUBLE OVENS 30"
MODEL - MED302LWS
29 3/4" W x 52 1/2" T x 24 1/2" D
FLUSH INSTALL
CUTOUT
30 3/4" W x 52 1/2" T x 24 1/2" D
 - SUB-ZERO REFRIGERATOR 48"
MODEL - CL4850UDFO
48" W x 84" T x 24" D
PANELS
CUTOUT
50" W x 84" T x 26 5/8" D
 - THERMADOR COOKTOP 36"
MODEL - 503W365T5
37" W x 5 3/8" T x 21 1/2" D
 - AVALLON HOOD LINER 36"
MODEL - ARVH36A
34 1/2" W x 11 3/8" T x 22" D
 - THERMADOR DISHWASHER
MODEL - DWH6660EPR
23 7/8" W x 33 3/8" T x 23 3/4" D
PANEL
 - THERMADOR MICROWAVE DRAWER 24"
MODEL - MD24DS
23 3/8" W x 16 1/2" T x 23 3/8" D
FLUSH INSTALL
CUTOUT
22 1/8" W x 16 3/8" T x 23 1/2" D
 - THERMADOR WARMING DRAWER 30"
MODEL - WD30W
29 3/8" W x 9 7/8" T x 24 1/2" D
FLUSH INSTALL
CUTOUT
30" W x 9 7/8" T x 24 1/2" D
- APPLIANCE FRONTS TO BE INSTALLED
BY APPLIANCE COMPANY.
EUROWOOD TO ADJUST


KITCHEN	
CABINET CONSTRUCTION:	
EXTERIORS	PAINTABLE
INTERIORS	HARD ROCK MAPLE MELAMINE
DRAWER BOXES	MAPLE DOVETAIL
FACE BANDING	MATCHING WOOD EDGE BANDING
CABINET HARDWARE & DRILLING	BY OTHERS
DRAWER SLIDE	WALL EXT. SOFT CLOSE CONCEALED SLIDES
COUNTERTOP SPECIFICATIONS:	
COUNTERTOP MATERIAL	QUARTZ
COUNTERTOP THICKNESS	1 1/4" ALLOWANCE
SUBTOP REQUIREMENTS	NONE
ROOM SPECIFICATIONS	
FLOORING - TYPE / ALLOWANCE	VERIFY 3/4" ALLOWANCE
CASING - W / 1/4" REVEAL	3/4"

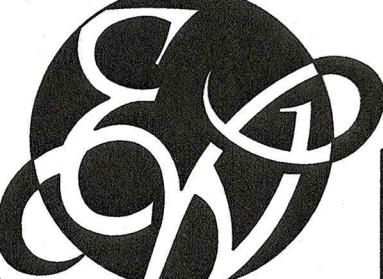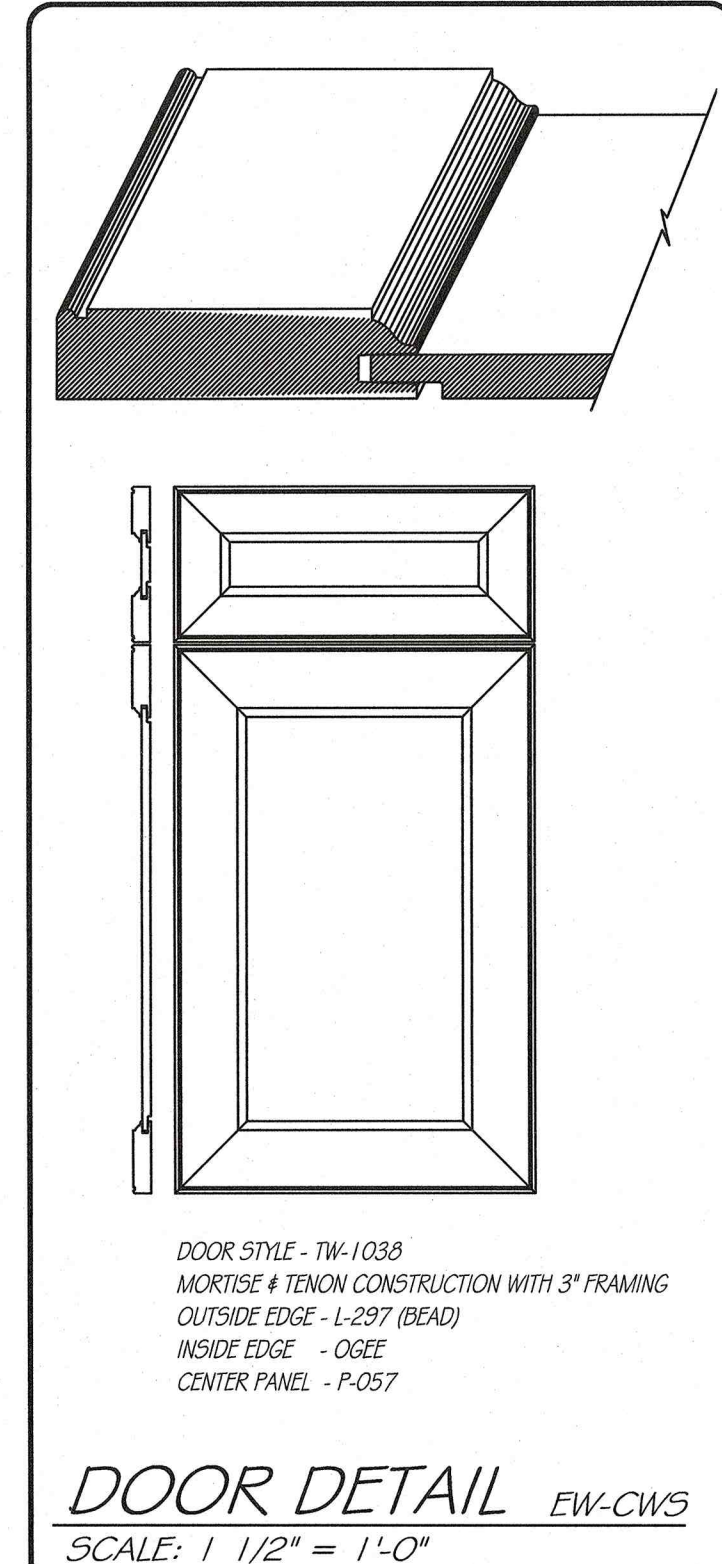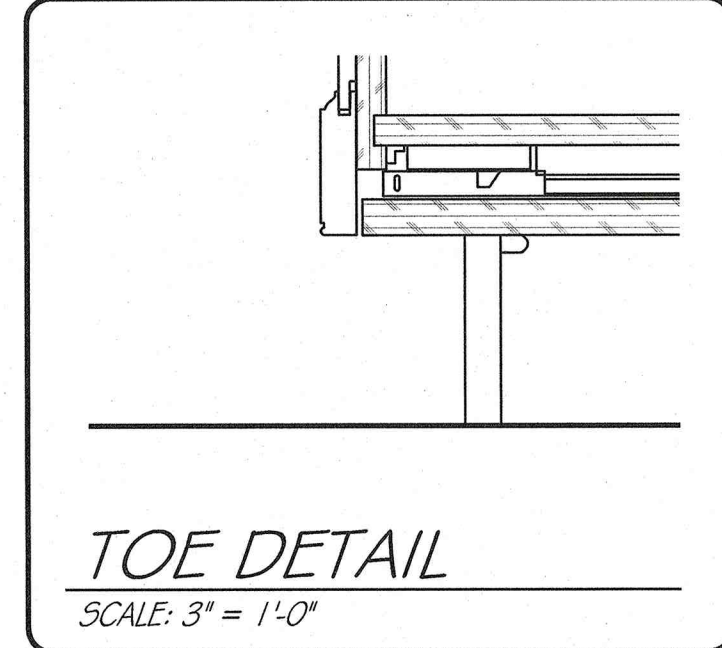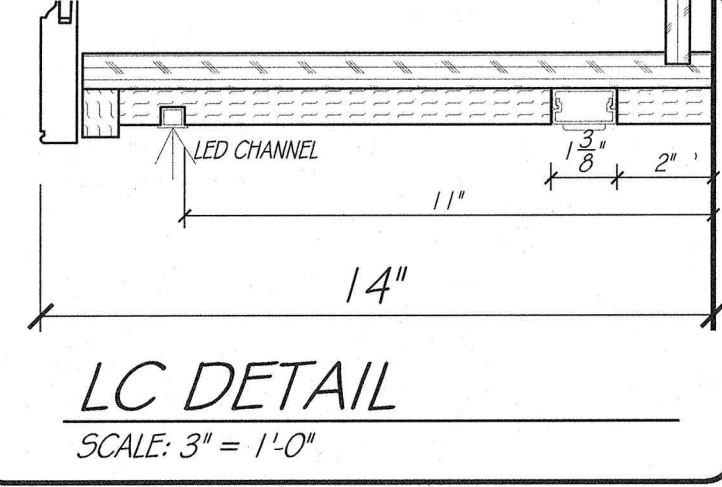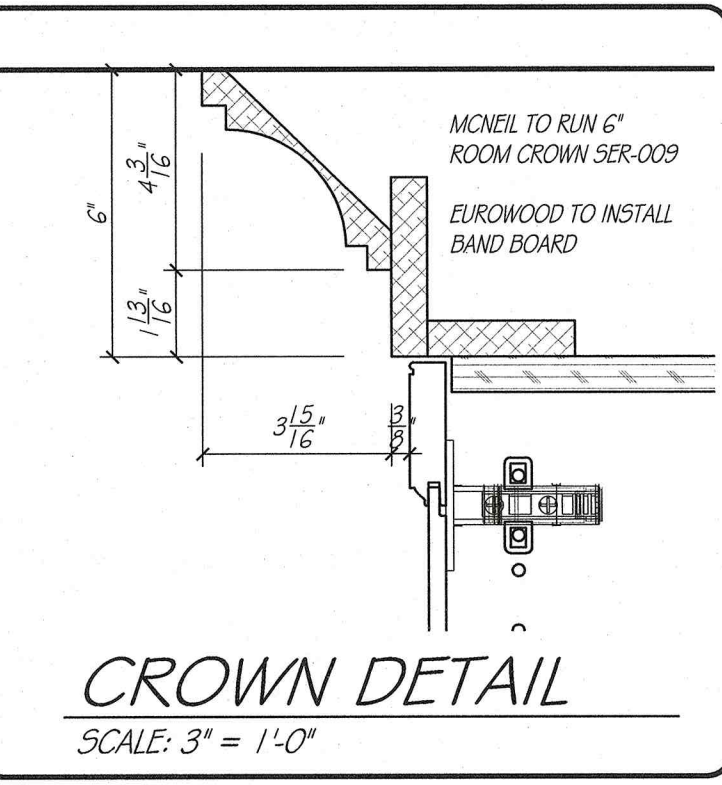

EUROWOOD
Cabinets INC.
3415 SO. 67TH ST.
OMAHA, NE 68106
TEL (402-393-4110)
FAX (402-393-8361)
(WWW.EUROWOOD.NET)


SHEET: A/I
DRAWN BY: SJB
PLAN: MAIN LEVEL KITCHEN
REVISIONS:
19 MARCH 26
11 JUNE 26
23 JUNE 26
2 JULY 26
8 JULY 26
10 JULY 26
24 JULY 26
27 AUGUST 26

PHIL & MICHELLE WOOD
3435 N. 140TH. CIRCLE
OMAHA, NE 68164

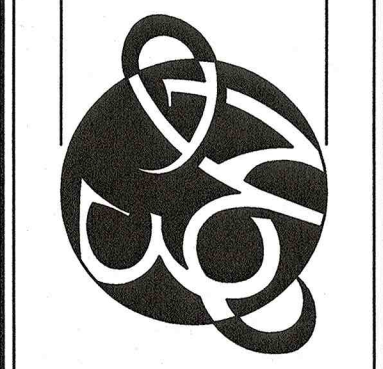


APPROVED BY:
SIGNATURE
DATE
WOOD
5588




DUPLICATION OF THESE DRAWINGS IS
PROHIBITED WITHOUT WRITTEN CONSENT
BY EUROWOOD CABINETS
©2000, EUROWOOD CABINETS INC.
MEASUREMENTS ARE SUBJECT TO CHANGE
DUE TO FINAL FIELD MEASUREMENTS.

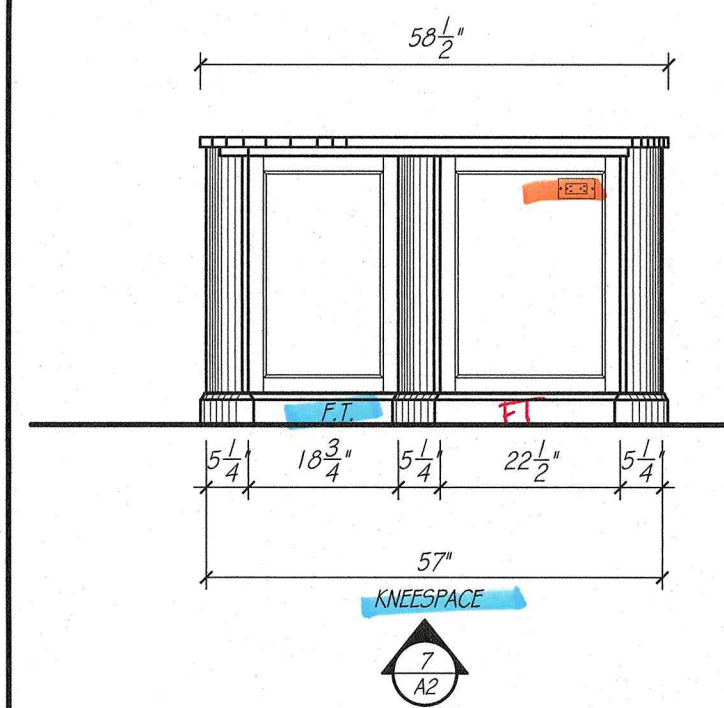


SHALLOW SPICE CABINET
2 3/8" SHELF DEPTH

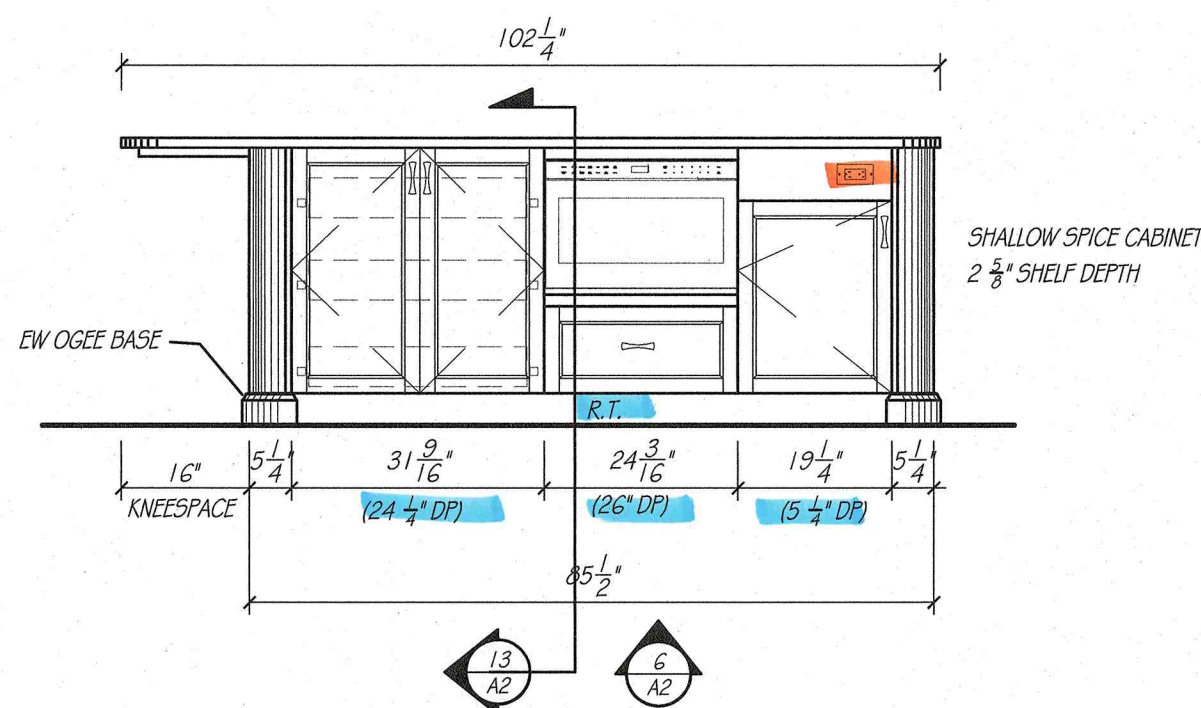


SHALLOW SPICE CABINET
2 3/8" SHELF DEPTH

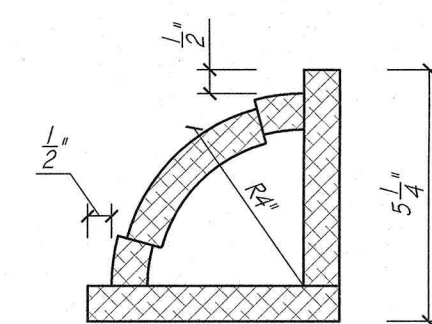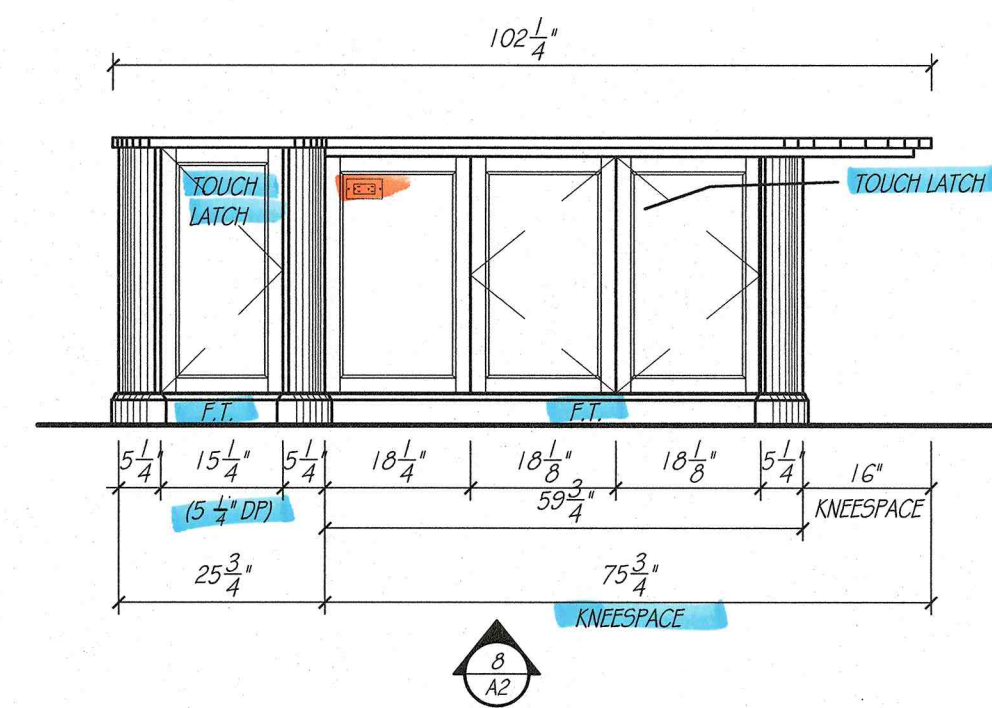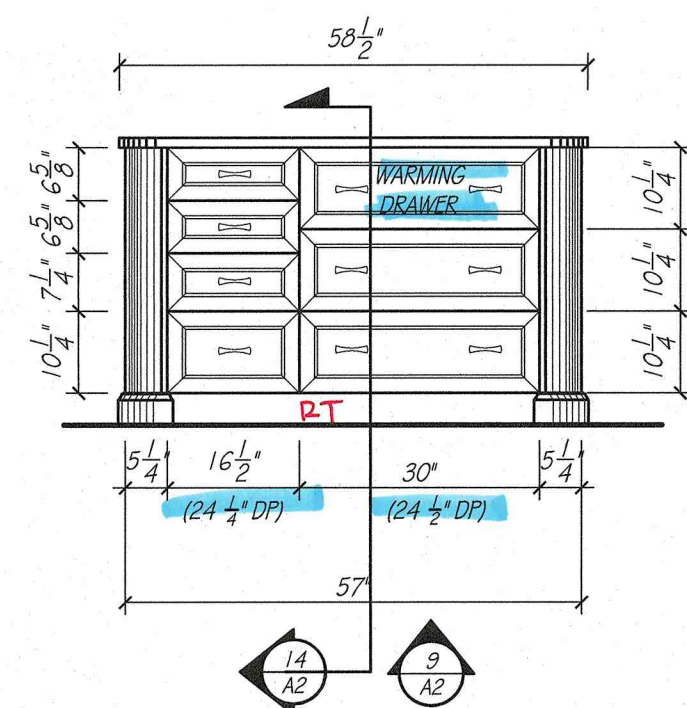

RADIUS CORNER DETAIL
SCALE: 3" = 1'-0"

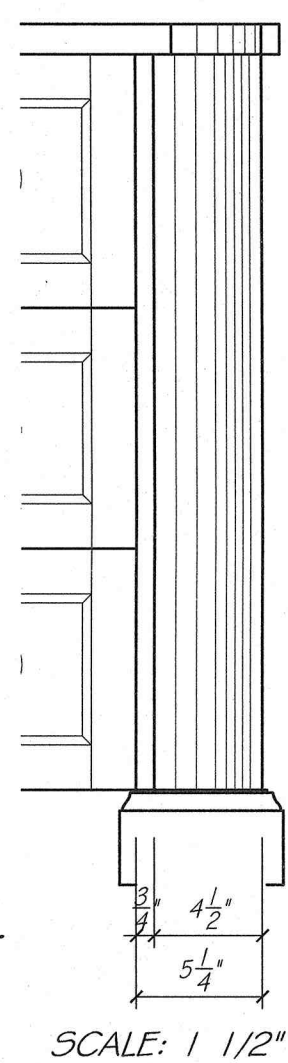


SCALE: 1 1/2" = 1'-0"

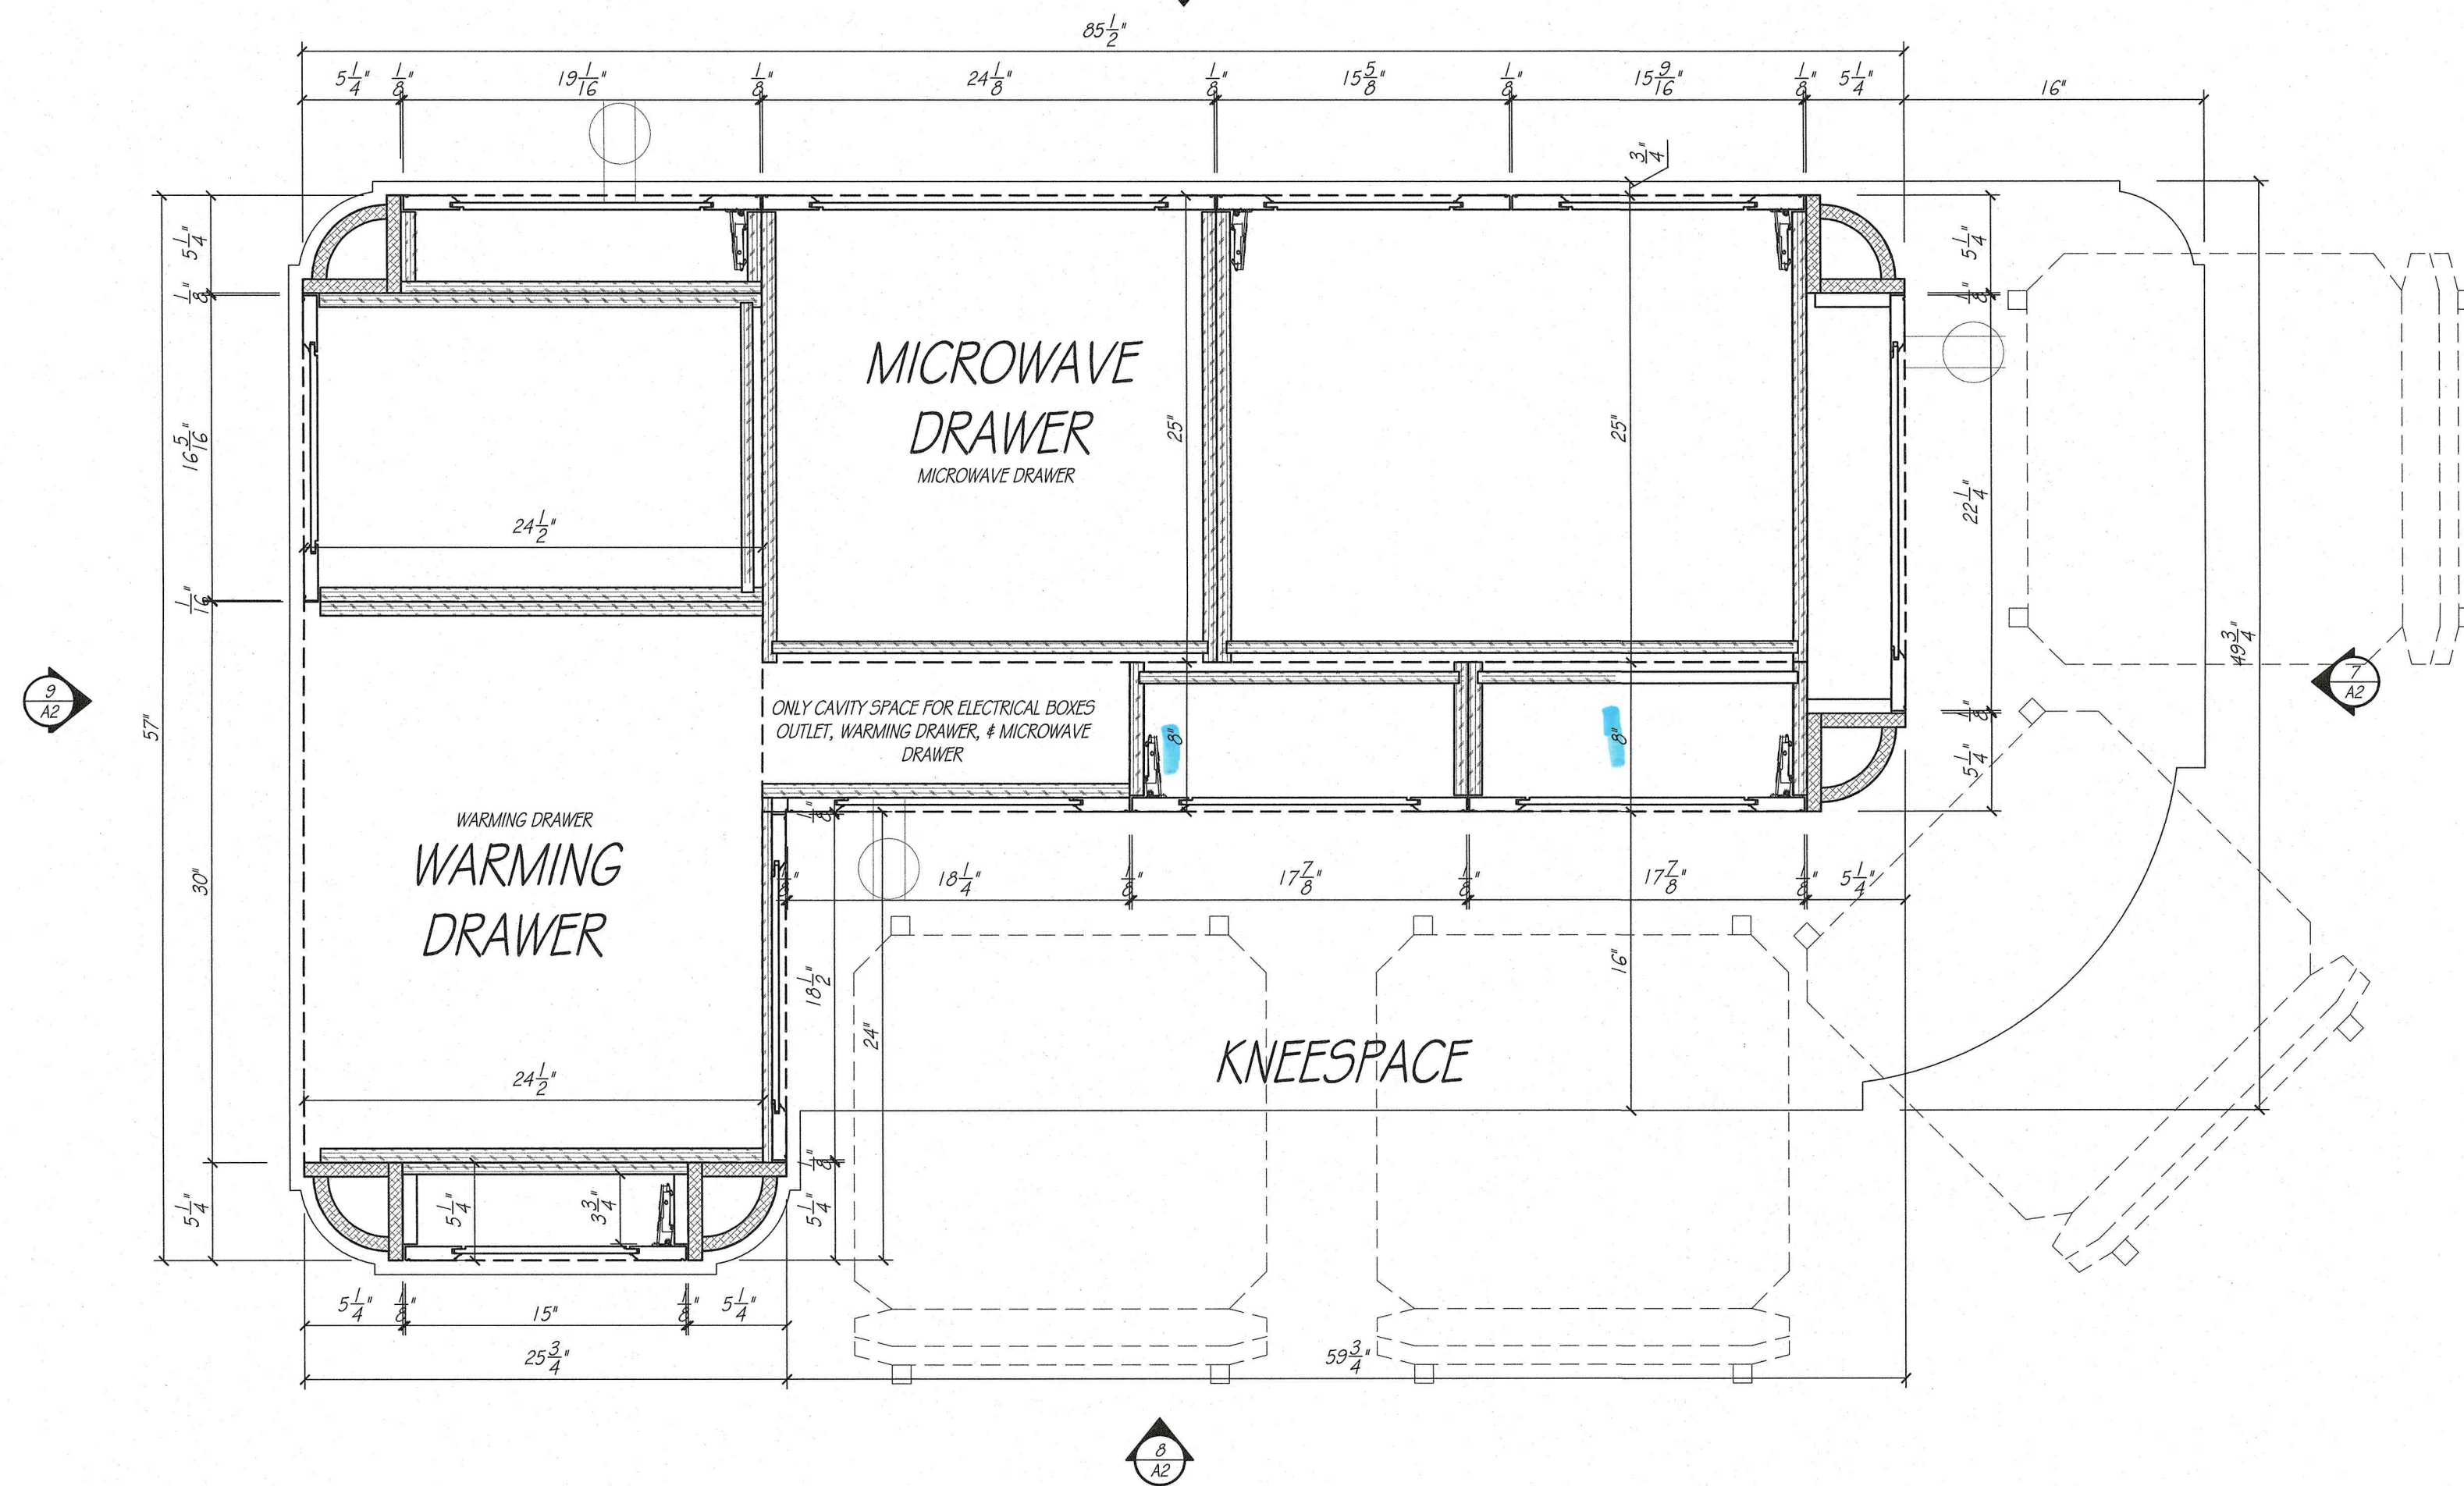


KITCHEN ISLAND

SCALE: 1 1/2" = 1'-0"

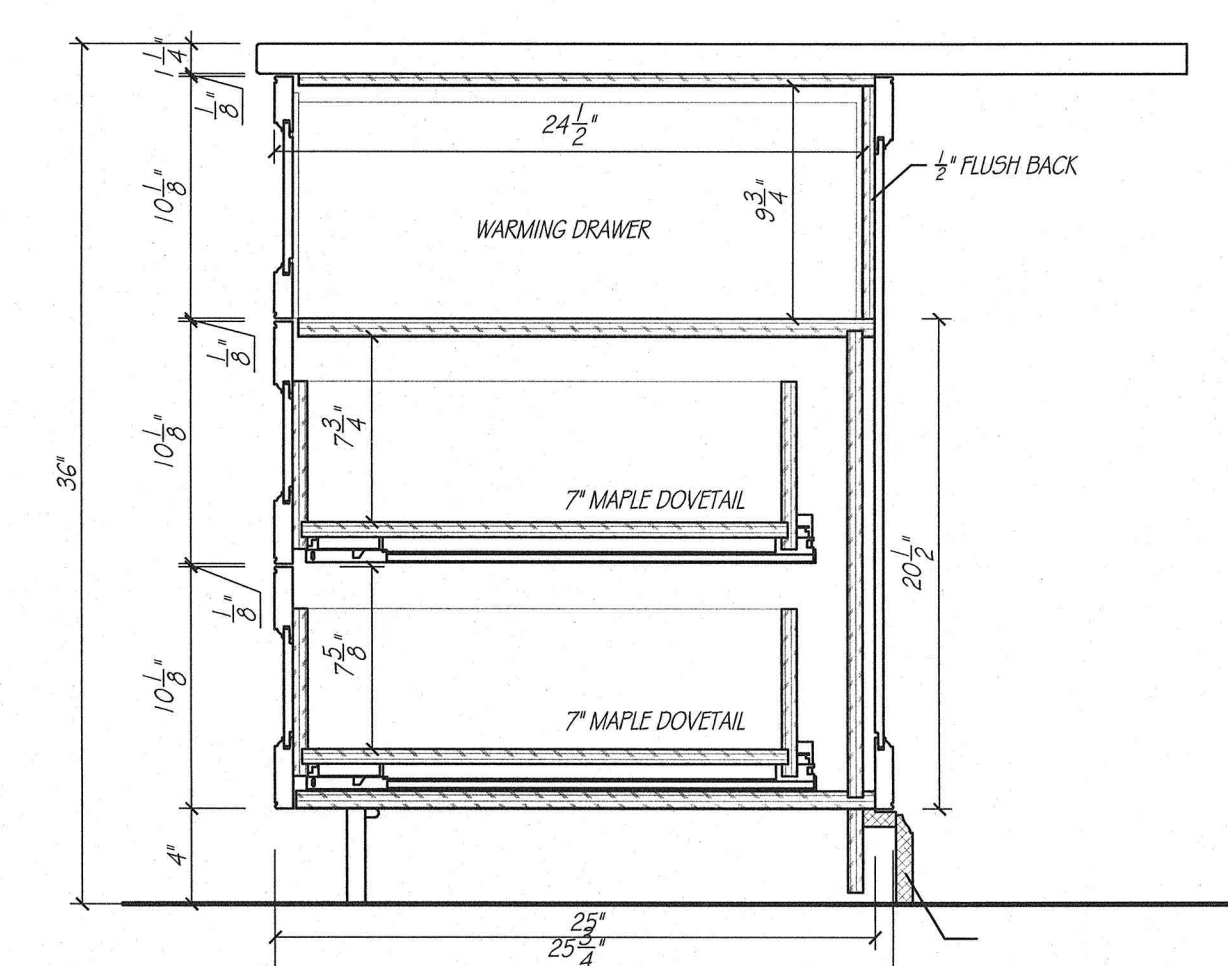


THERMADOR WARMING DRAWER 30"
MODEL - WD30W

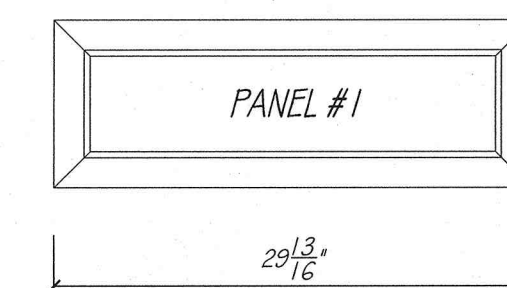


PANEL #1 29 13/16" W x 10 1/8" H
PANEL ATTACHES FROM BACK

PANEL IS LARGER THAN MINIMUM


PROVIDE BLOCKING STRIPS
2 @ 3 1/2" W x 9 3/4" T x 3/4" D
SET BACK FROM CABINET FACE 1"

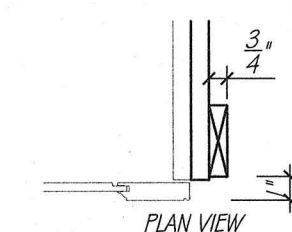



WD CABINET DETAIL
SCALE: 1 1/2" = 1'-0"

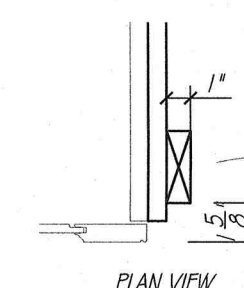

PLAN VIEW

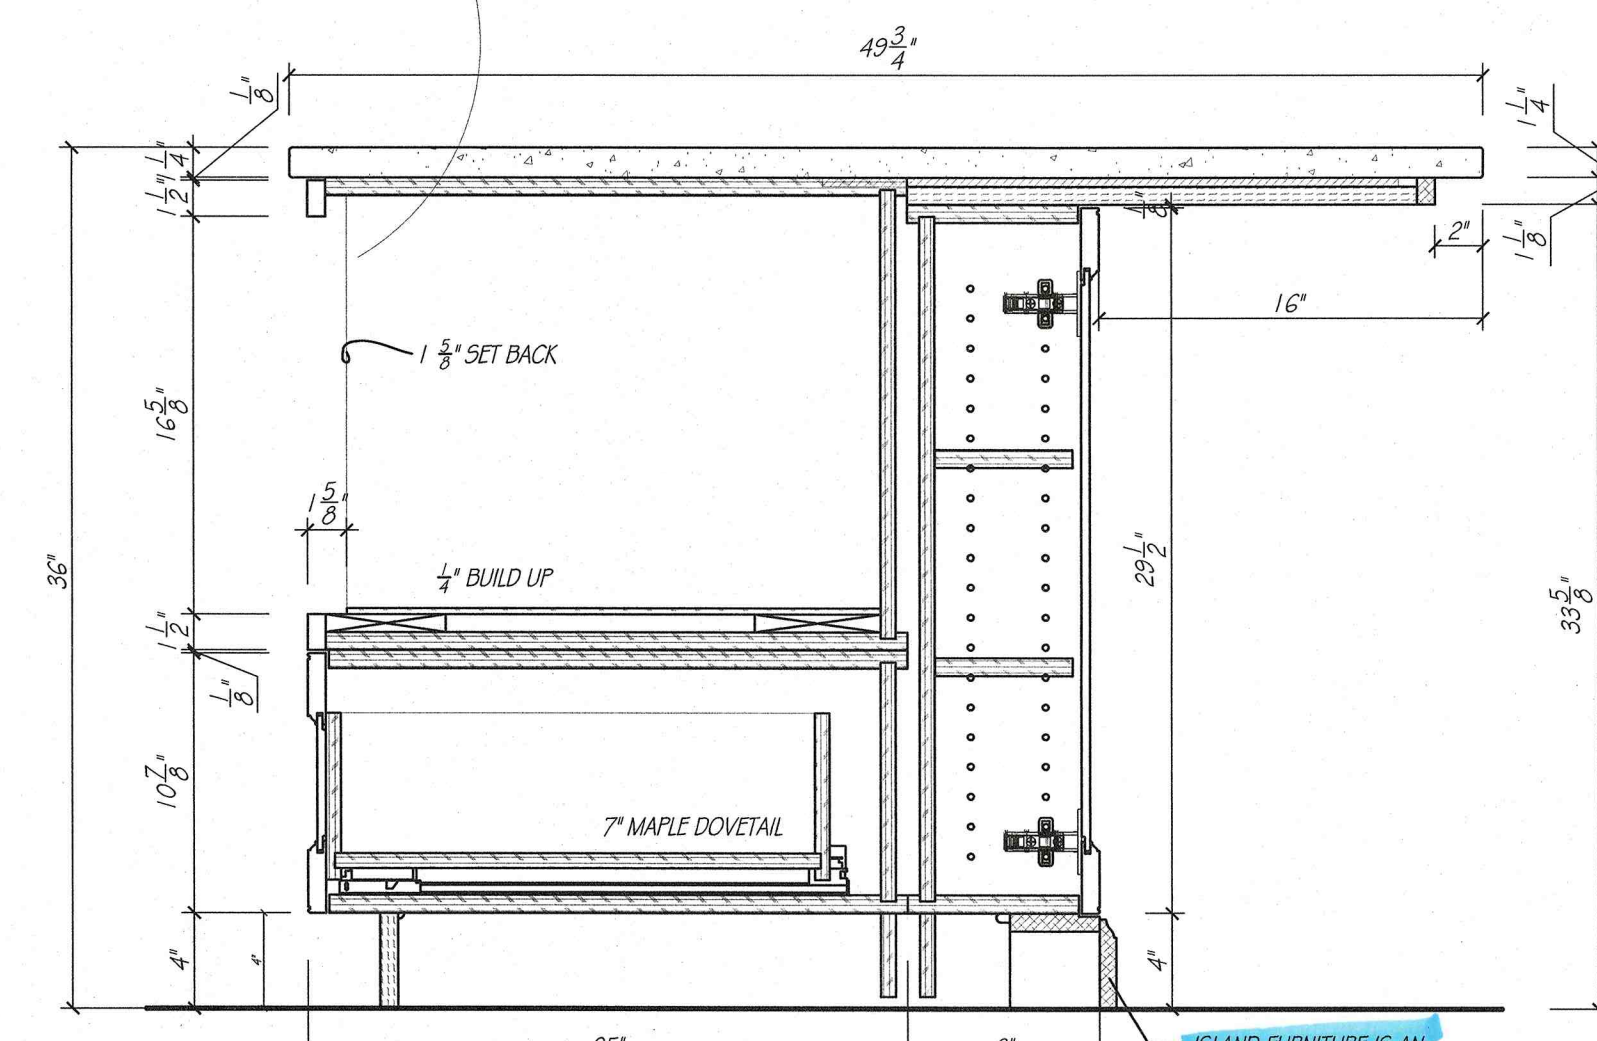

MICROWAVE DRAWER DTL.
SCALE: 1 1/2" = 1'-0"

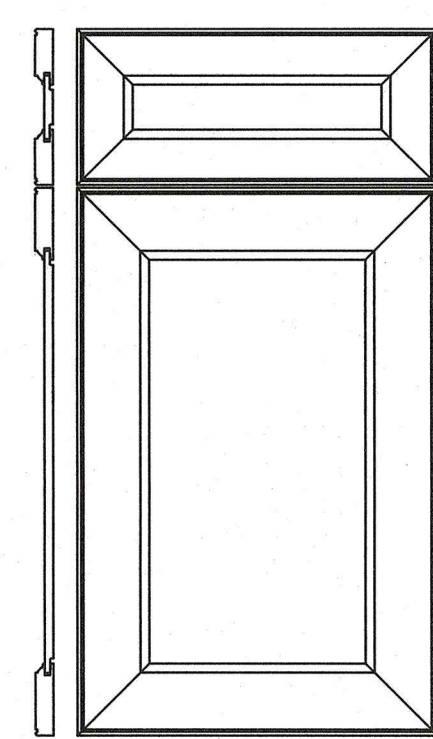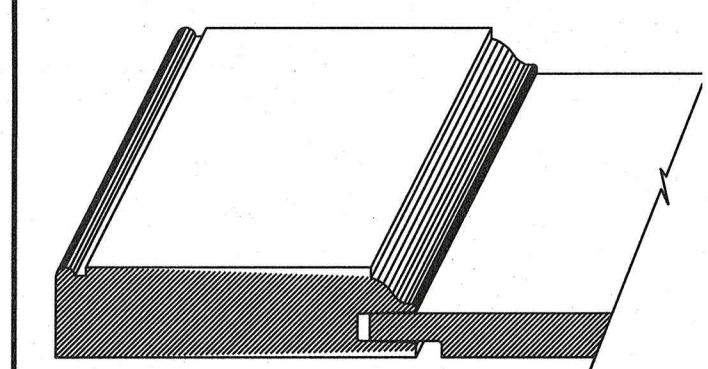

DOOR STYLE - TW-1036
MORTISE & TENON CONSTRUCTION WITH 3" FRAMING
OUTSIDE EDGE - L-297 (BEAD)
INSIDE EDGE - DGE
CENTER PANEL - P-057

DOOR DETAIL EW-CWS
SCALE: 1 1/2" = 1'-0"


KITCHEN ISLAND	
CABINET CONSTRUCTION:	
EXTERIORS	FLAT CUT CHERRY
INTERIORS	HARD ROCK MAPLE MELAMINE
DRAWER BOXES	MAPLE DOVETAIL
FACE BANDING	MATCHING WOOD EDGE BANDING
CABINET HARDWARE & DRILLING	BY OTHERS
DRAWER SLIDE	FULL EXT. SOFT CLOSE CONCEALED SLIDES
COUNTERTOP SPECIFICATIONS:	
COUNTERTOP MATERIAL	QUARTZ
COUNTERTOP THICKNESS	1 1/4" ALLOWANCE
SUBTOP REQUIREMENTS	NONE
ROOM SPECIFICATIONS	
FLOORING - TYPE / ALLOWANCE	VERIFY 3/4" ALLOWANCE
CASING - W/ 1/4" REVEAL	3/4"

EUROWOOD
Cabinets Inc.
3415 SO. 67TH ST.
OMAHA, NE 68106
TEL (402-393-4110)
FAX (402-393-8361)
(WWW.EUROWOOD.NET)

SHEET: A2
DRAWN BY: SJB
PLAN: MAIN LEVEL
KITCHEN

REVISIONS:
19 MARCH 26
11 JUNE 26
23 JUNE 26
2 JULY 26
8 JULY 26
10 JULY 26
24 JULY 26
27 AUGUST 26



PHIL & MICHELLE WOOD
3435 N. 140TH. CIRCLE
OMAHA, NE 68164

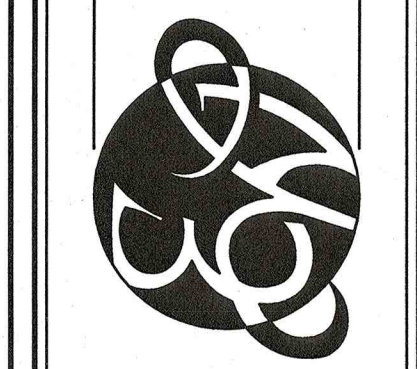


APPROVED BY:
SIGNATURE
DATE

WOOD
5588


DUPLICATION OF THESE DRAWINGS IS PROHIBITED WITHOUT WRITTEN CONSENT BY EUROWOOD CABINETS. ©2000, EUROWOOD CABINETS INC. MEASUREMENTS ARE SUBJECT TO CHANGE DUE TO FINAL FIELD MEASUREMENTS.

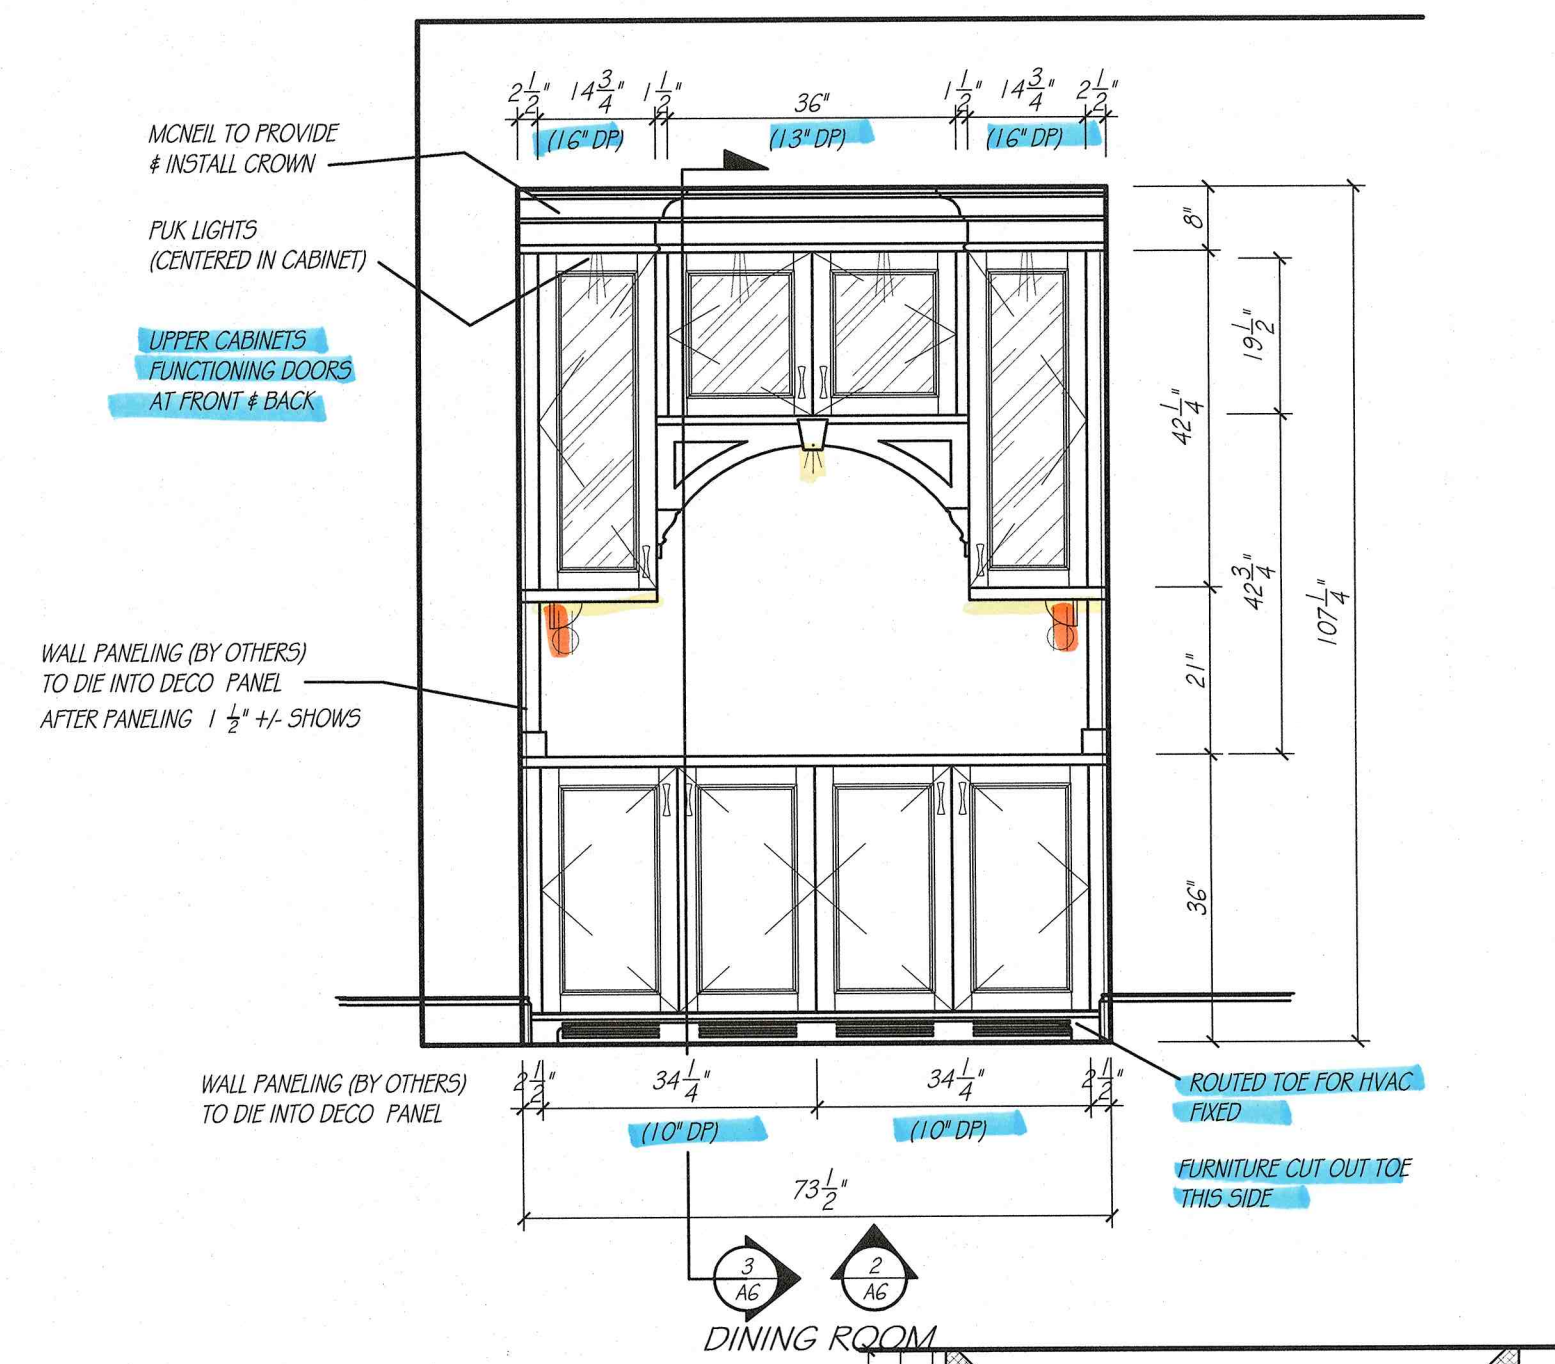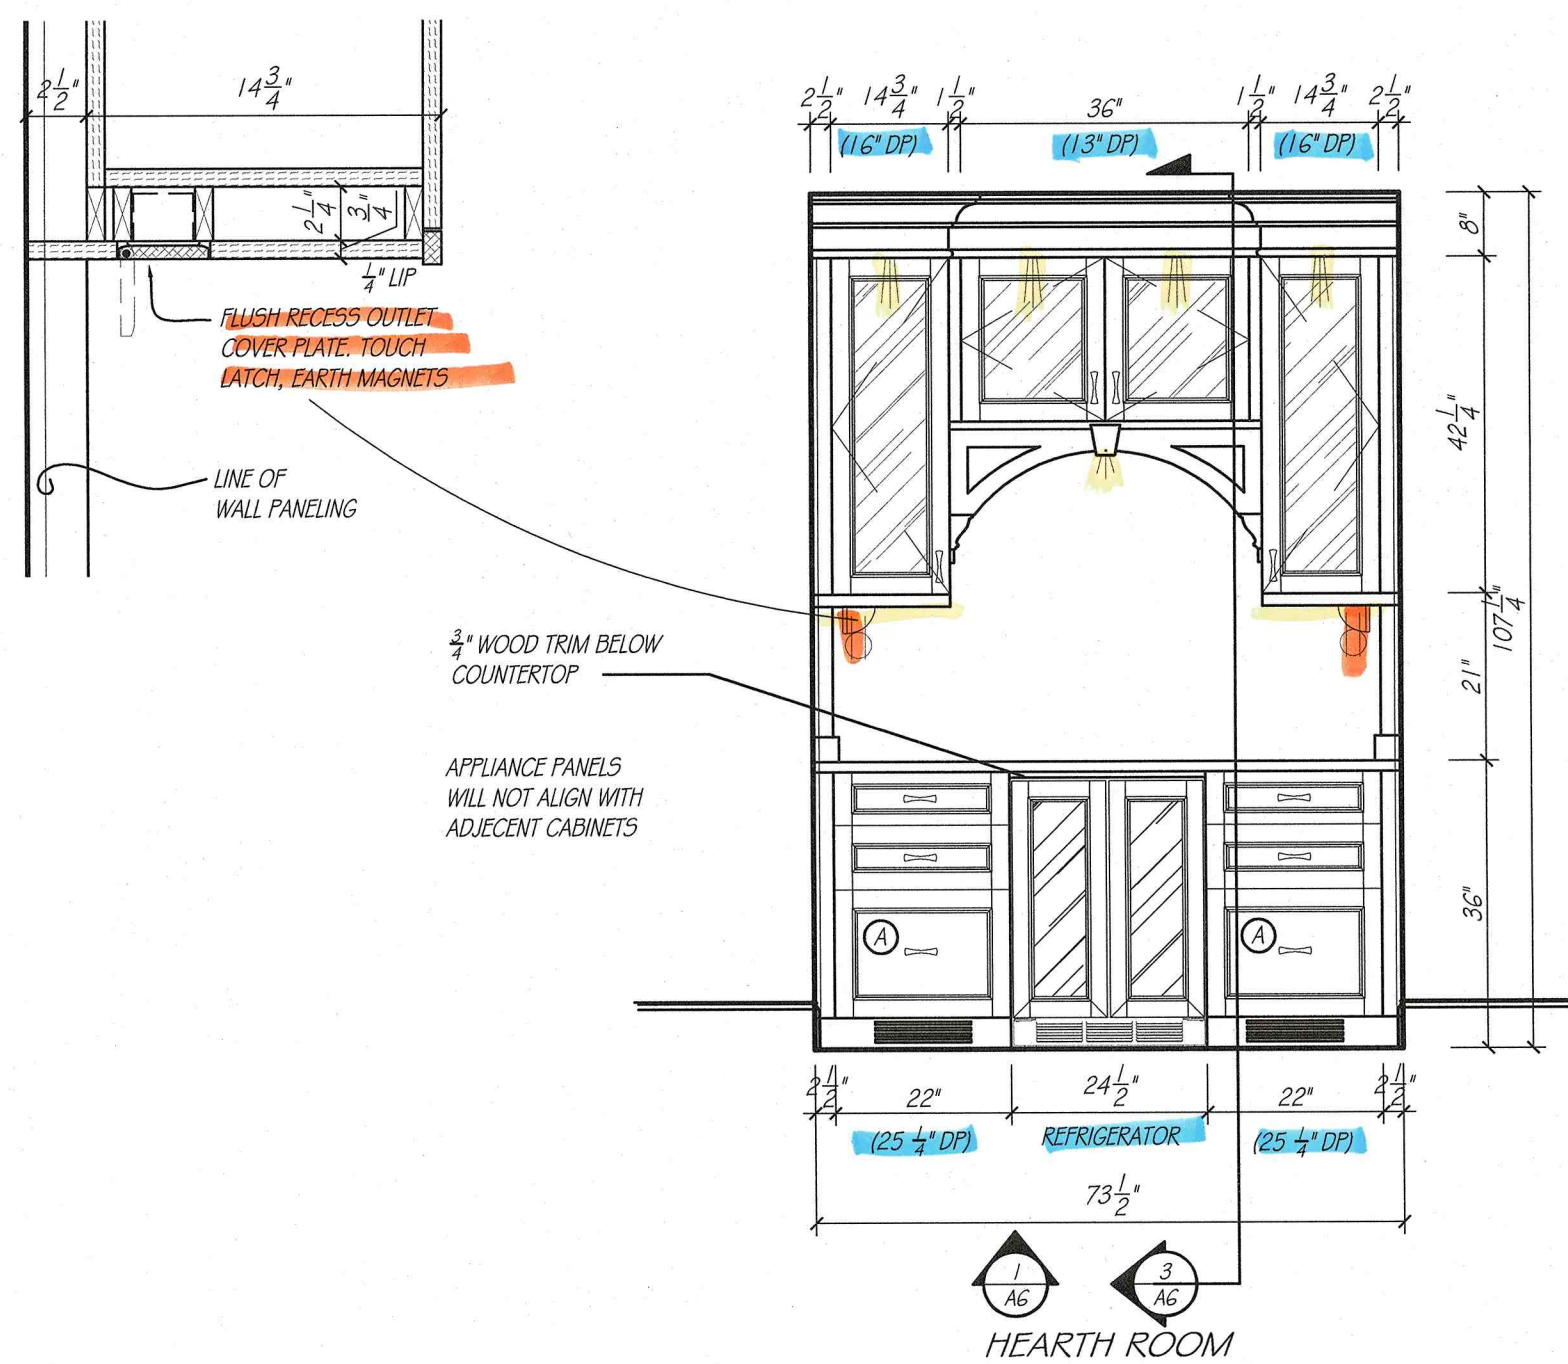

AVALLON BEVERAGE REFRIGERATOR
MODEL - AWBC242GGFDPRG

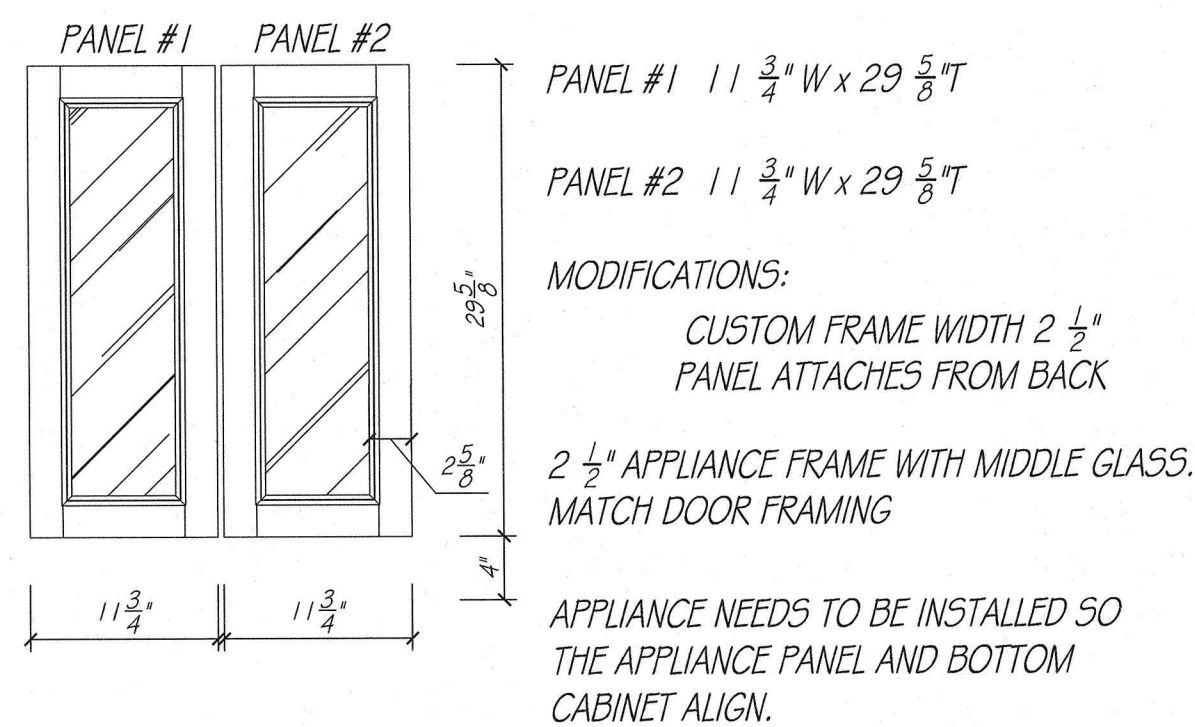

BASED ON APPLIANCE SPECS PANELS WILL NOT ALIGN WITH CABINET FRONTS.

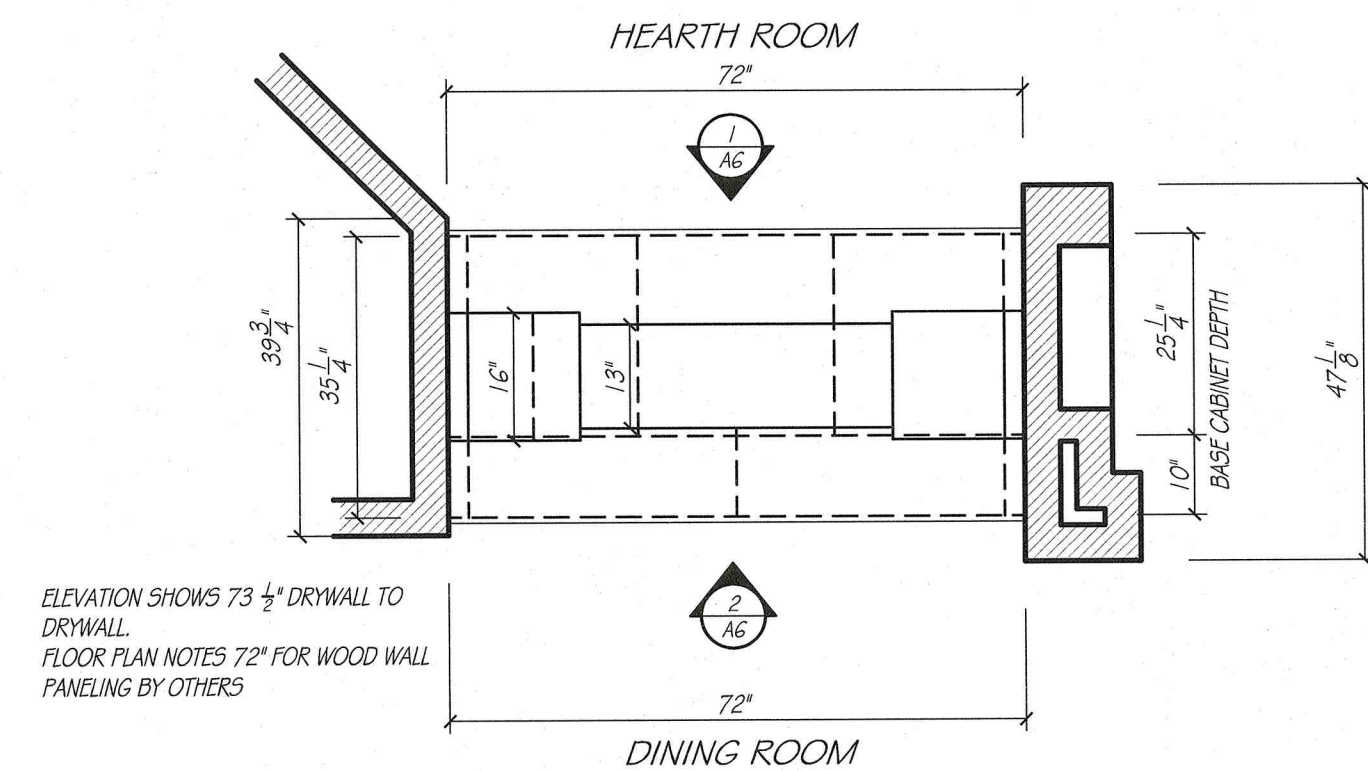

HEARTH ROOM / DINING
SCALE: 1/2\"/>

- NOTES:
- ① STEALTH LOCK (HARDWIRED)
 - ② AIR HINGES ON GLASS CABINETS

APPLIANCE SELECTIONS

AVALLON BEVERAGE REFRIGERATOR 24\"/>

APPLIANCE FRONTS TO BE INSTALLED BY APPLIANCE COMPANY. EUROWOOD TO ADJUST

DINING / HEARTH ROOM

CABINET CONSTRUCTION:


EXTERIORS	PAINTEABLE
INTERIORS	HARD ROCK MAPLE MELAMINE
DRAWER BOYES	HARD ROCK MAPLE MELAMINE
FACE BANDING	MATCHING WOOD EDGE BANDING
CABINET HARDWARE & DRILLING	BY OTHERS
DRAWER SLIDE	FULL EXT. SOFT CLOSE CONCEALED SLIDES

COUNTERTOP SPECIFICATIONS:


COUNTERTOP MATERIAL	QUARTZ
COUNTERTOP THICKNESS	1 1/4\"/>

ROOM SPECIFICATIONS


FLOORING - TYPE / ALLOWANCE	WOOD 3/4\"/>
-----------------------------	--------------

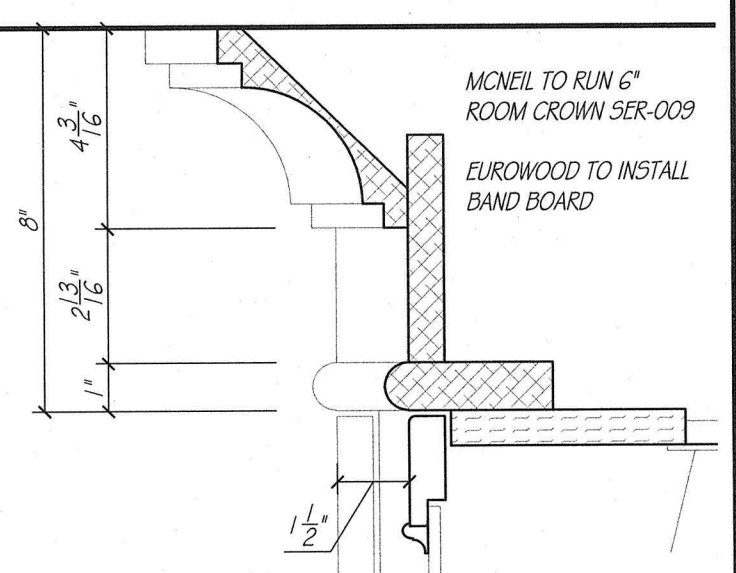



CROWN DETAIL
SCALE: 3\"/>

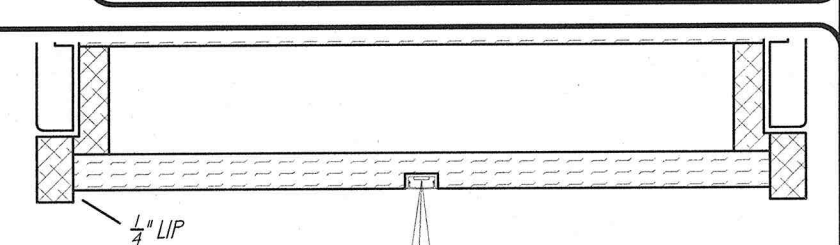

LC DETAIL
SCALE: 3\"/>

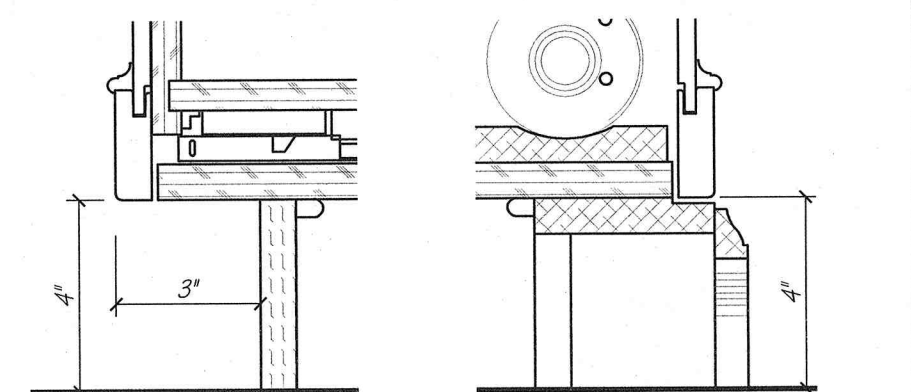


TOE DETAIL
SCALE: 3\"/>

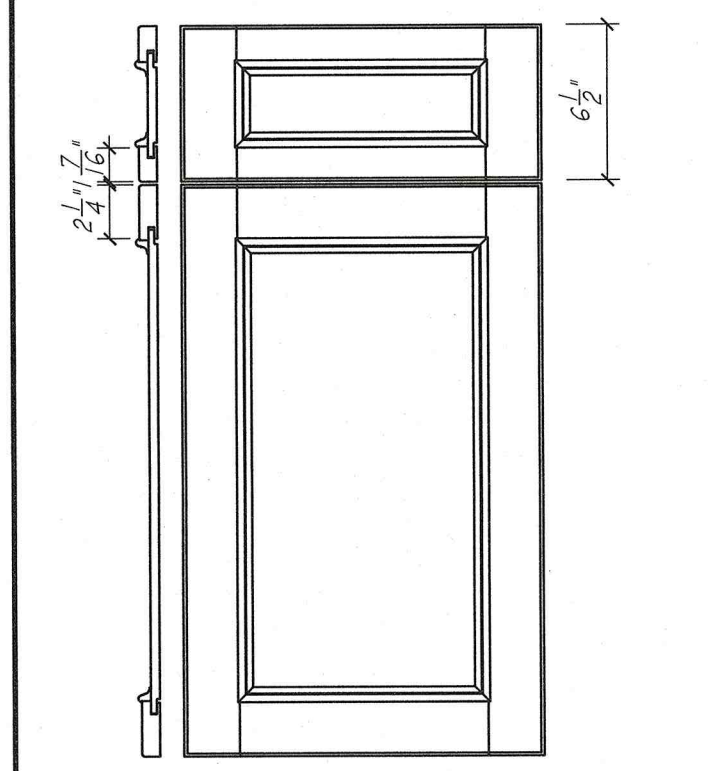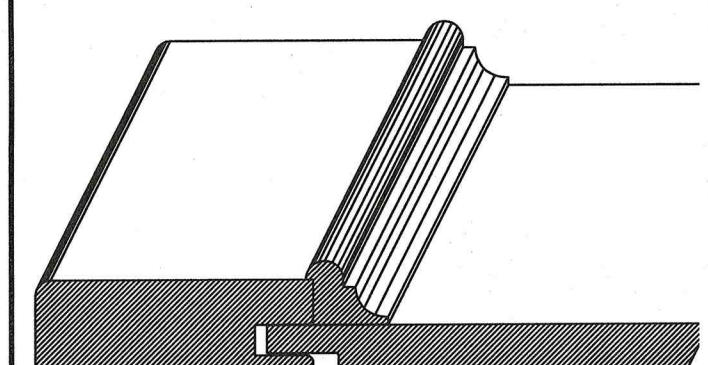

DOOR STYLE - 101728
MORTISE AND TENON CONSTRUCTION
OUTSIDE EDGE - L-149
INSIDE EDGE - APPLIED MOLDING
CENTER PANEL - P057

DOOR DETAIL EW-CWS
SCALE: 1 1/2\"/>

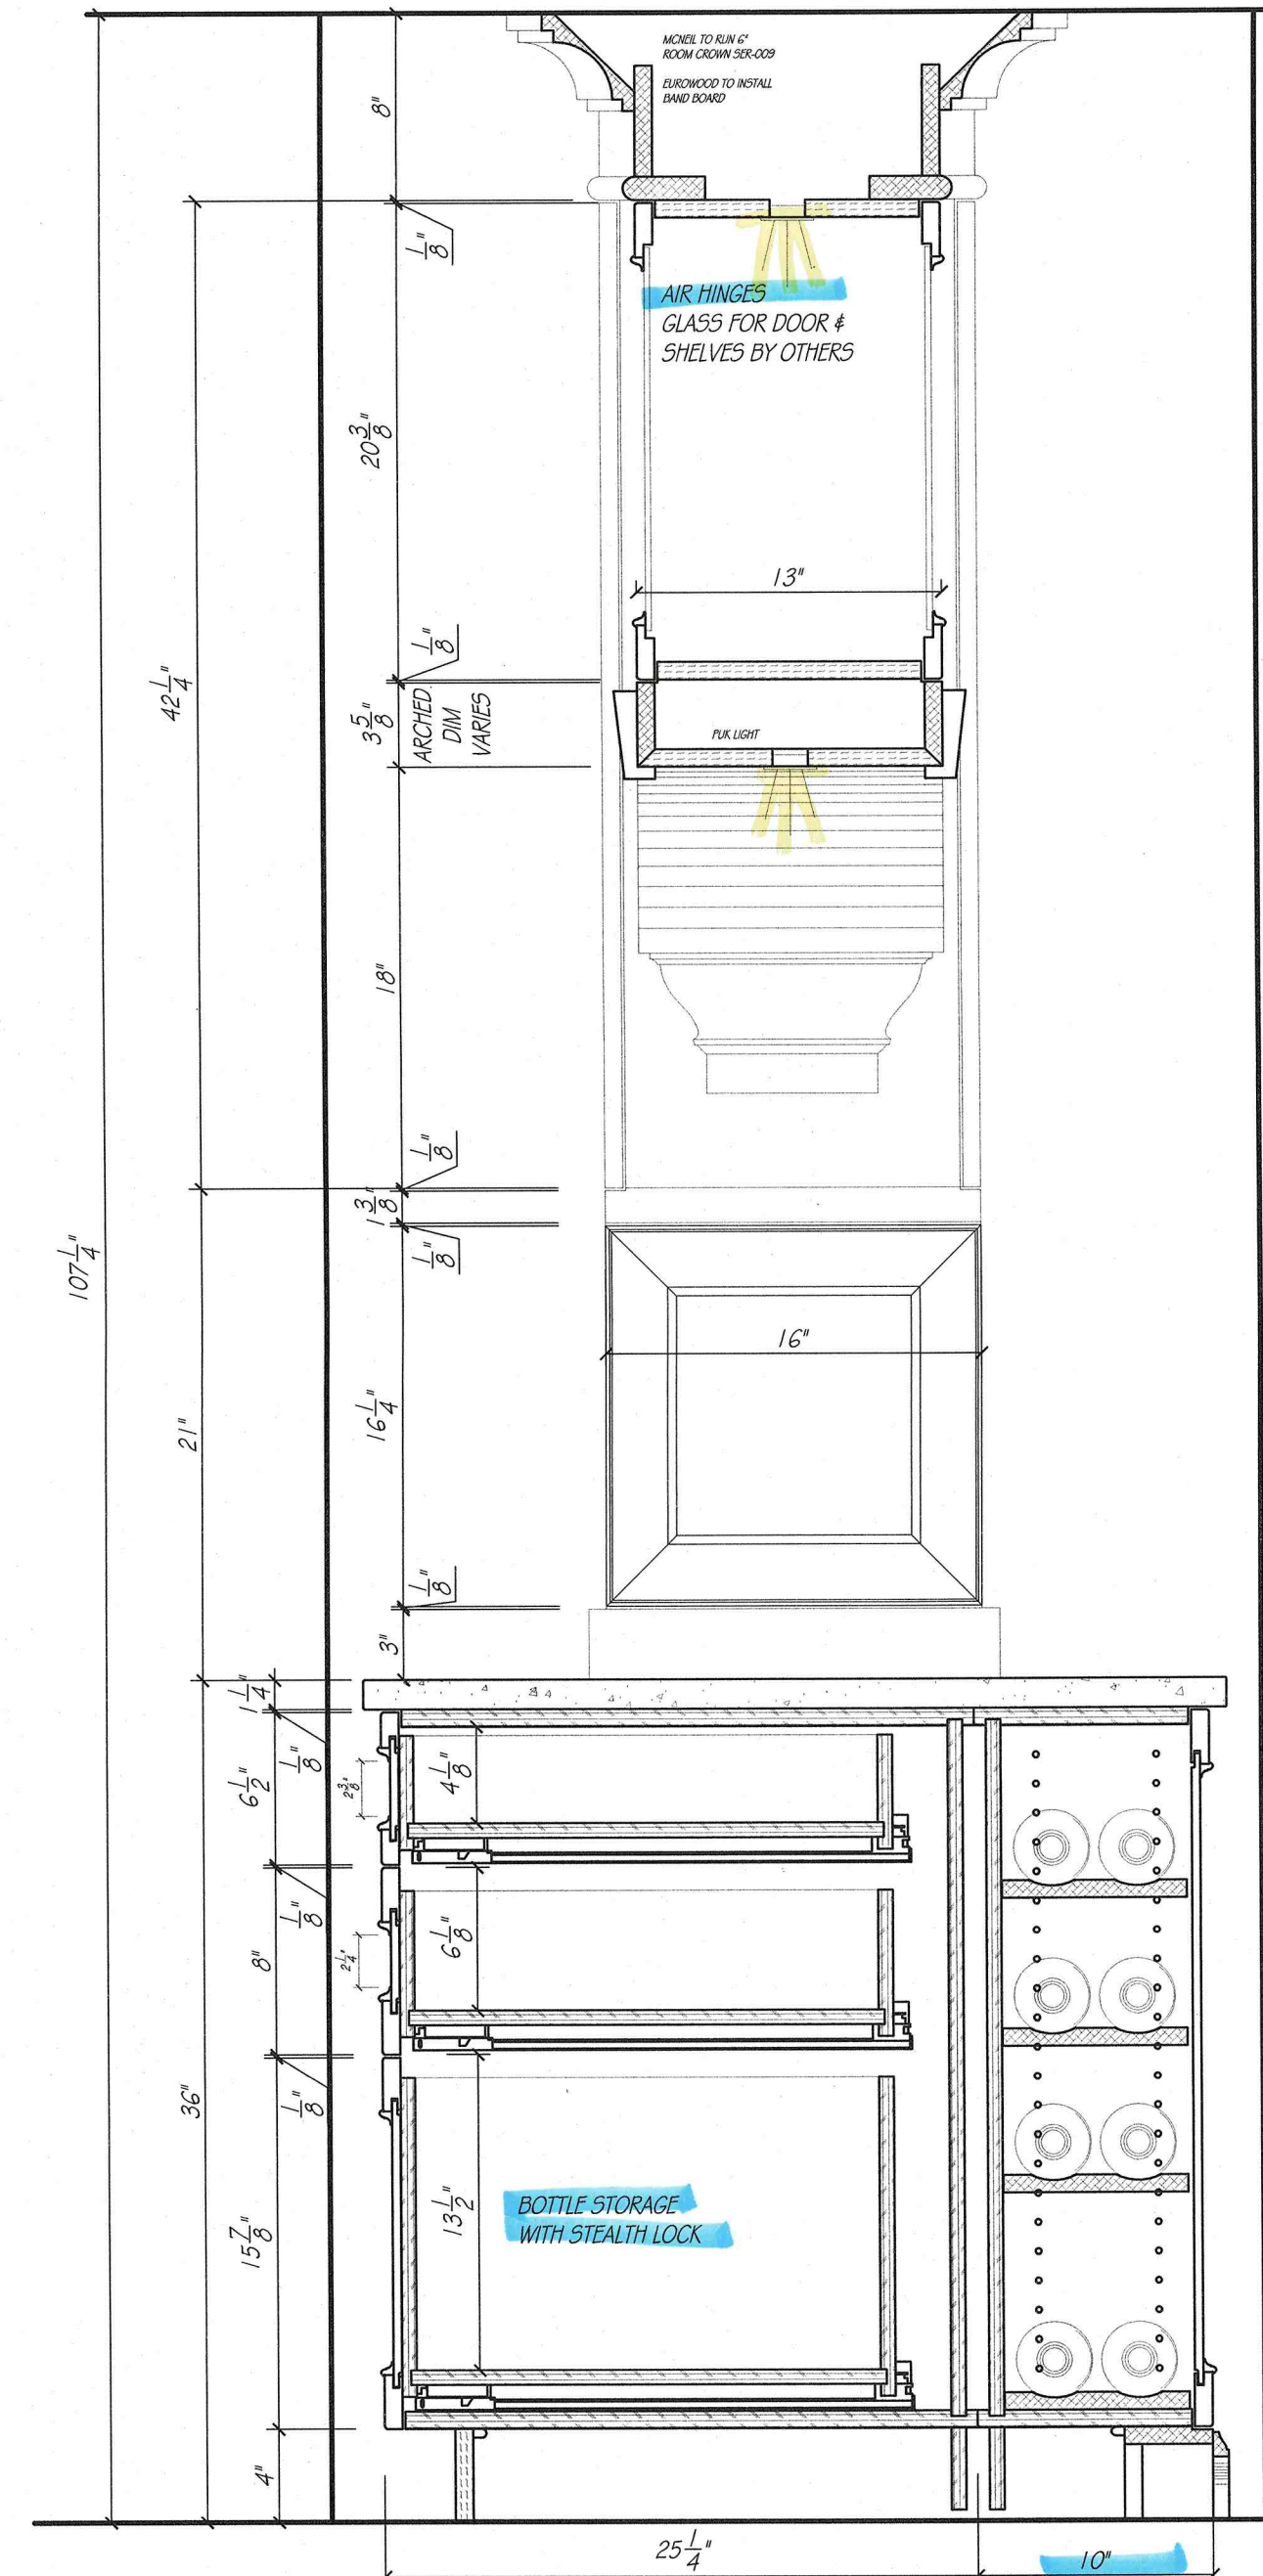

CABINET DETAIL
SCALE: 1 1/2\"/>



EUROWOOD

Cabinets inc.

3415 SO. 67TH ST.
OMAHA, NE 68106

TEL (402-393-4110)

FAX (402-393-8361)

(WWW.EUROWOOD.NET)

SHEET: A6


DRAWN BY: SUB

PLAN:
MAIN LEVEL
HEARTH ROOM / DINING

REVISIONS:

1 JUNE 26
2 JULY 26
8 JULY 26
24 JULY 26
27 AUGUST 26

PHIL & MICHELLE WOOD
3435 N. 140TH. CIRCLE
OMAHA, NE 68164

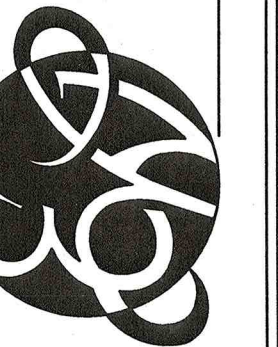

APPROVED BY:

SIGNATURE



DATE

DUPLICATION OF THESE DRAWINGS IS PROHIBITED WITHOUT WRITTEN CONSENT BY EUROWOOD CABINETS
© 2000, EUROWOOD CABINETS INC.

MEASUREMENTS ARE SUBJECT TO CHANGE DUE TO FINAL FIELD MEASUREMENTS.

WOOD


5588

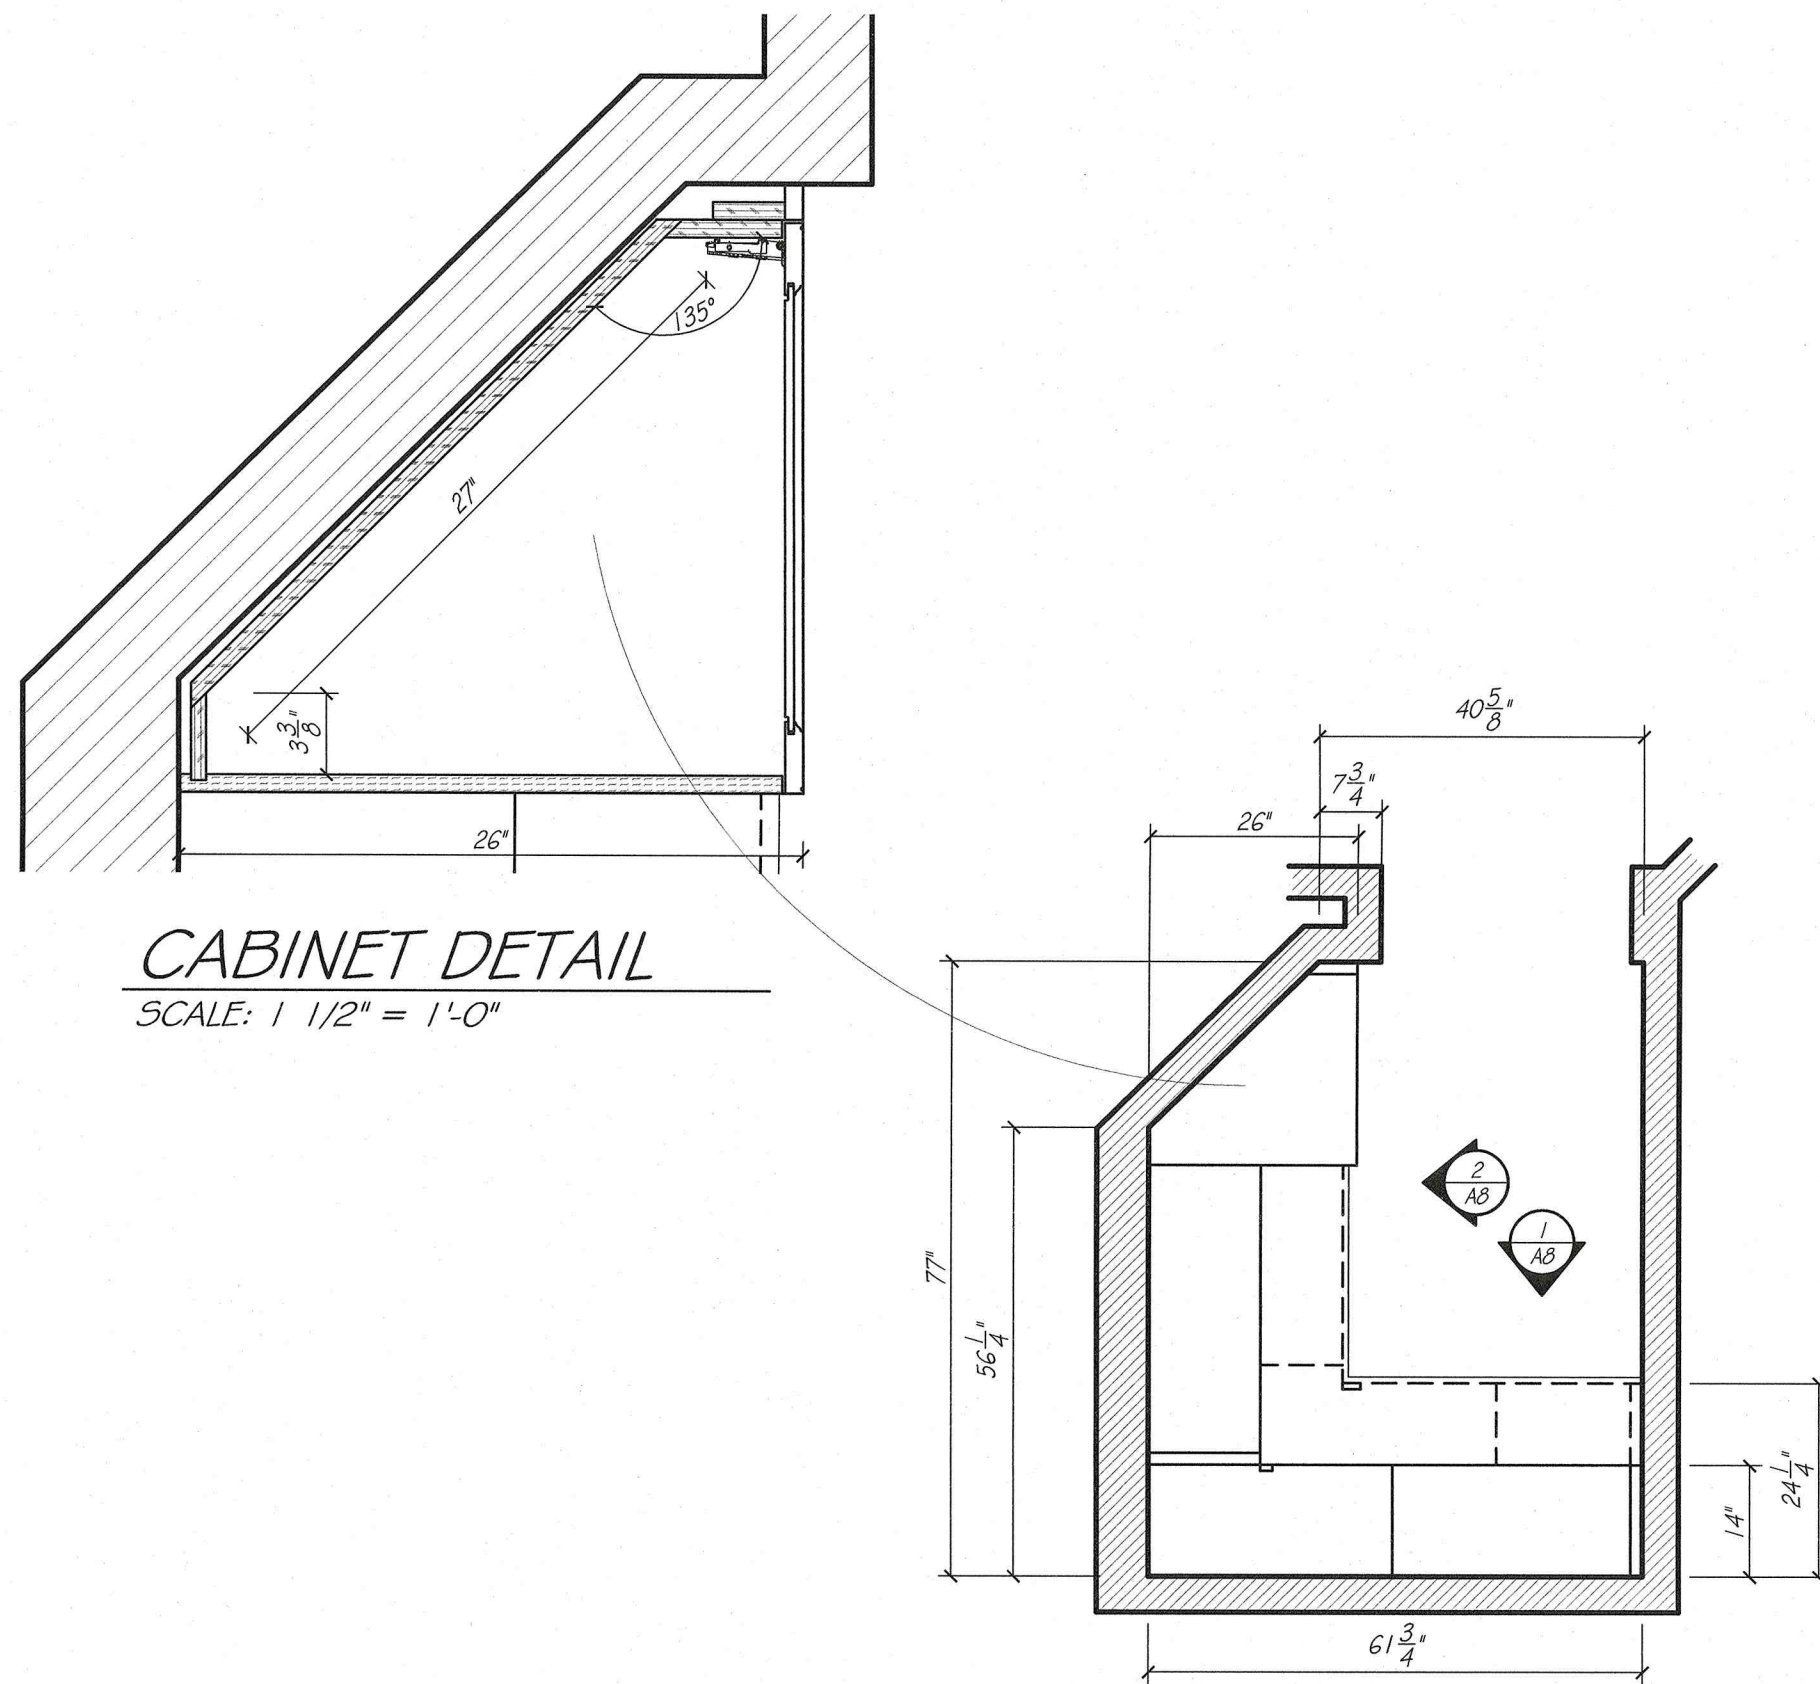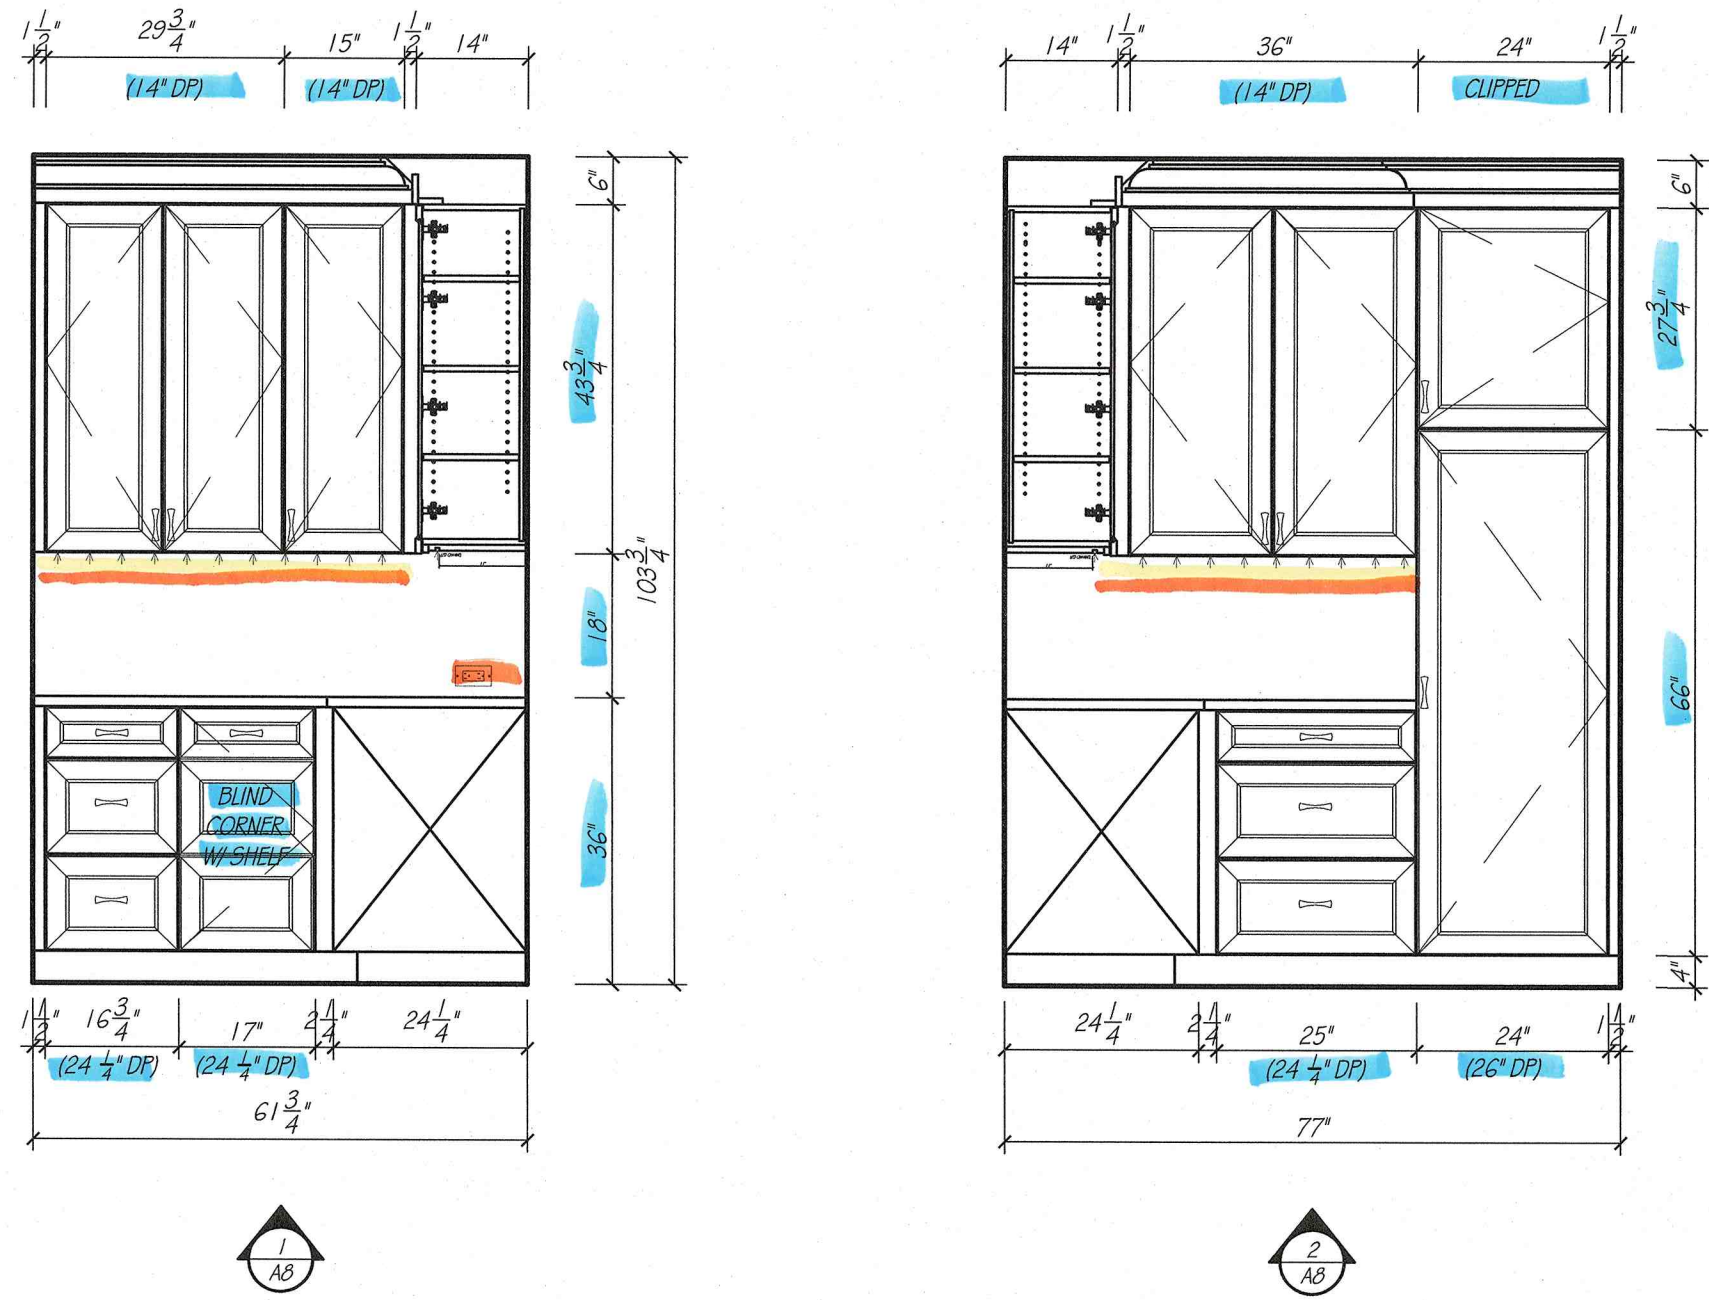


CABINET DETAIL
SCALE: 1 1/2" = 1'-0"

PANTRY
SCALE: 1/2" = 1'-0"


PANTRY	
CABINET CONSTRUCTION:	
EXTERIORS	PAINTABLE
INTERIORS	HARD ROCK MAPLE MELAMINE
DRAWER BOXES	HARD ROCK MAPLE MELAMINE
FACE BANDING	MATCHING WOOD EDGE BANDING
CABINET HARDWARE & DRILLING	BY OTHERS
DRAWER SLIDE	FULL EXT. SOFT CLOSE CONCEALED SLIDES
COUNTERTOP SPECIFICATIONS:	
COUNTERTOP MATERIAL	QUARTZ
COUNTERTOP THICKNESS	1 1/4" ALLOWANCE
SUBTOP REQUIREMENTS	NONE
ROOM SPECIFICATIONS	
FLOORING - TYPE / ALLOWANCE	VERIFY 3/4" ALLOWANCE
CASING - W/ 1/4" REVEAL	3 3/4"

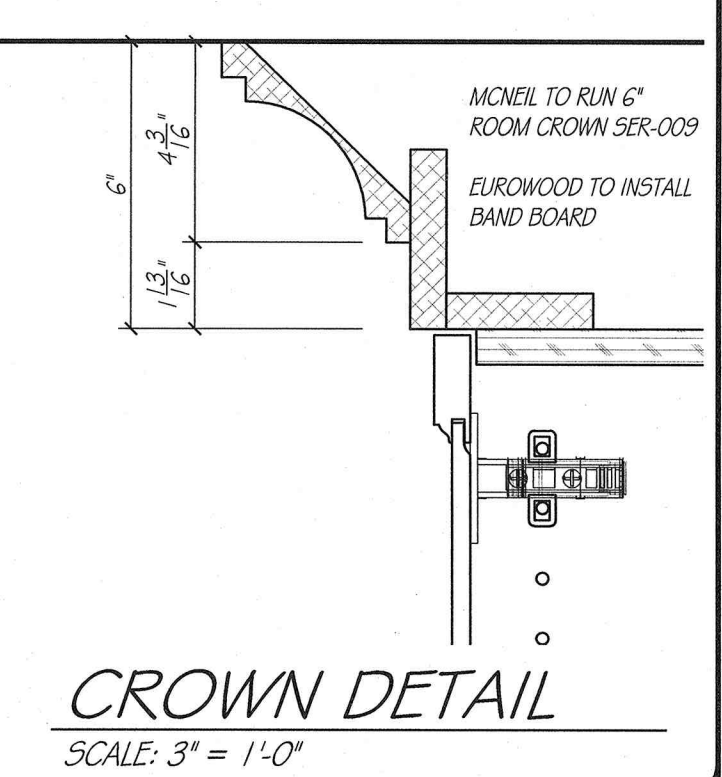


CROWN DETAIL
SCALE: 3" = 1'-0"

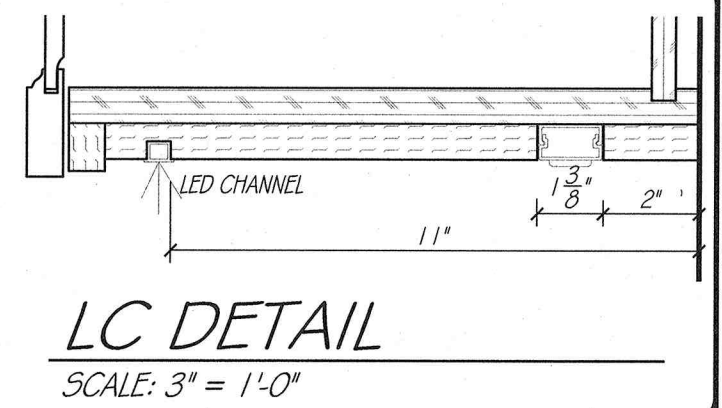

LC DETAIL
SCALE: 3" = 1'-0"

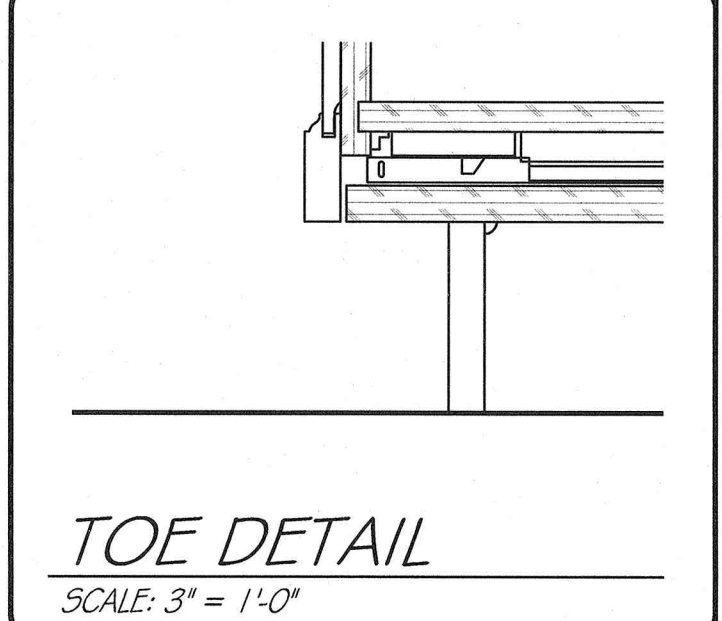

TOE DETAIL
SCALE: 3" = 1'-0"

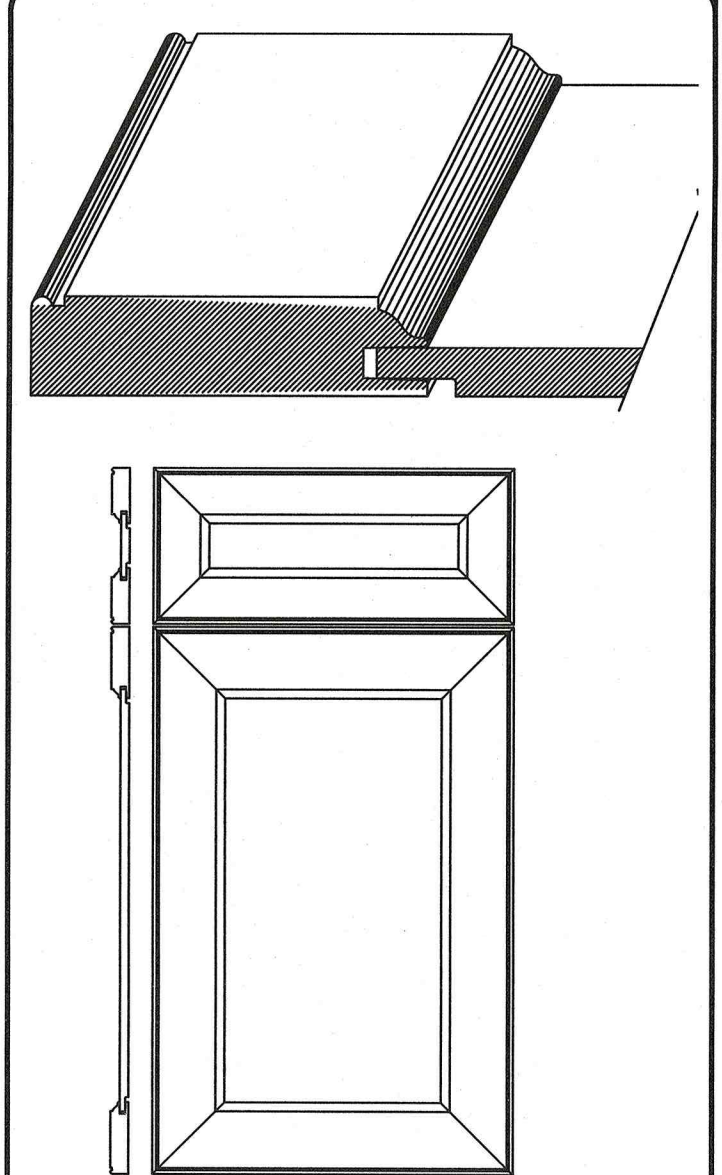


DOOR DETAIL
SCALE: 1 1/2" = 1'-0"
EW-CW5

EUROWOOD
Cabinets INC.
3415 SO. 87TH ST.
OMAHA, NE 68106
TEL (402-393-4110)
FAX (402-393-8361)
(WWW.EUROWOOD.NET)

SHEET:	A8
DRAWN BY:	SJB
PLAN:	MAIN LEVEL PANTRY
REVISIONS:	2 MAY 26 11 JUNE 26 23 JUNE 26 2 JULY 26 8 JULY 26 24 JULY 26 27 AUGUST 26

PHIL & MICHELLE WOOD
3435 N. 140TH. CIRCLE
OMAHA, NE 68164

APPROVED BY:	
SIGNATURE	
DATE	
DUPLICATION OF THESE DRAWINGS IS PROHIBITED WITHOUT WRITTEN CONSENT BY EUROWOOD CABINETS ©2000, EUROWOOD CABINETS INC. MEASUREMENTS ARE SUBJECT TO CHANGE DUE TO FINAL FIELD MEASUREMENTS.	
WOOD	
5588	




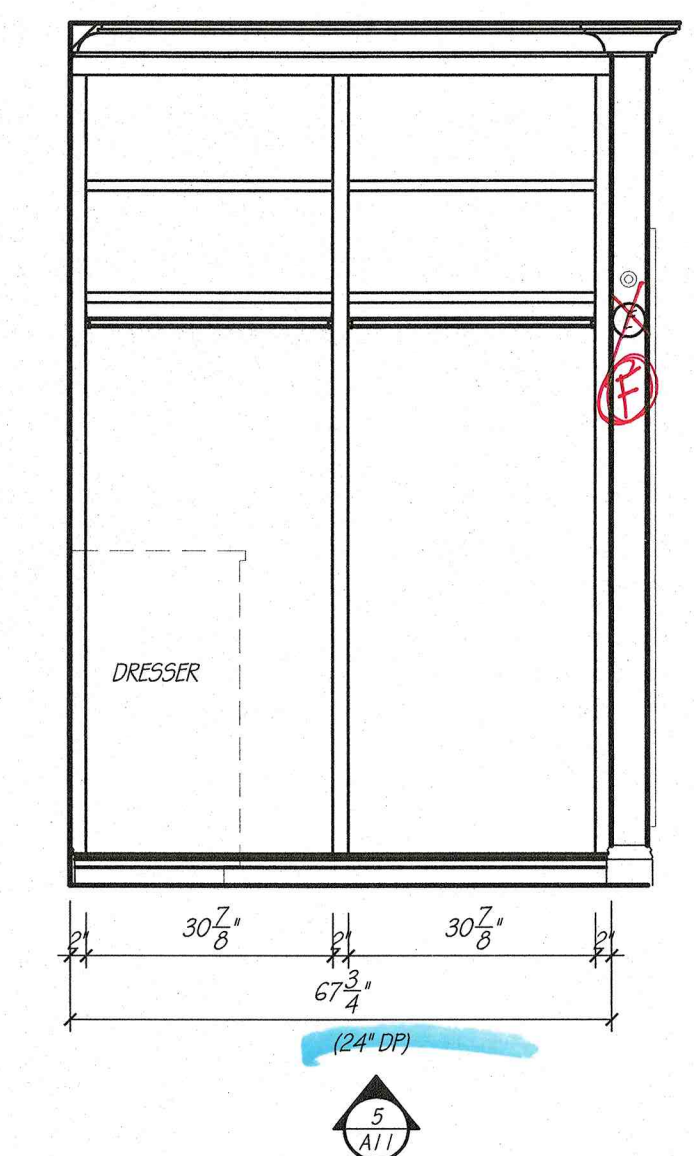


PRIMARY WARDROBE	
CABINET CONSTRUCTION:	
EXTERIORS	PAINTABLE + EGGER SOFT BEECH MELAMINE U220 513
INTERIORS	HARD ROOCE MARLE MELAMINE
DRAWER BOXES	MARLE DOVETAIL
FACE BANDING	MATCHING WOOD EDGE BANDING
CABINET HARDWARE + DRILLING	BY OTHERS
DRAWER SLIDE	FULL EXT. SOT CLOSE CONCEALED SLIDES
COUNTERTOP SPECIFICATIONS:	
COUNTERTOP MATERIAL	QUARTZ
COUNTERTOP THICKNESS	1 1/4" ALLOWANCE
SUBTOP REQUIREMENTS	NONE
ROOM SPECIFICATIONS	
FLOORING - TYPE / ALLOWANCE	CARPET 3/4"
CASING W/ 1/4" REVEAL	3/4"



REVISIONS:


1 JUNE 26
11 JUNE 26
23 JUNE 26
3 JULY 26
10 JULY 26
24 JULY 26
20 AUGUST 26
27 AUGUST 26

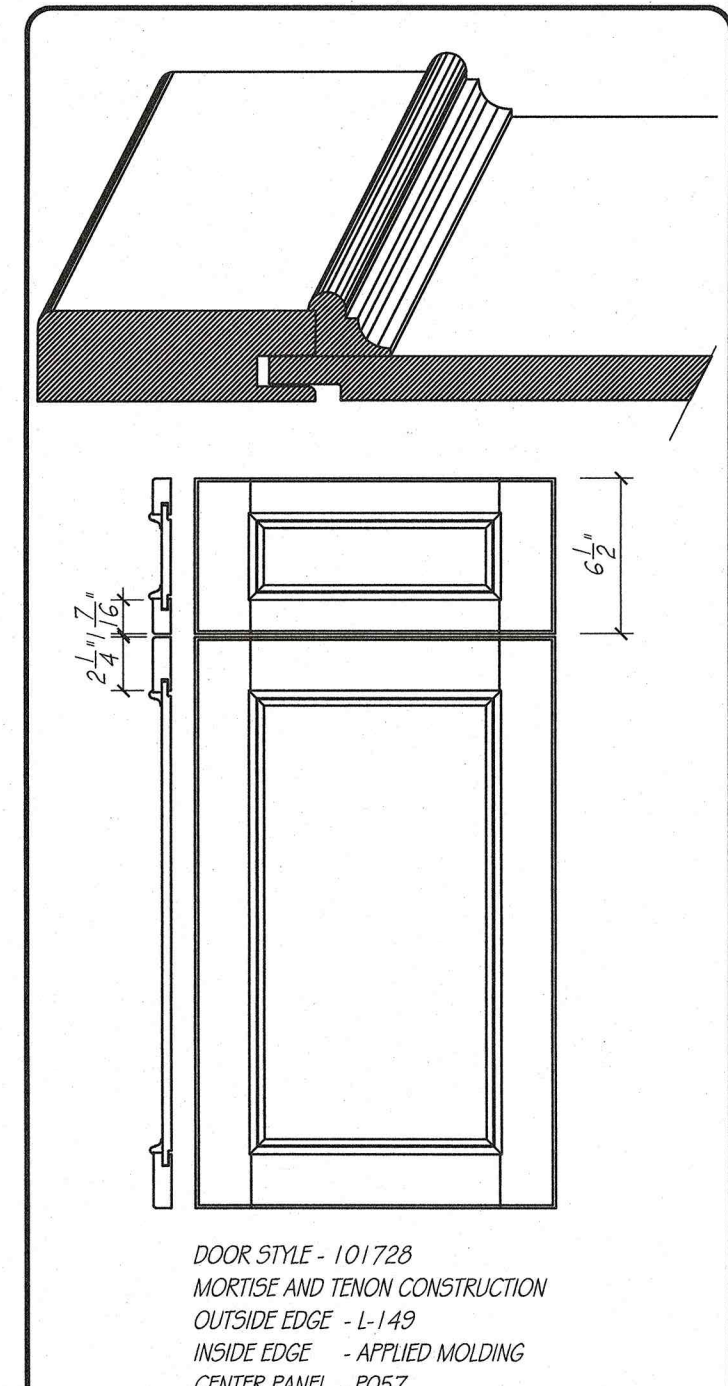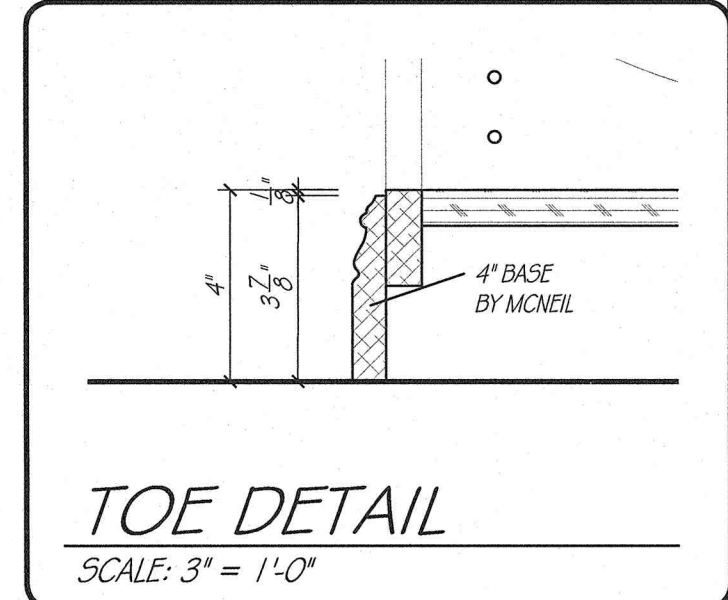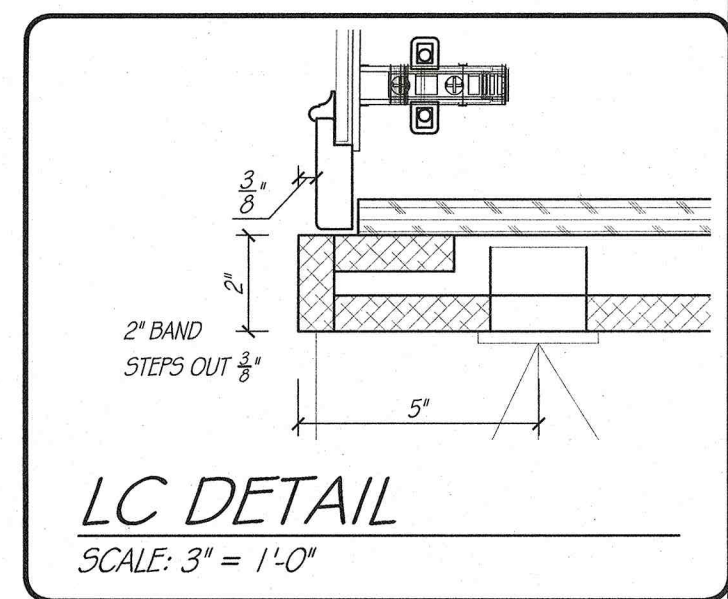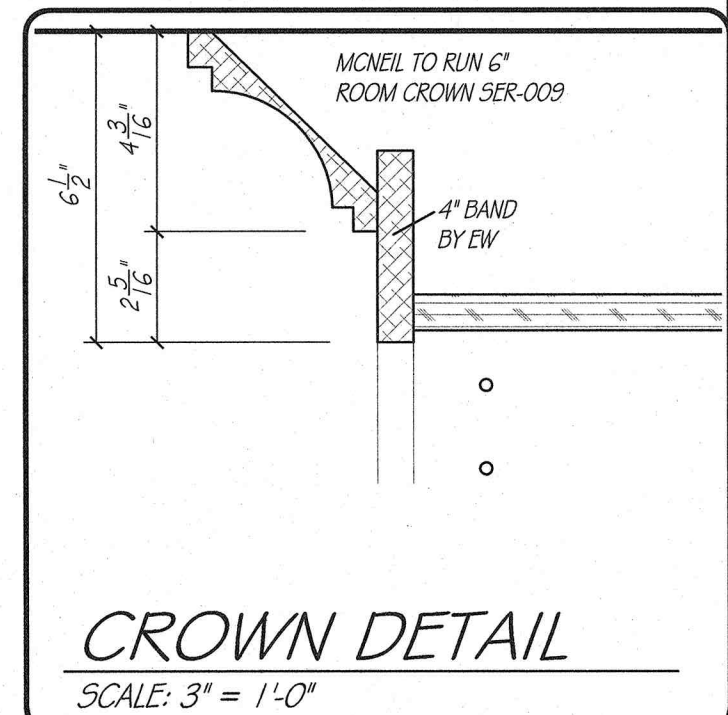

DUPLICATION OF THESE DRAWINGS IS
 PROHIBITED WITHOUT WRITTEN CONSENT
 BY EUROWOOD CABINETS
 ©2000, EUROWOOD CABINETS INC.

MEASUREMENTS ARE SUBJECT TO CHANGE
 DUE TO FINAL FIELD MEASUREMENTS.

WOOD
5588



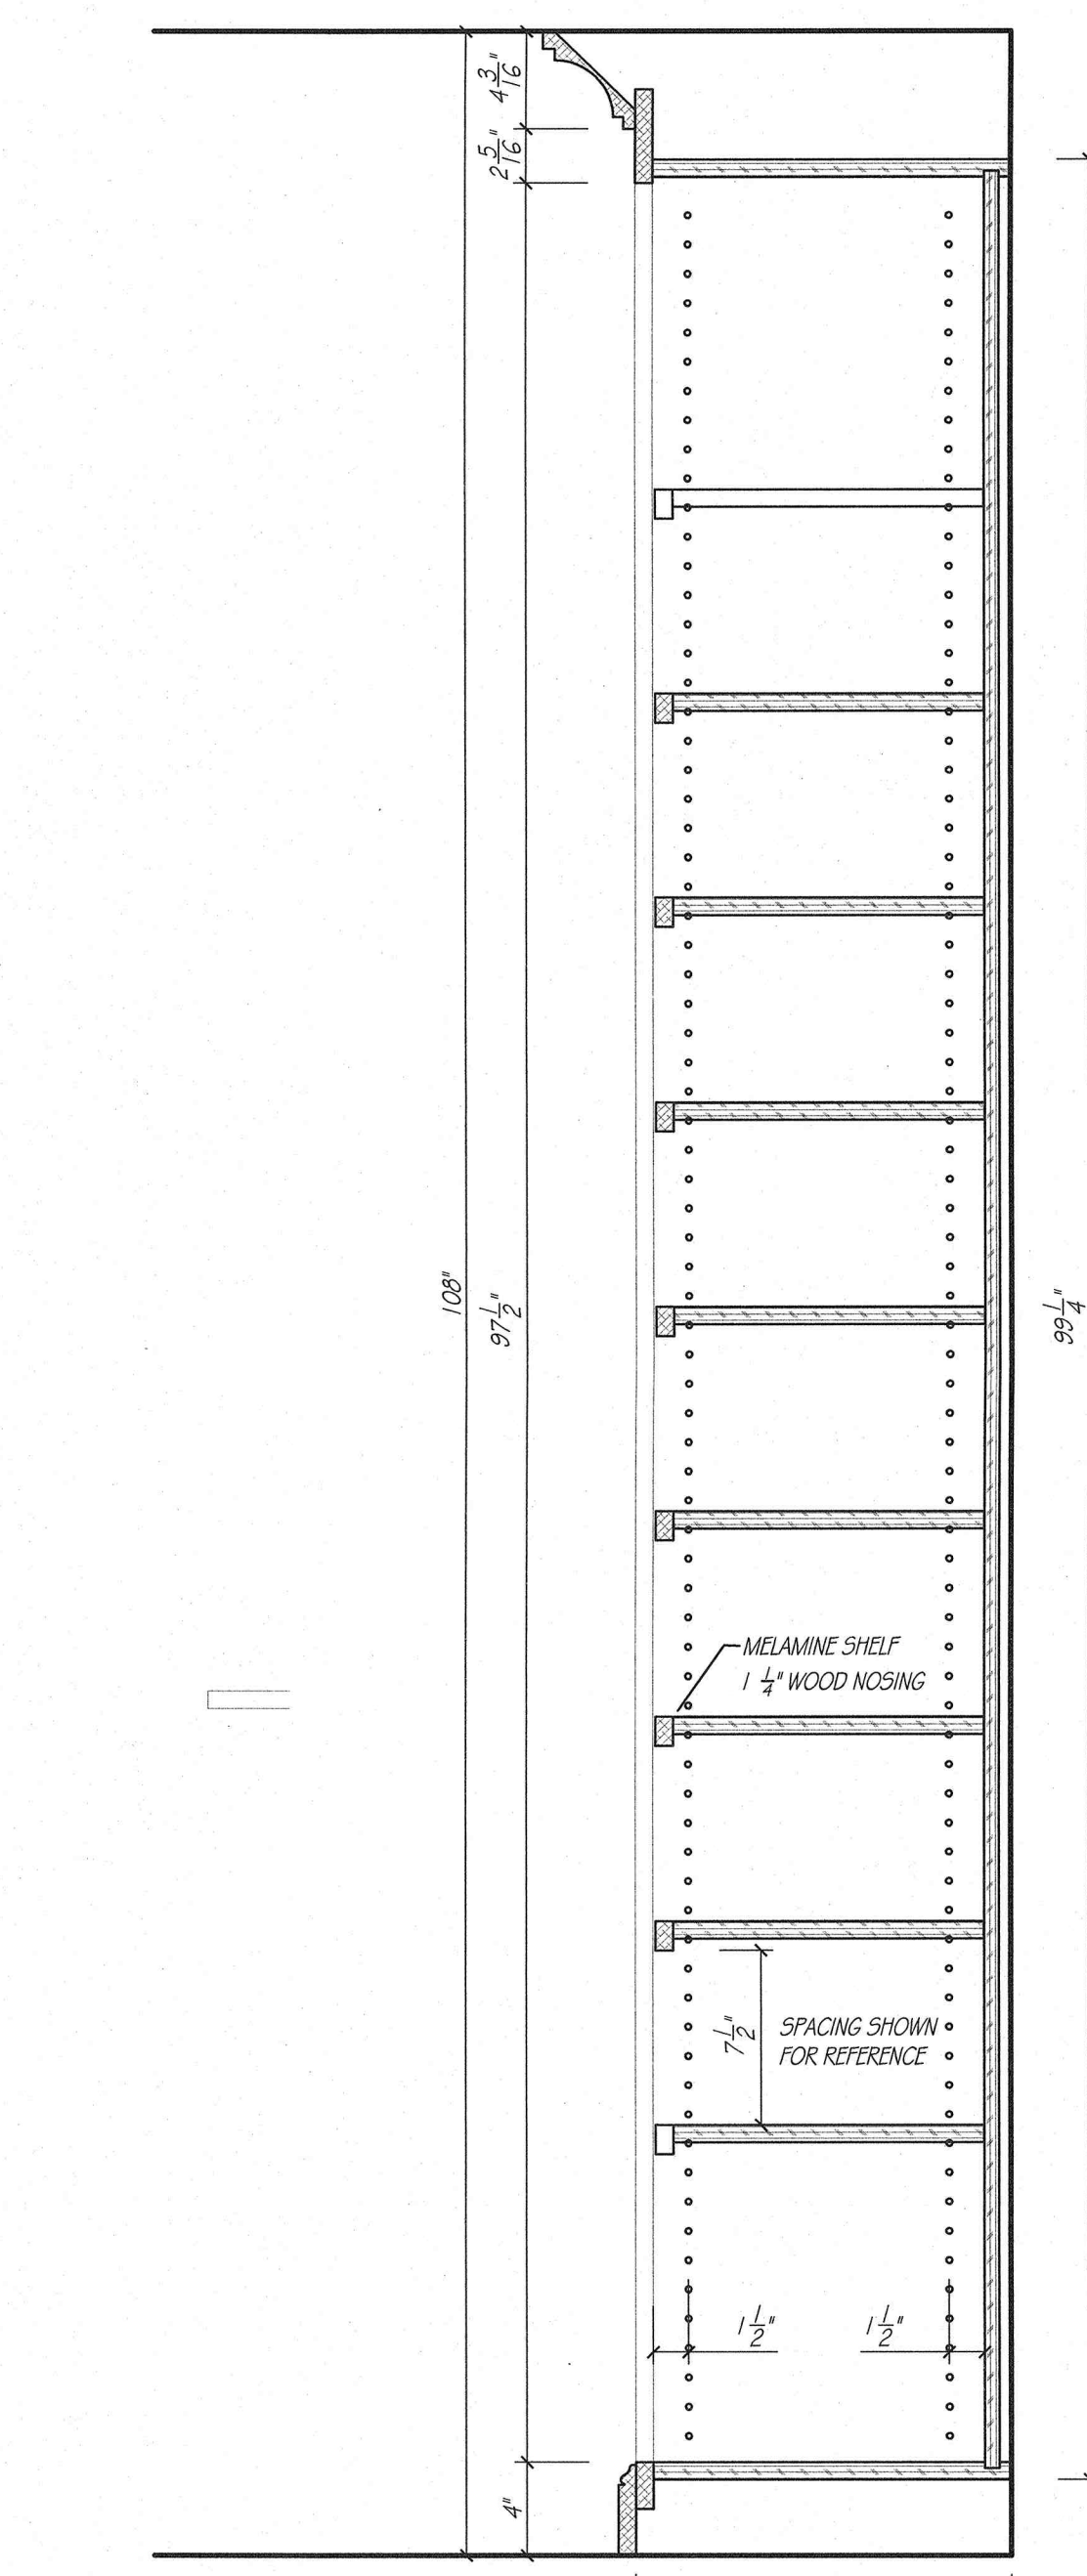


9
A/I

CABINET DETAIL

SCALE: $1 \frac{1}{2}'' = 1'-0''$

DOOR DETAIL *EW-CWS*
SCALE: 1 1/2" = 1'-0"

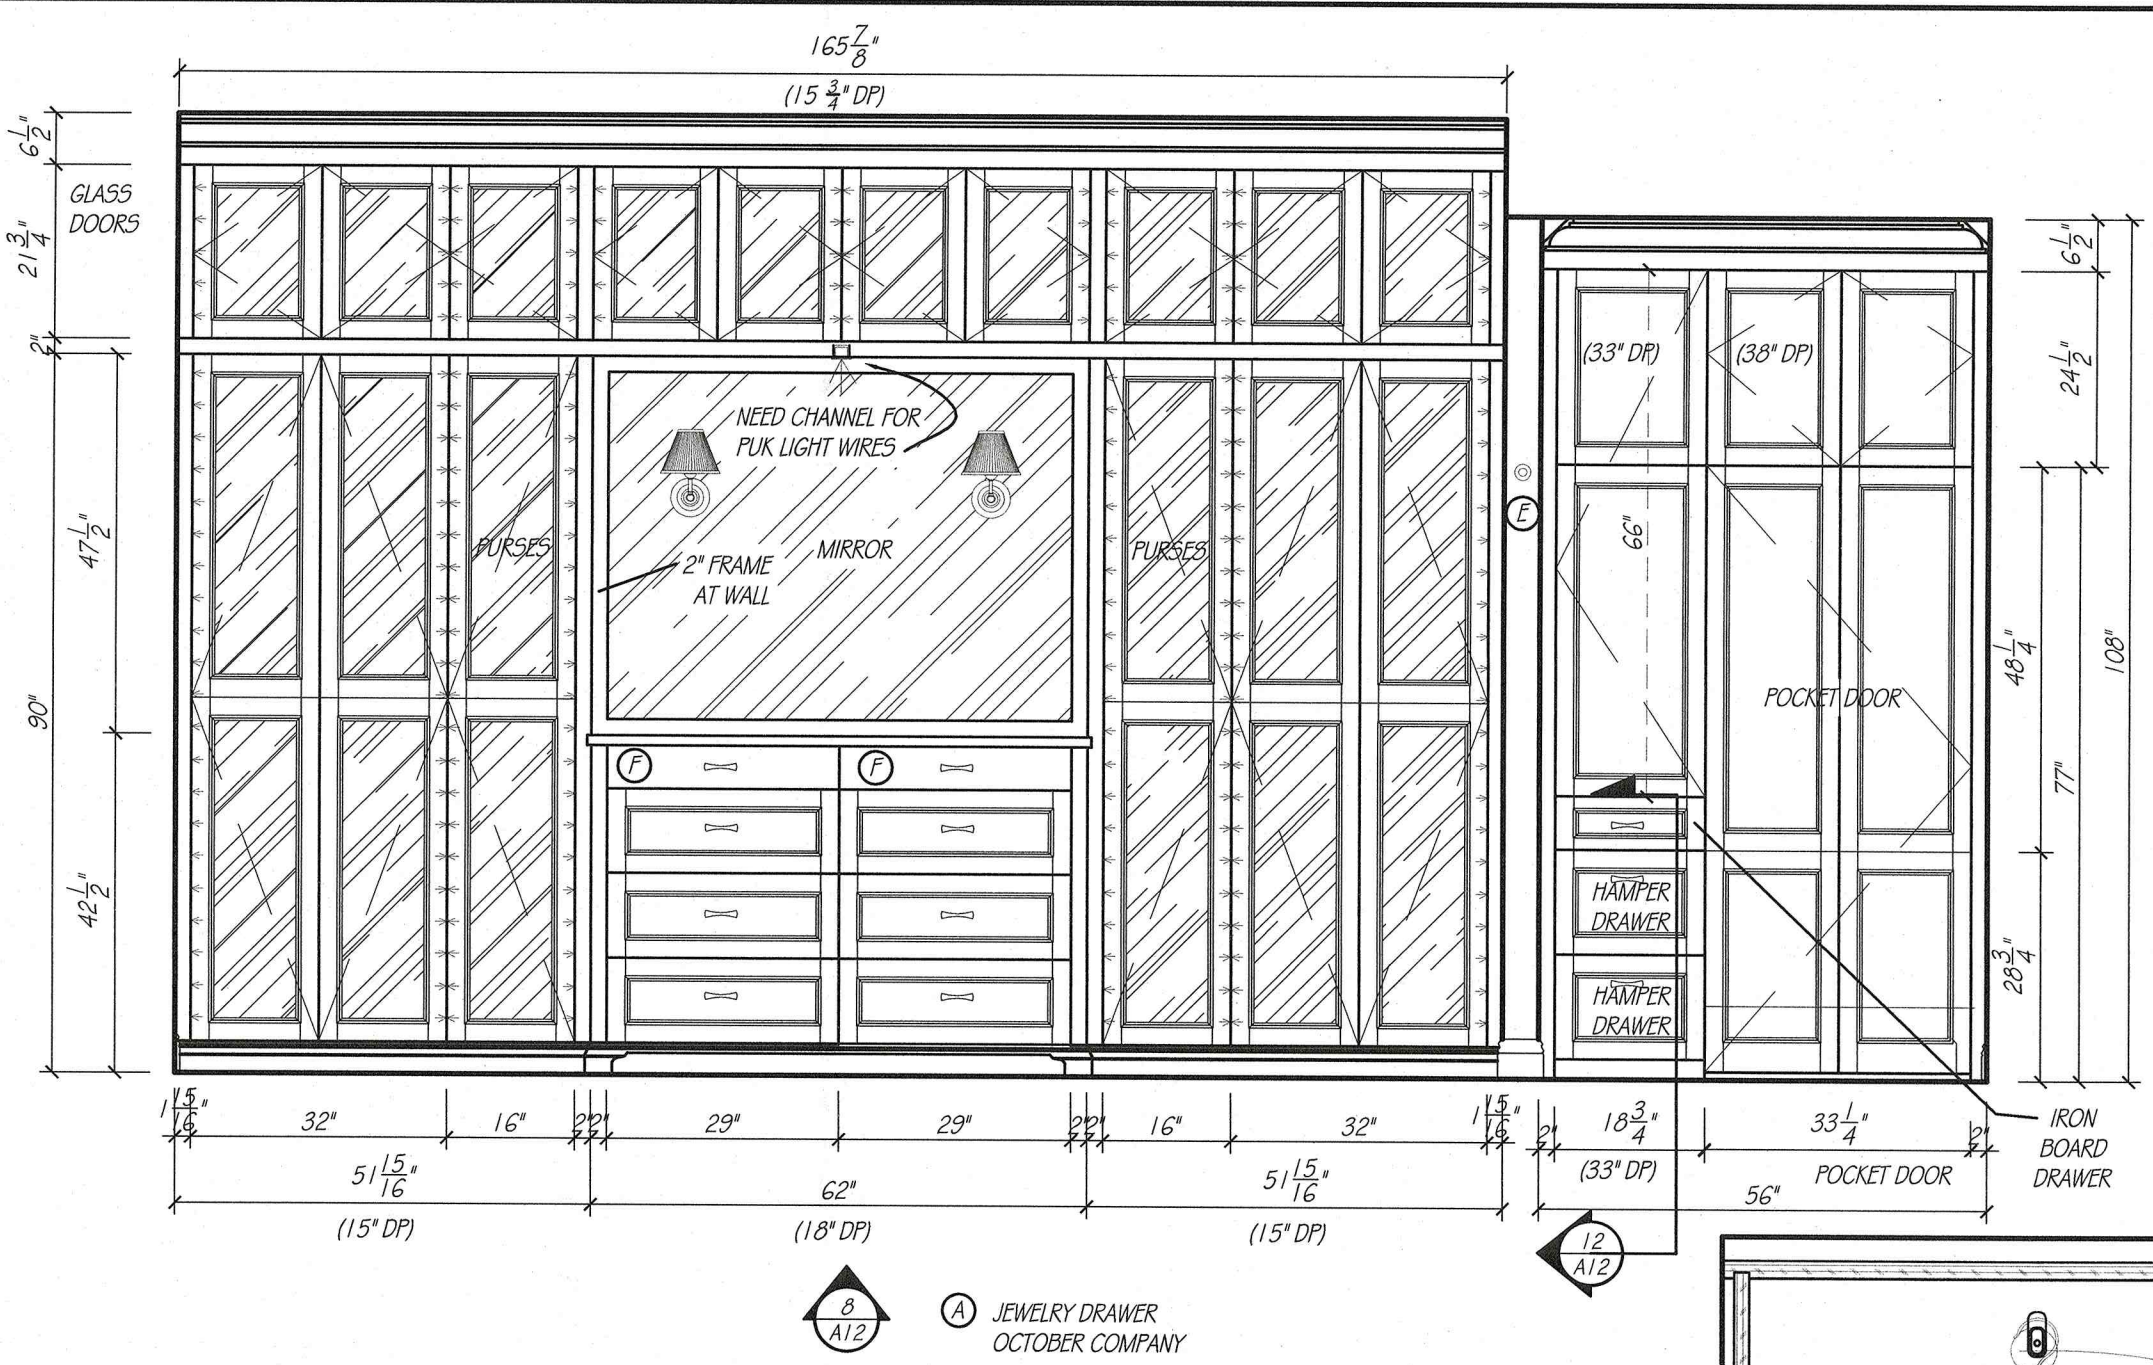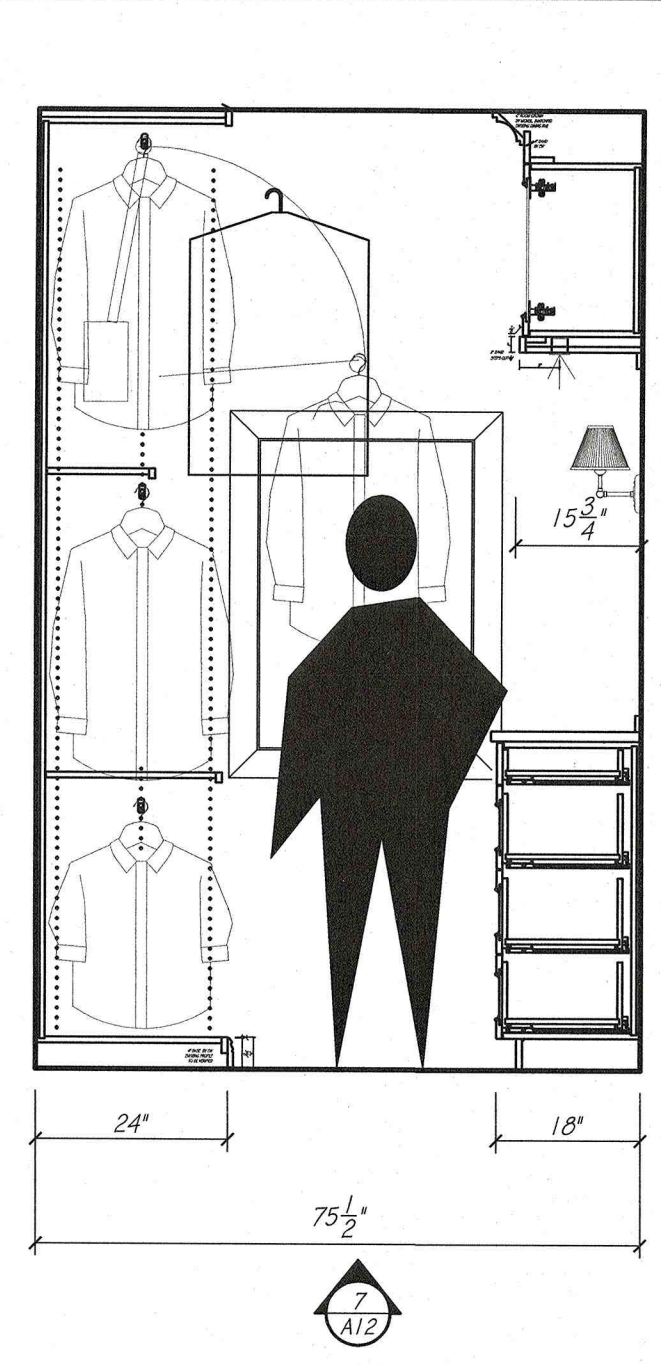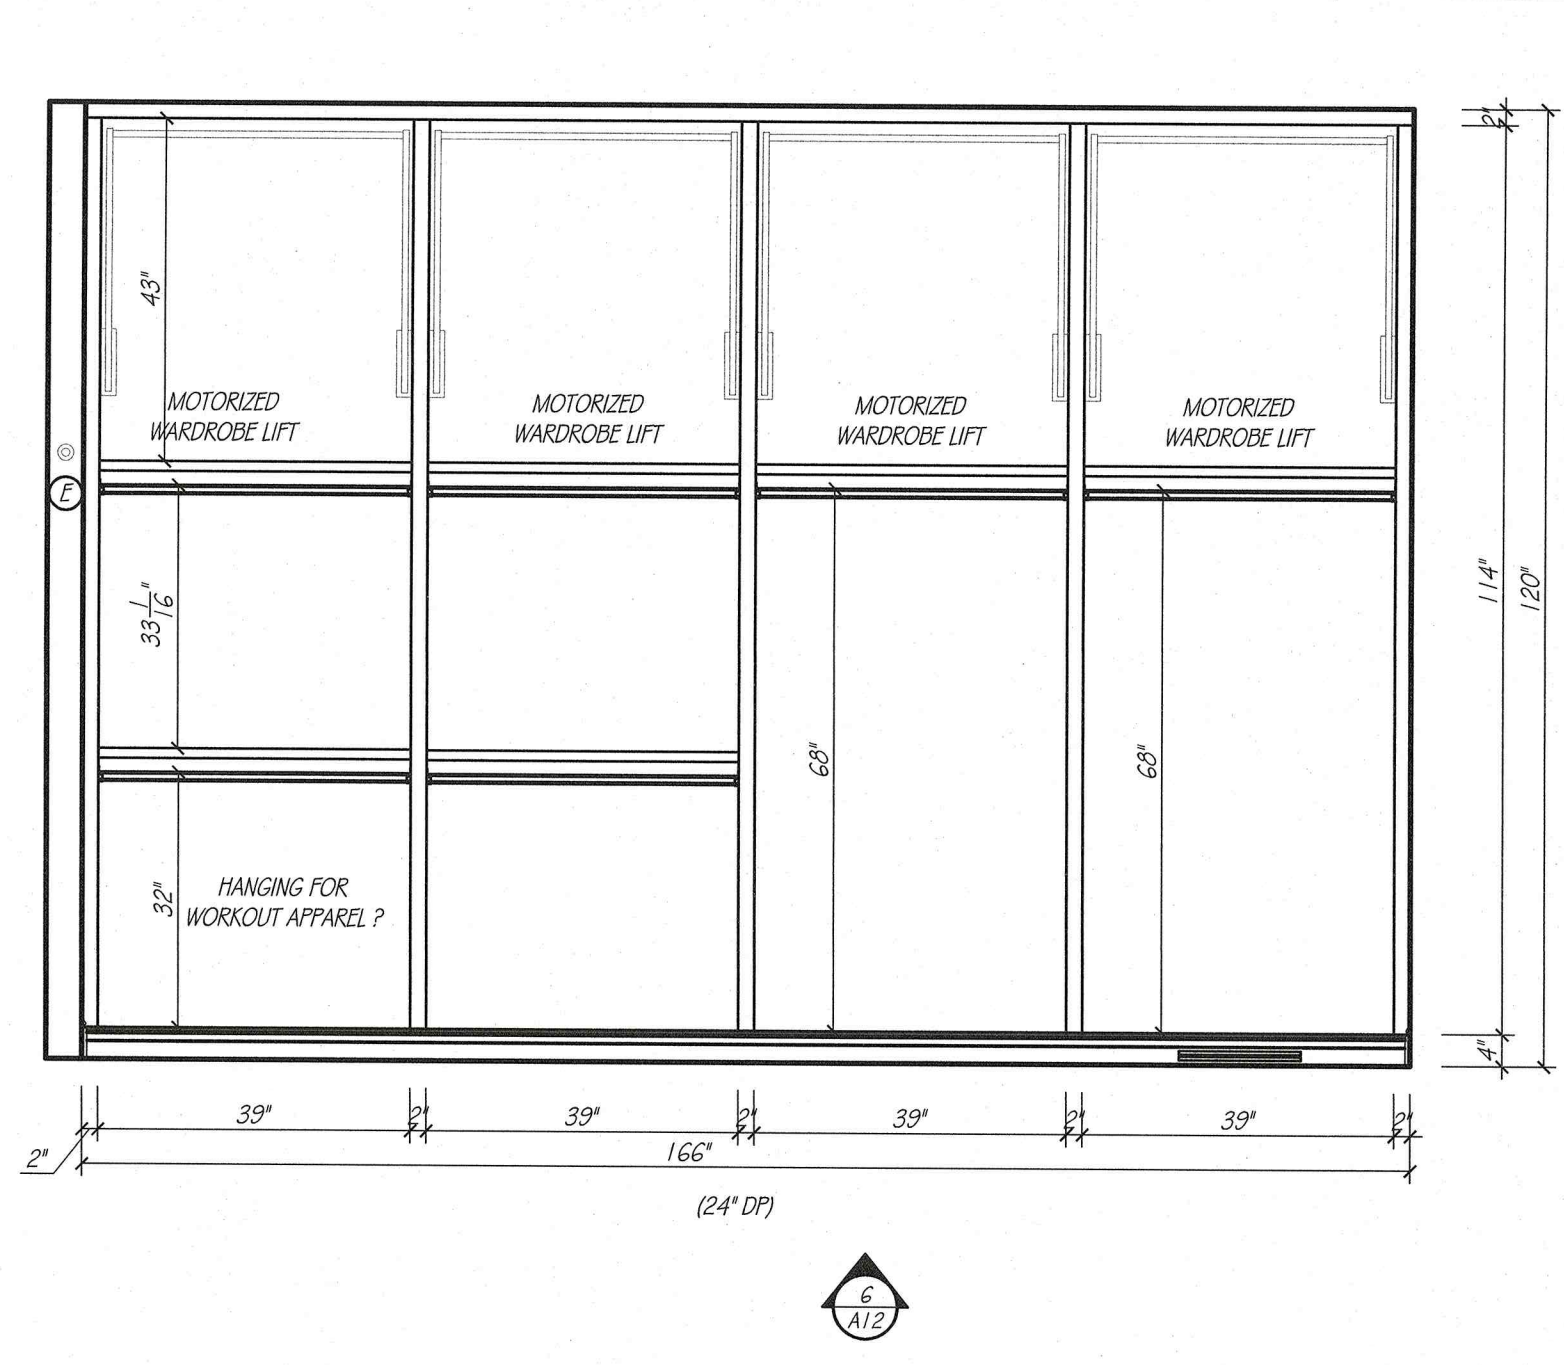

NOTES:

BOXES ARE EGGER SOFT BEIGE MELAMINE
ALL OUTSIDE MATERIAL PAINTABLE

4" BASE ON CABINETS
BY EUROWOOD
CONFIRM PROFILE

WARDROBE IS BOX CONSTRUCTION
(CABINET BACKS) WILL REQUIRE A SEAM

NEED SCARF ORGANIZERS

JEWELRY DRAWER
OCTOBER COMPANY


PRIMARY WARDROBE	
CABINET CONSTRUCTION:	
EXTERIORS	PAINABLE & OFF WHITE MELAMINE
INTERIORS	HARD ROCK MAPLE MELAMINE
DRAWER BOXES	MAPLE DOVETAIL
FACE BANDING	MATCHING WOOD EDGE BANDING
CABINET HARDWARE & DRILLING	BY OTHERS
DRAWER SLIDE	FULL EXT. SOFT CLOSE CONCEALED SLIDES
COUNTERTOP SPECIFICATIONS:	
COUNTERTOP MATERIAL	QUARTZ
COUNTERTOP THICKNESS	1 1/4" ALLOWANCE
SUBTOP REQUIREMENTS	NONE
ROOM SPECIFICATIONS	
FLOORING - TYPE / ALLOWANCE	CARPET 3/4"
CASING - W / 1/4" REVEAL	3 3/4"

EUROWOOD
Cabinets Inc.


3415 SO. 67TH ST.
OMAHA, NE 68106

TEL (402-393-4110)
FAX (402-393-8361)
(WWW.EUROWOOD.NET)


SHEET:	A12
DRAWN BY:	SJB
PLAN:	MAIN LEVEL
	PRIMARY WARDROBE
REVISIONS:	
	1 JUNE 26
	11 JUNE 26
	23 JUNE 26
	3 JULY 26
	10 JULY 26
	24 JULY 26
	20 AUGUST 26
	27 AUGUST 26

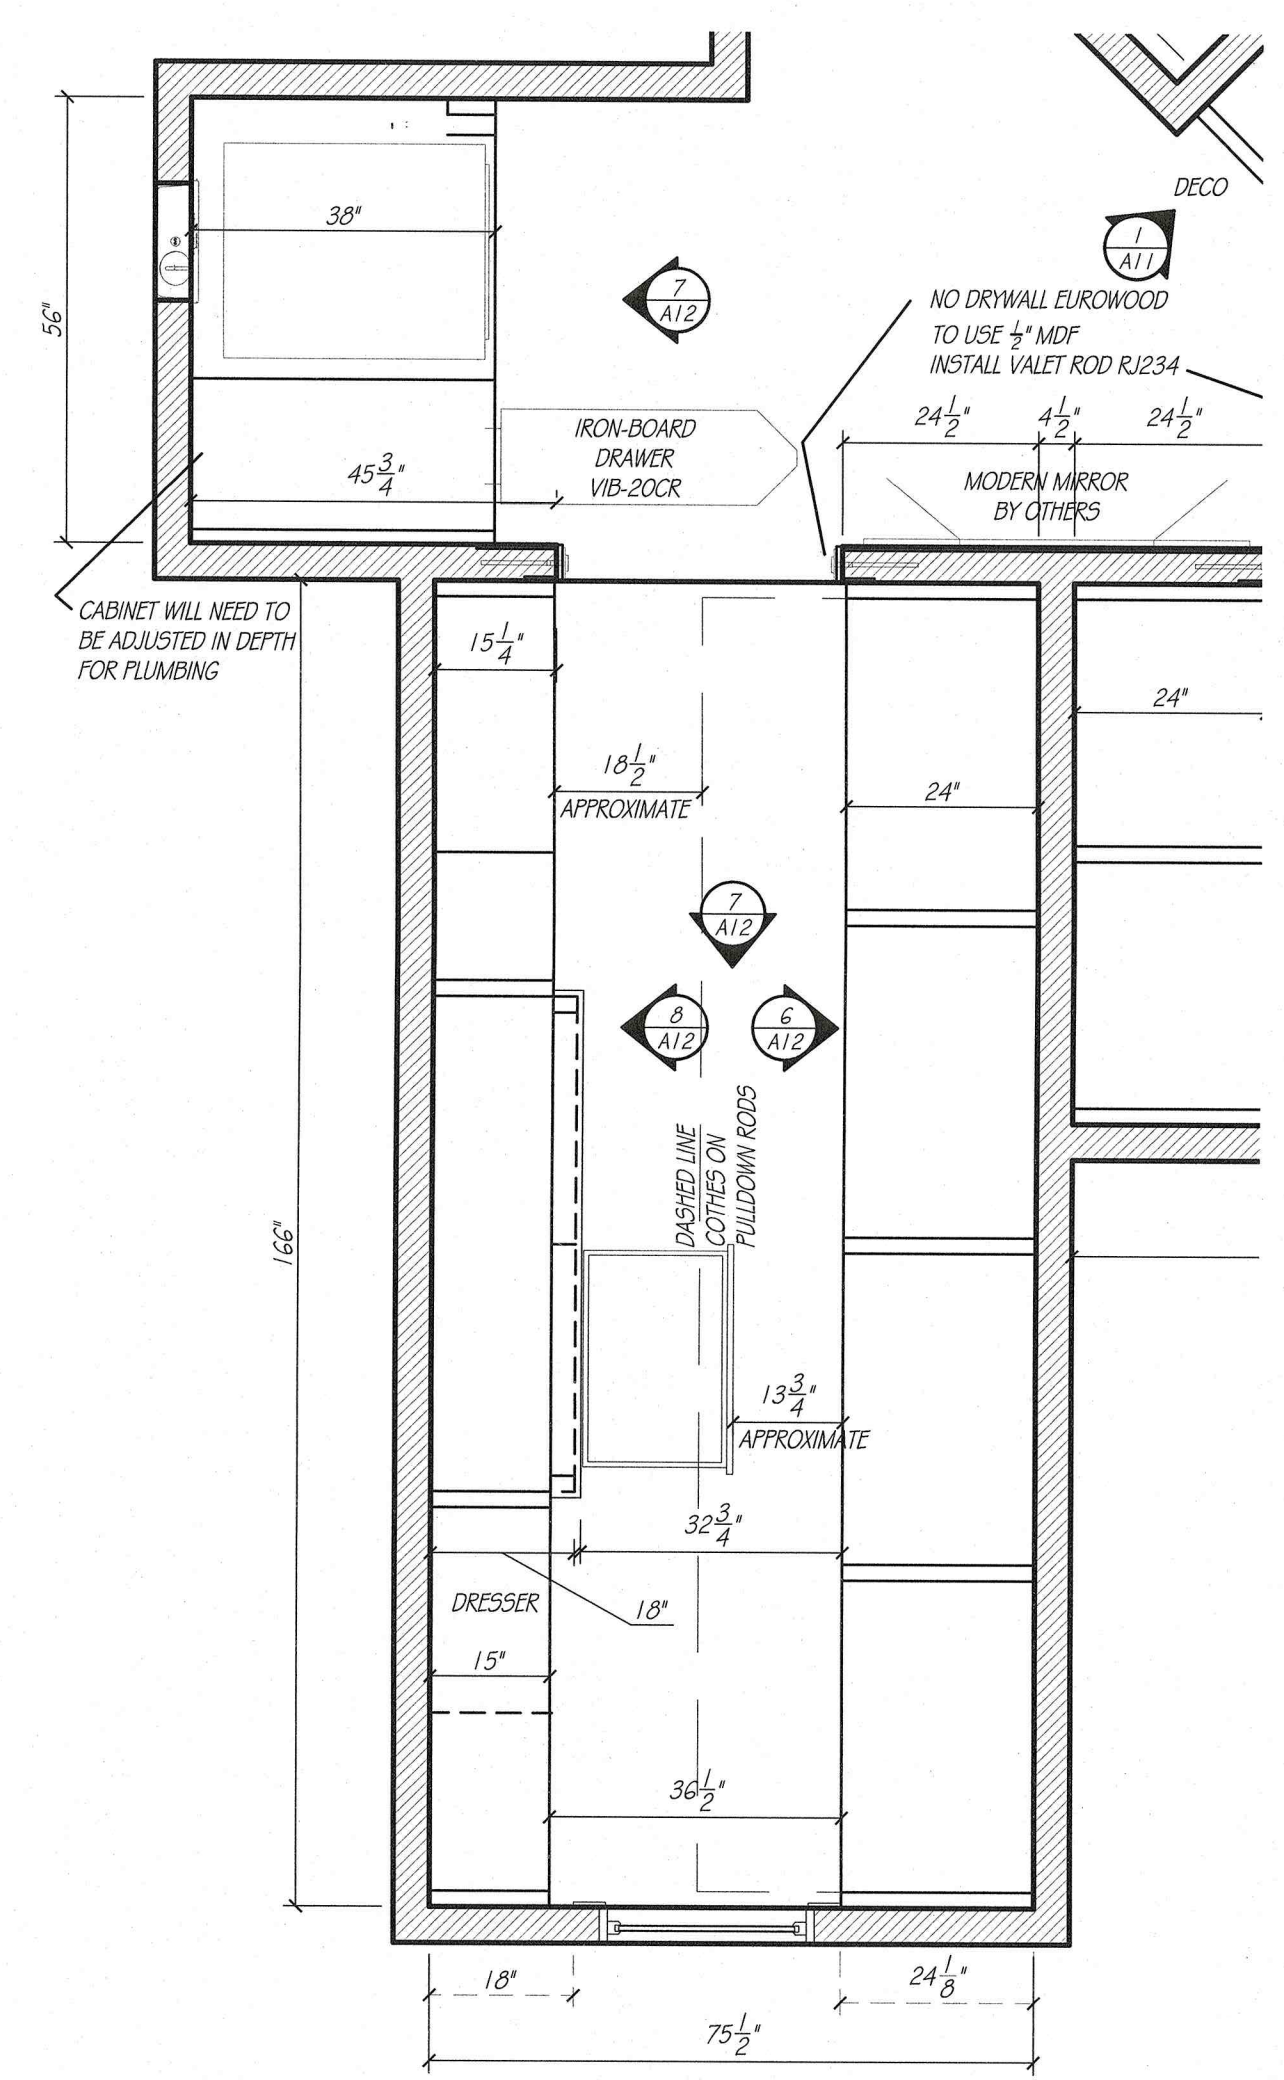


PRIMARY WARDROBE
SCALE: 1/2" = 1'-0"

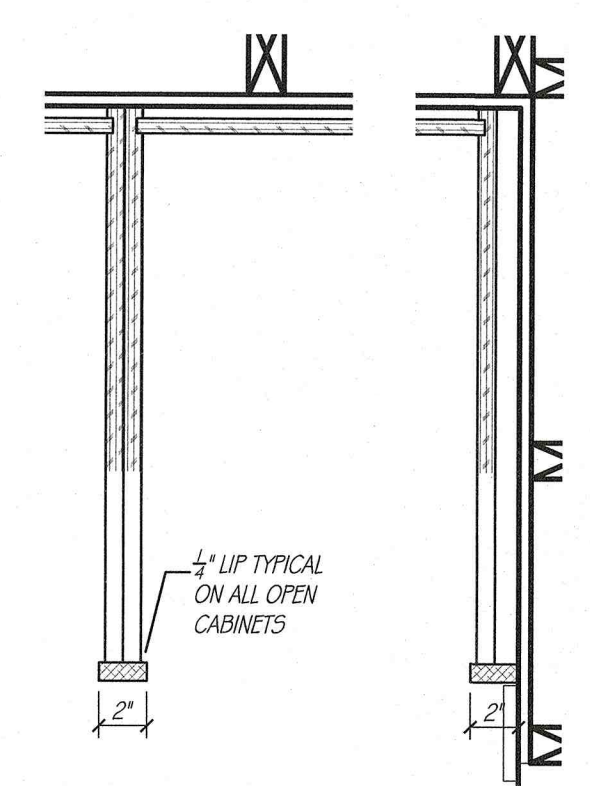

CABINET DETAIL
SCALE: 1 1/2" = 1'-0"

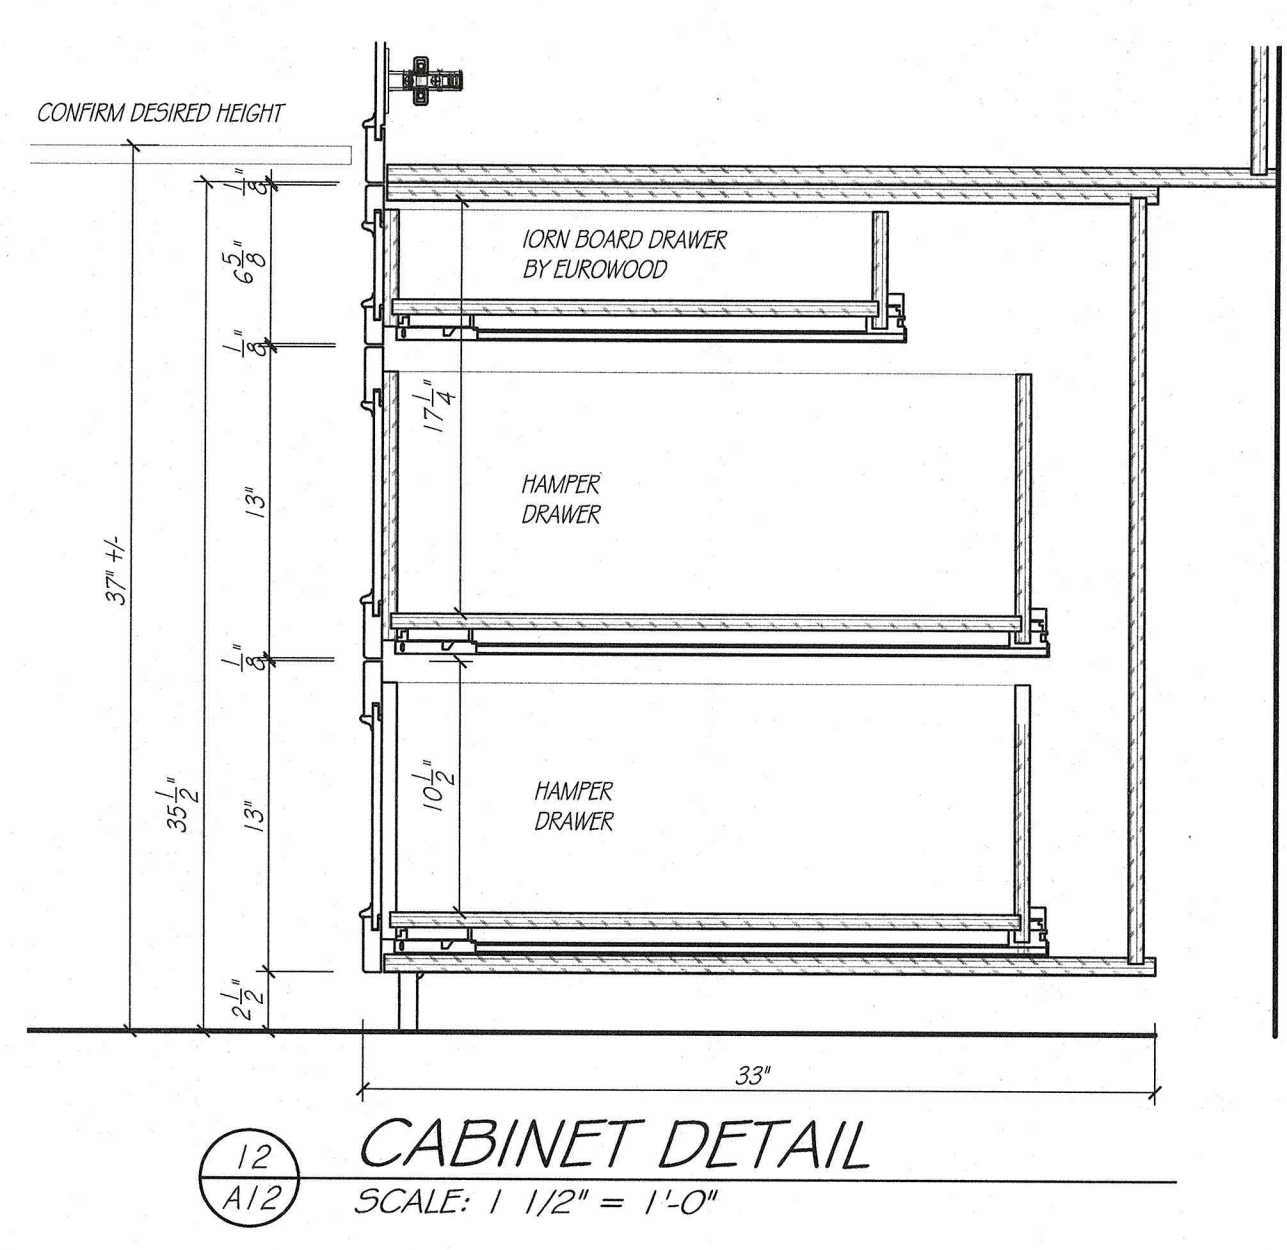


CABINET DETAIL
SCALE: 1 1/2" = 1'-0"

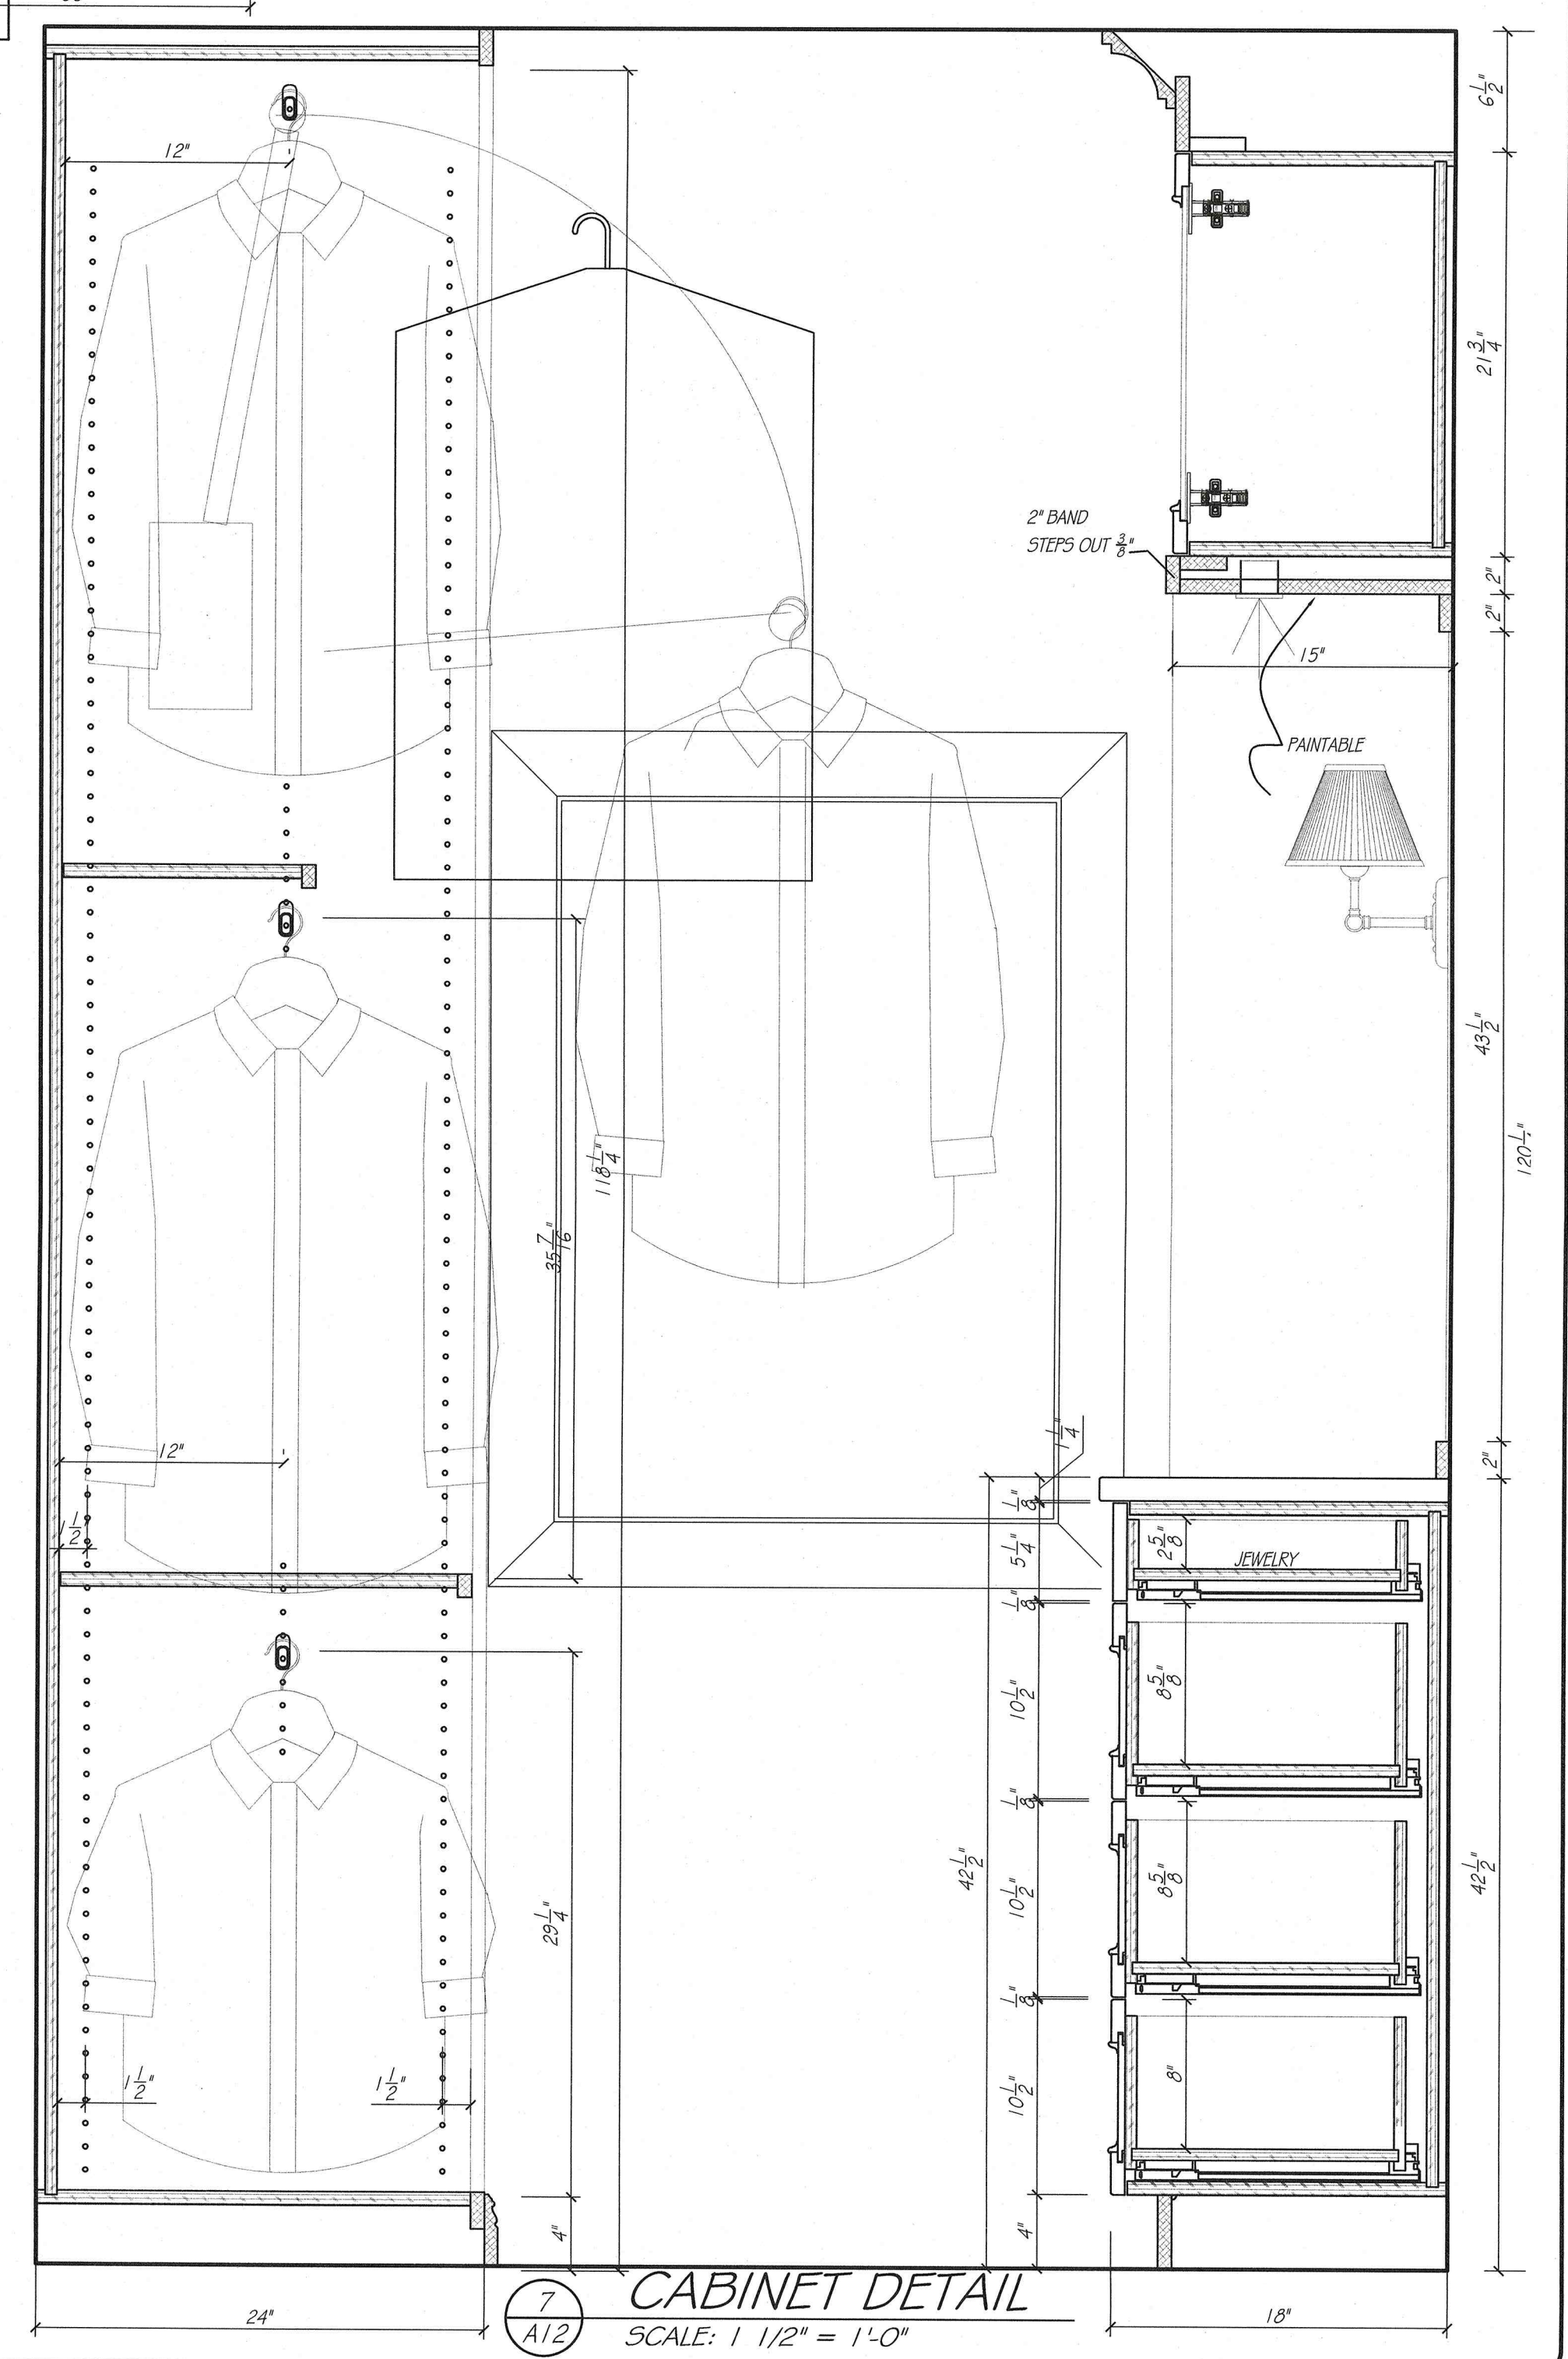

CABINET DETAIL
SCALE: 1 1/2" = 1'-0"

PHIL & MICHELLE WOOD
3435 N. 140TH. CIRCLE
OMAHA, NE 68164

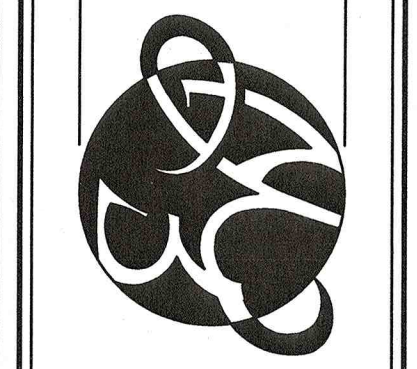

APPROVED BY:

SIGNATURE

DATE

WOOD

5588

DUPLICATION OF THESE DRAWINGS IS PROHIBITED WITHOUT WRITTEN CONSENT BY EUROWOOD CABINETS ©2000, EUROWOOD CABINETS INC. MEASUREMENTS ARE SUBJECT TO CHANGE DUE TO FINAL FIELD MEASUREMENTS.