

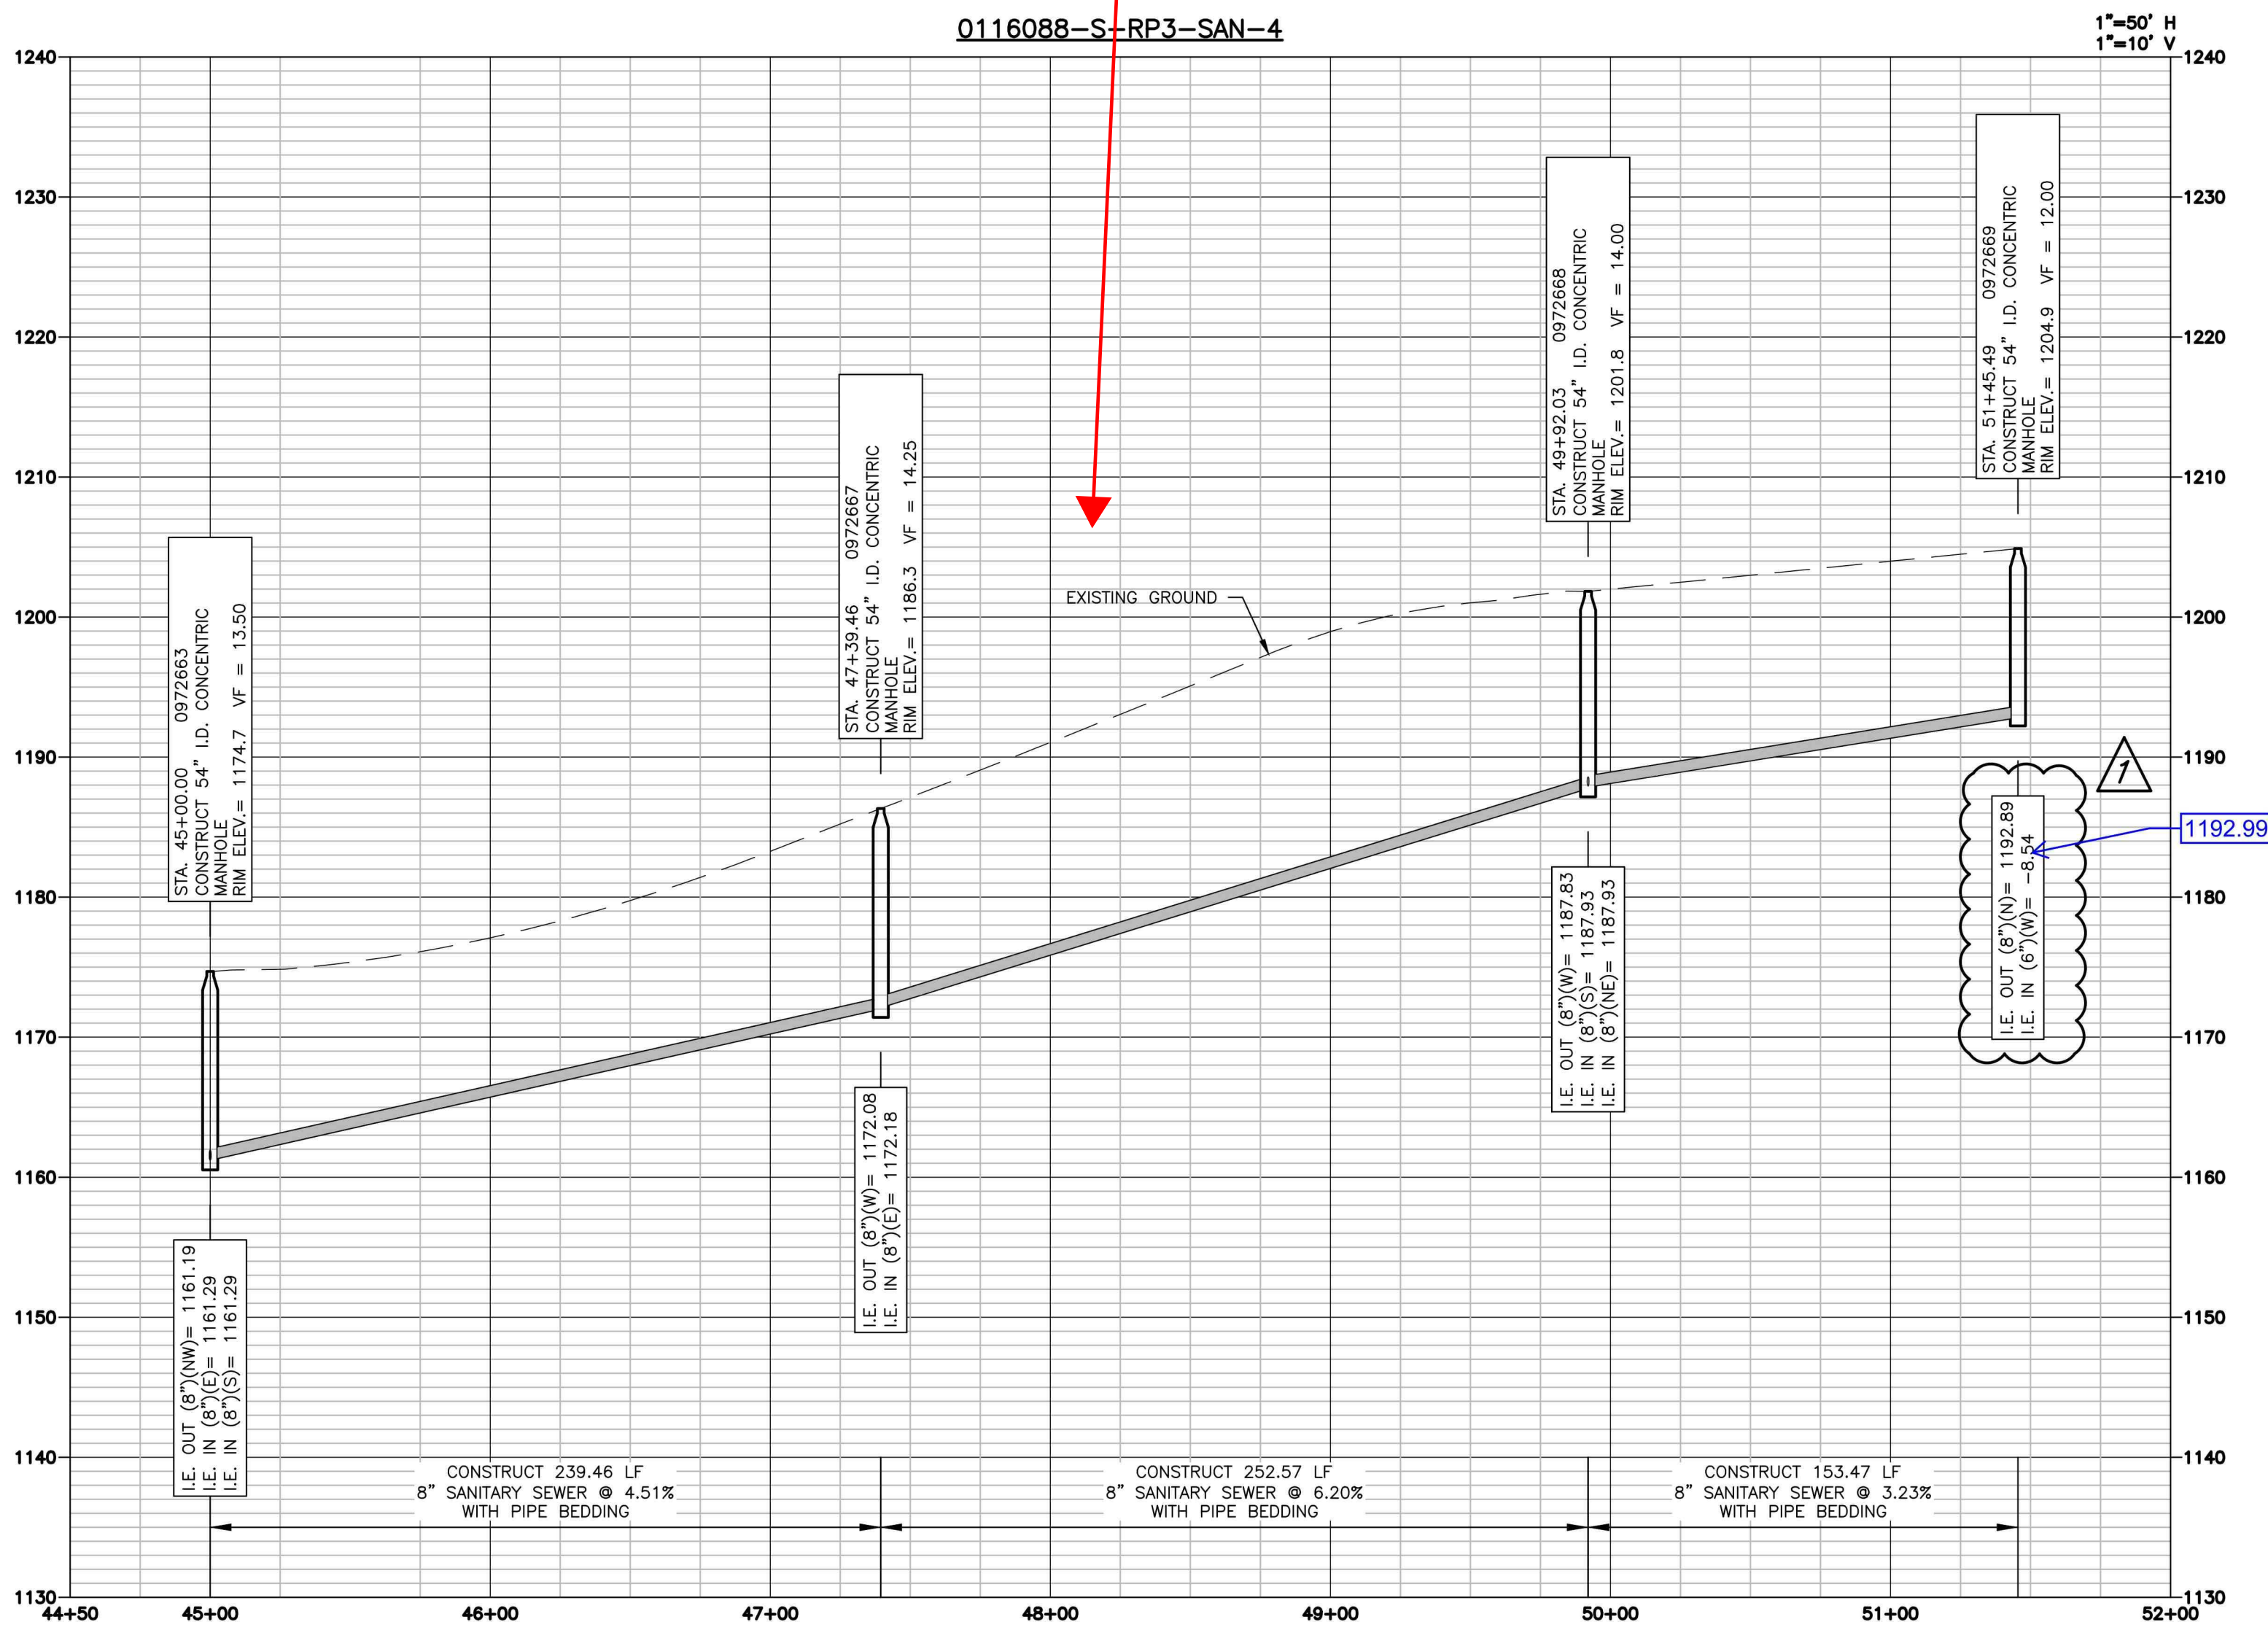


L:\Engineering\0116088 West Form South Form\DRAWINGS\CONSTRUCTION, DRAINAGE\151ST AVENUE - RP3-SAN-4.dwg, 10/14/2020 10:40:26 AM, RICK J. KELLER, LAMP RYNEARSON

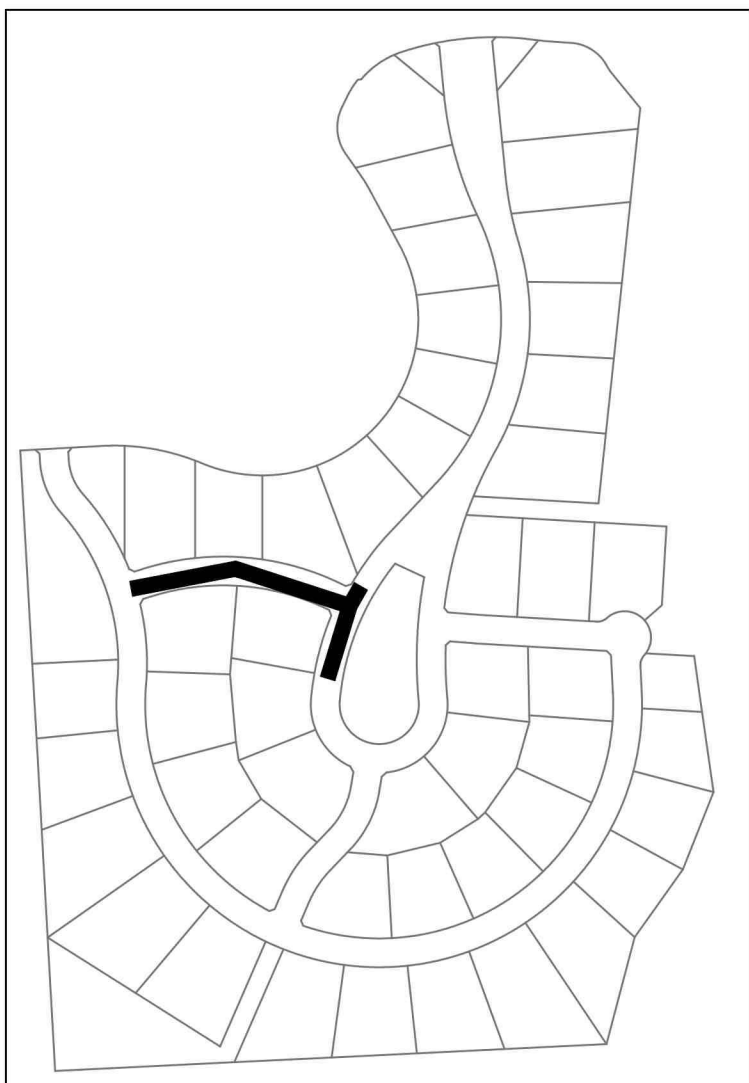

THESE RECORD DRAWINGS HAVE BEEN PREPARED BASED ON INFORMATION SUBMITTED, IN PART, BY OTHERS, WHILE THIS INFORMATION IS BELIEVED TO BE RELIABLE, THE ENGINEER IS NOT RESPONSIBLE FOR ITS ACCURACY, NOR FOR ERRORS OR OMISSIONS WHICH MAY HAVE BEEN INCORPORATED INTO THIS DOCUMENT AS A RESULT.


NOTE:
TO CONVERT TO CITY OF OMAHA
DATUM SUBTRACT 962.04

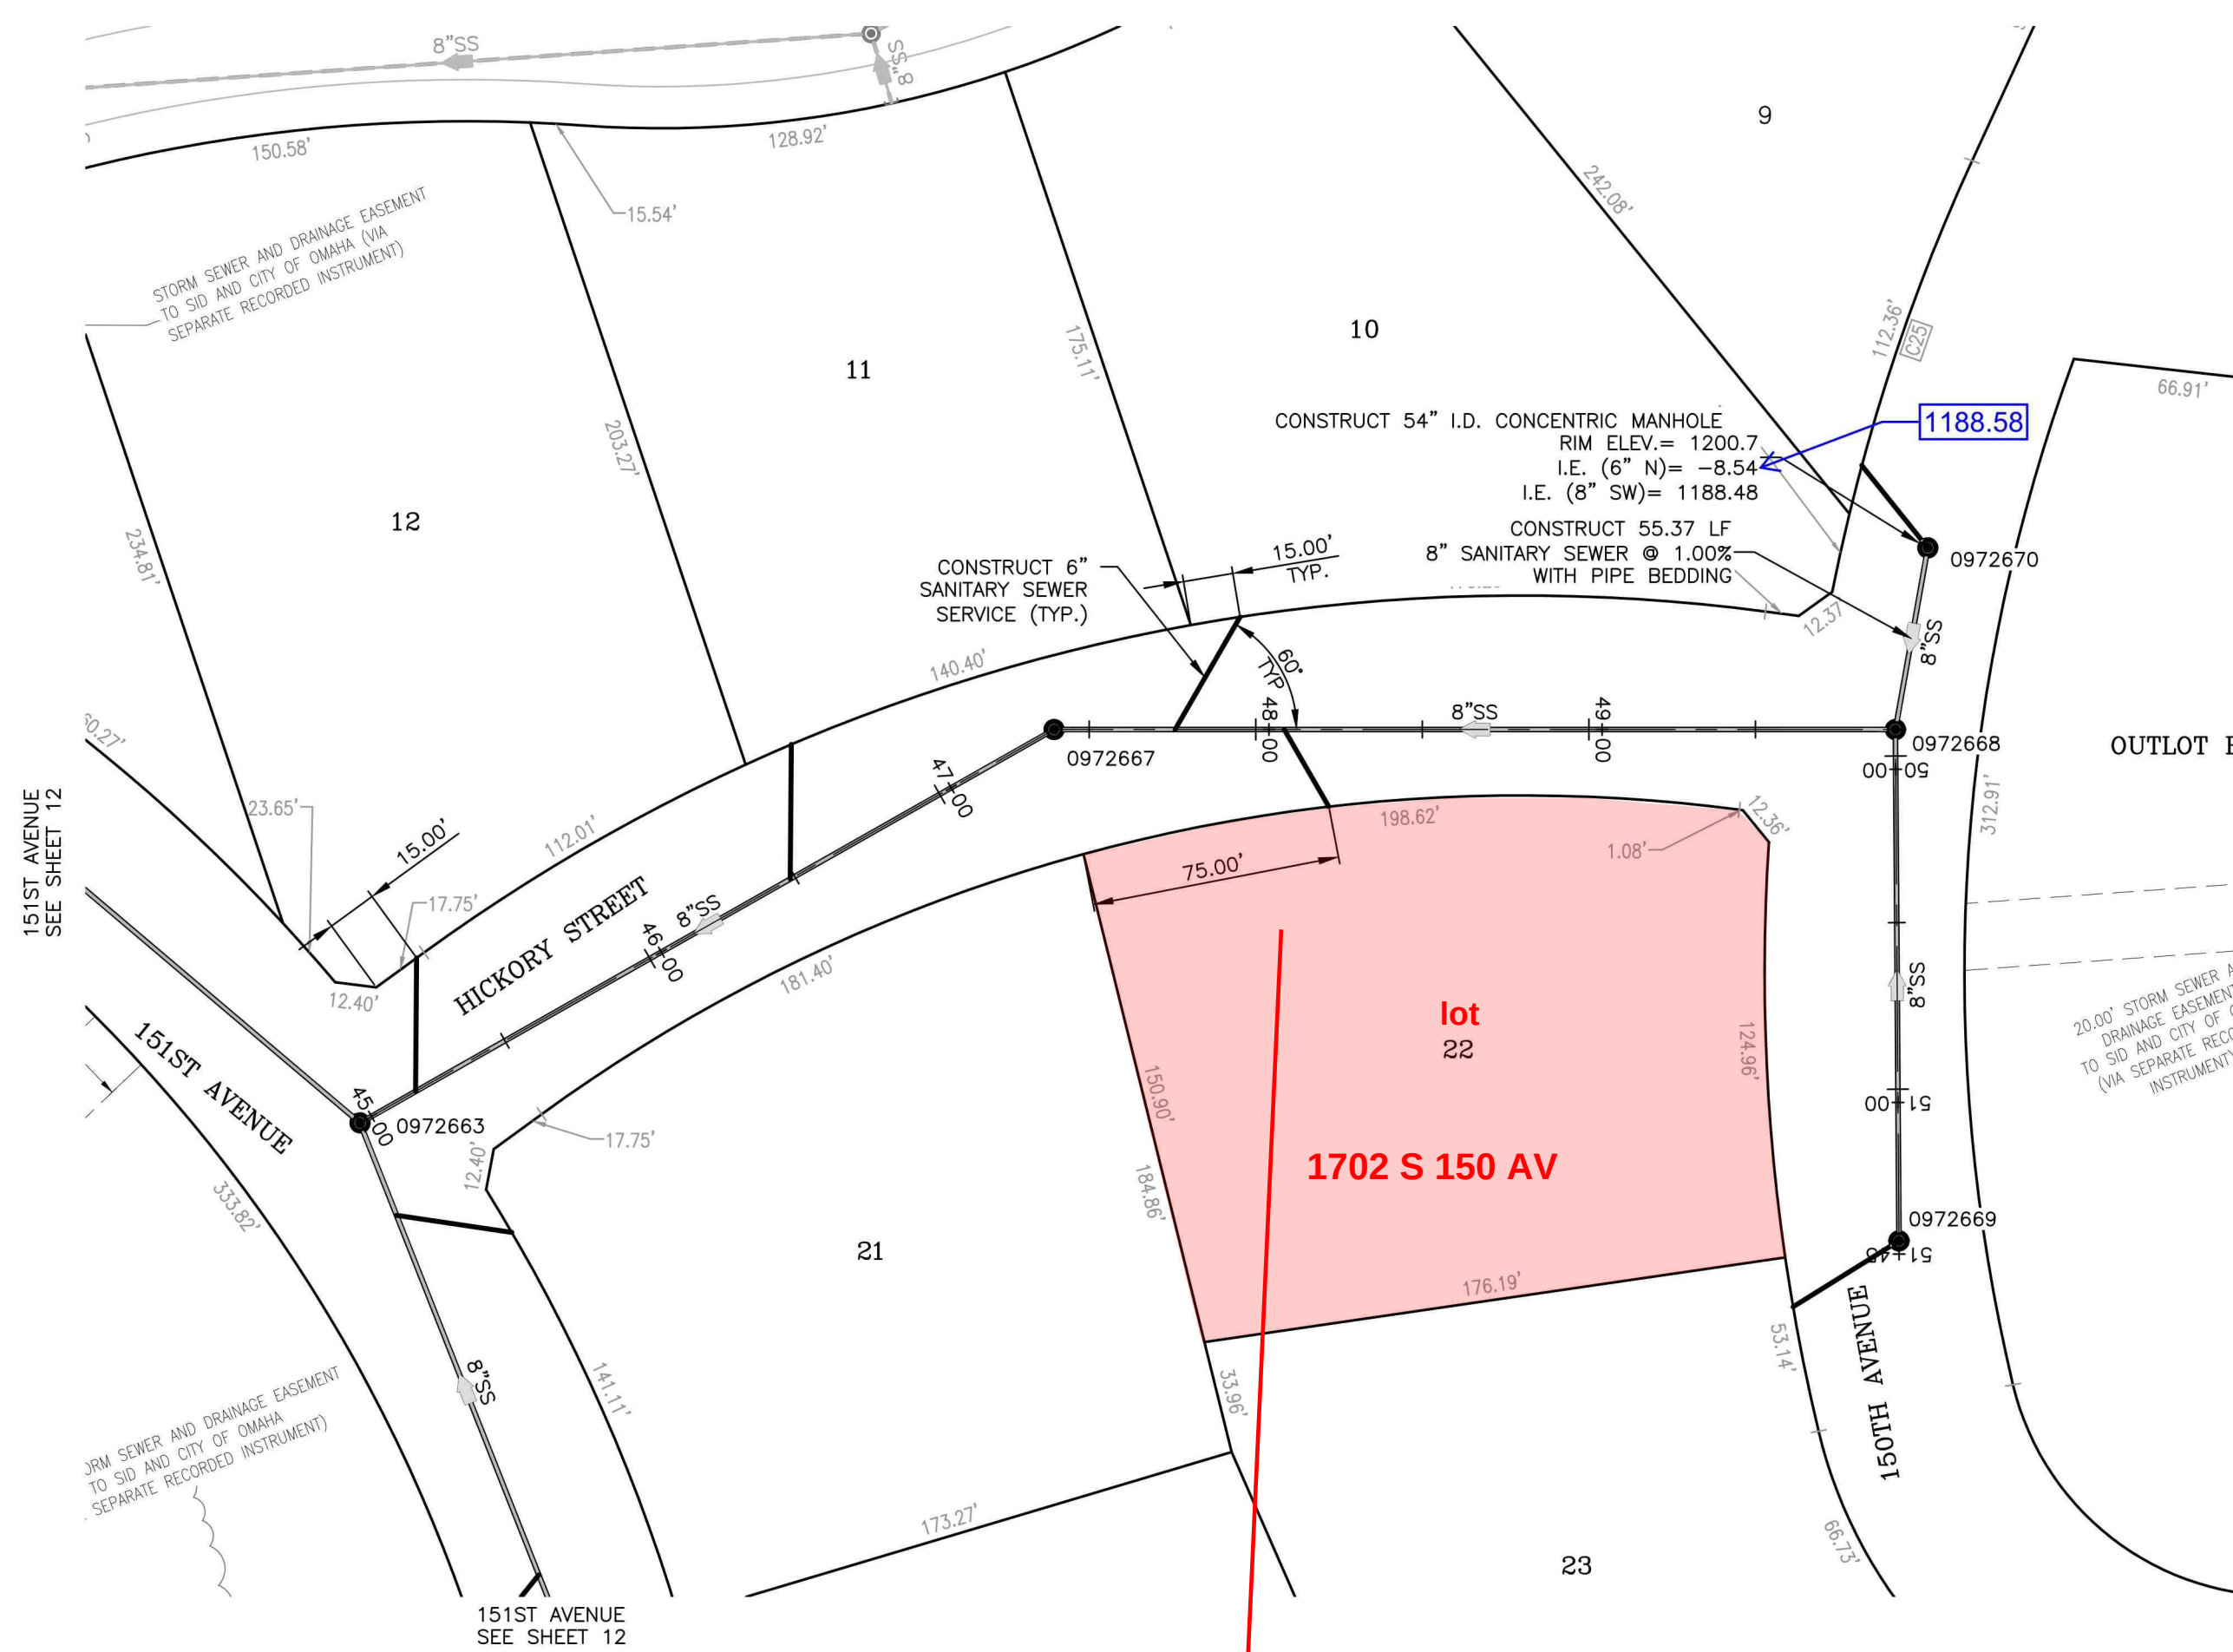

LOCATION MAP

LAMP
RYNEARSON

14710 W. DODGE RD, STE. 100
OMAHA, NE 68154
402.496.2498
LampRynearson.com

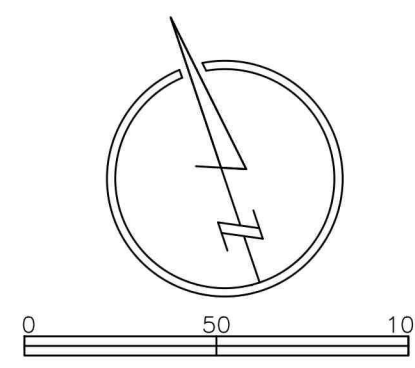

JOSEPH T. FLAXBEARD
E14004

SANITARY SEWER
PLAN AND PROFILE
HICKORY STREET/150TH AVENUE [S-RP3-SAN-4]

SANITARY AND IMPROVEMENTS DISTRICT NO. 584 DOGLAS COUNTY, NE
SANITARY SEWER AND STORM SEWER, SECTION 1, (HEARTWOOD ESTATES)



ALL UTILITIES ARE SHOWN BASED ON THE INFORMATION AVAILABLE TO THE ENGINEER. THERE IS NO GUARANTEE ALL UTILITIES ARE SHOWN OR THAT THE LOCATION, DEPTH, AND SIZE OF EACH FACILITY IS CORRECT. THE CONTRACTOR IS RESPONSIBLE FOR LOCATING ALL UTILITIES AND MARKING LINES PRIOR TO CONSTRUCTION.

REVISIONS

1. RJK 10-14-2020

DESIGNER / DRAFTER

MAJOR MARTINEZ/RICK KELLER

DATE

10-07-2020

PROJECT NUMBER

0116088-33-030/040

BOOK AND PAGE

SHEET

13 OF 18

CONSTRUCTION RECORD DRAWINGS